


PARENT PARCEL: 07-00-004-600-001

CHILD PARCEL: DROP FROM DUP.


STARTING POINT:

18-03838-C

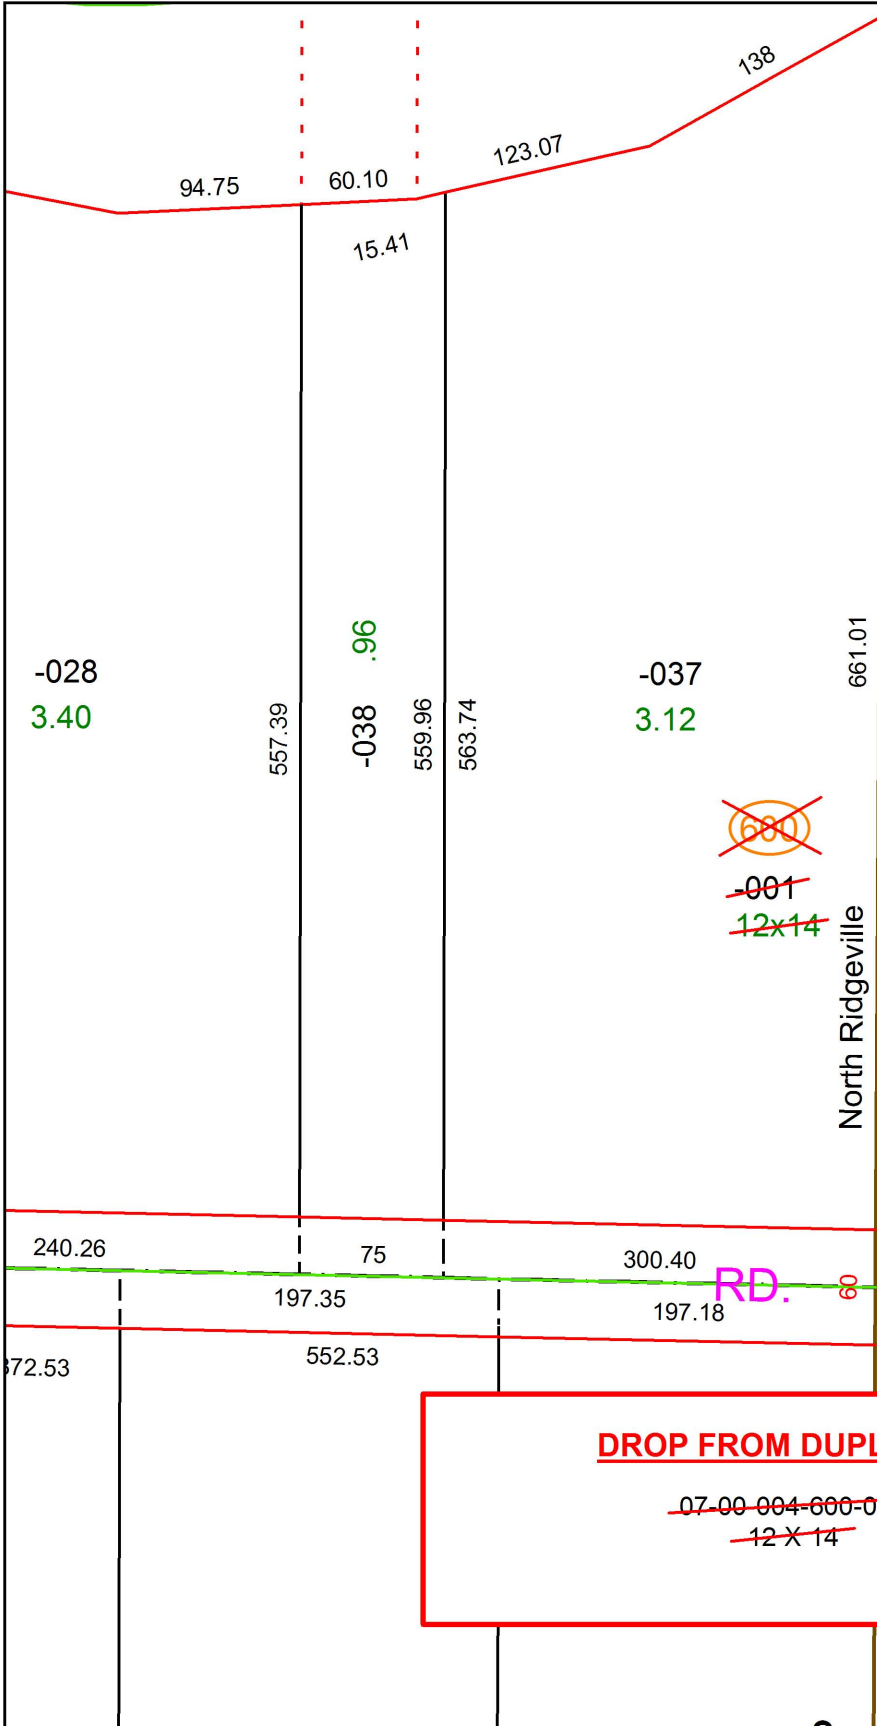

DROP FROM DUPLICATE

~~07-00-004-600-001~~
~~12 X 14~~

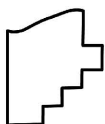

SPLITS/DEEDS PROCESSED
LORAIN COUNTY TAX MAP DEPARTMENT
226 MIDDLE AVE. ELYRIA, OH

SURVEYED BY:	N/A
CLOSURE:	N/A
MAP PAGE(S):	7-00-004
APPROVED BY:	RRM DATE: 2-13-18
SCALE:	1" = 100
PRIOR INSTRUMENT:	N/A