
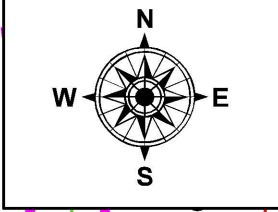


PARENT PARCEL: 02-01-003-173-037

CHILD PARCEL: 02-01-003-173-038, -039


STARTING POINT: S/L 4 AND THE NORTHERLY 24.98 FT OF S/L 5 IN GILBERT HOGAN'S 3RD ADD.

18-03839-U

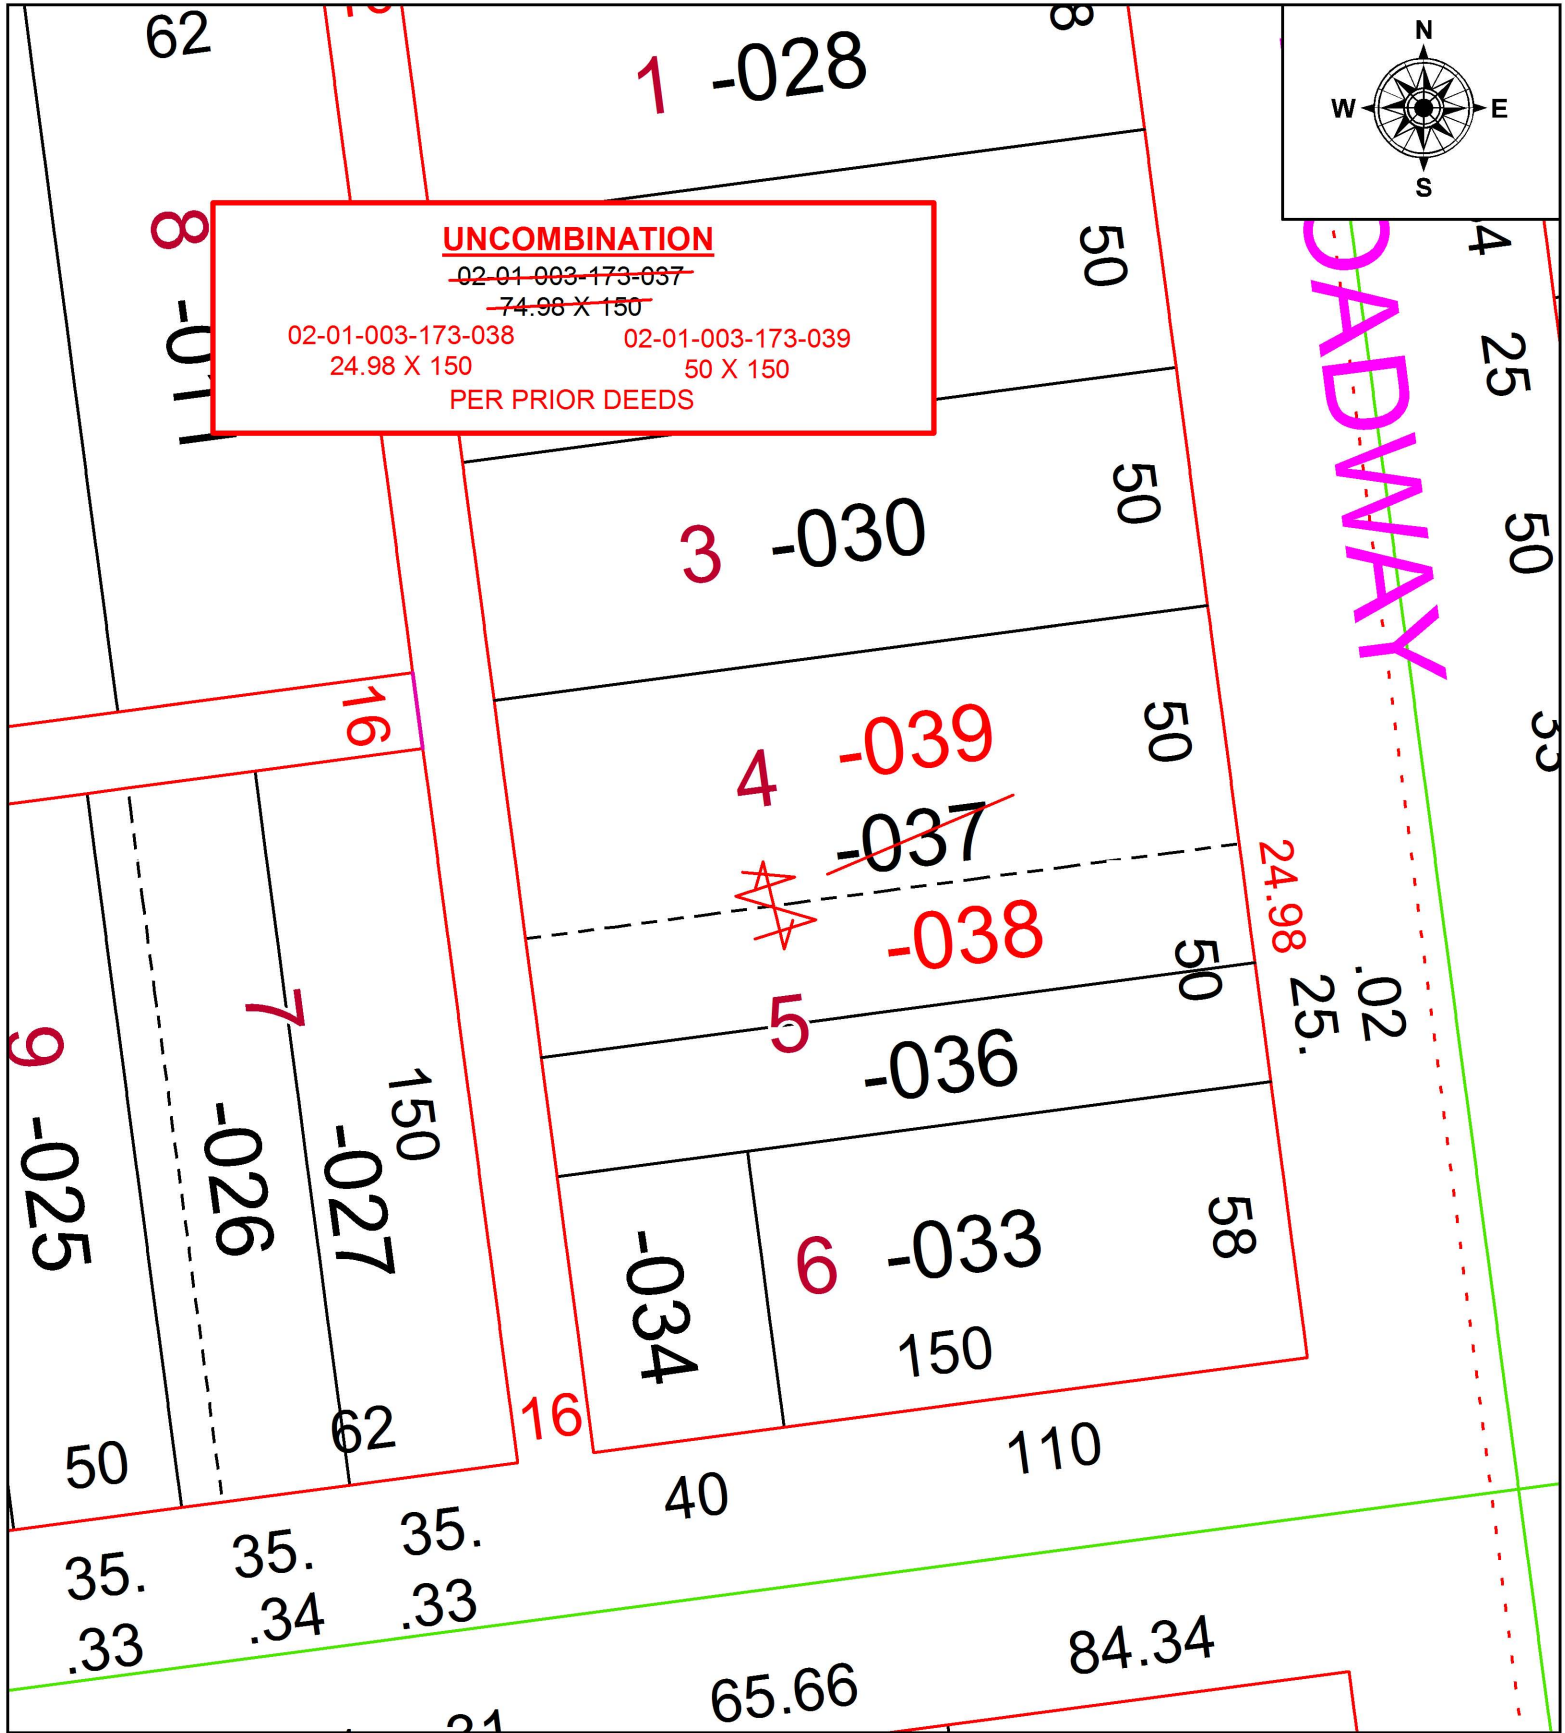

**UNCOMBINATION**  
~~02-01-003-173-037~~  
~~74.98 X 150~~  
 02-01-003-173-038      02-01-003-173-039  
 24.98 X 150                      50 X 150  
 PER PRIOR DEEDS

DADWAY

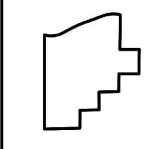

**SPLITS/DEEDS PROCESSED**  
 LORAIN COUNTY TAX MAP DEPARTMENT  
 226 MIDDLE AVE. ELYRIA, OH

SURVEYED BY: \_\_\_\_\_ N/A  
 CLOSURE: \_\_\_\_\_ N/A  
 MAP PAGE(S): \_\_\_\_\_ 2-01-003  
 APPROVED BY: \_\_\_\_\_ RRM      DATE: \_\_\_\_\_ 2-13-18  
 SCALE: \_\_\_\_\_ 1" = 40      PRIOR INSTRUMENT: \_\_\_\_\_ 20150567282