
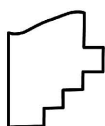
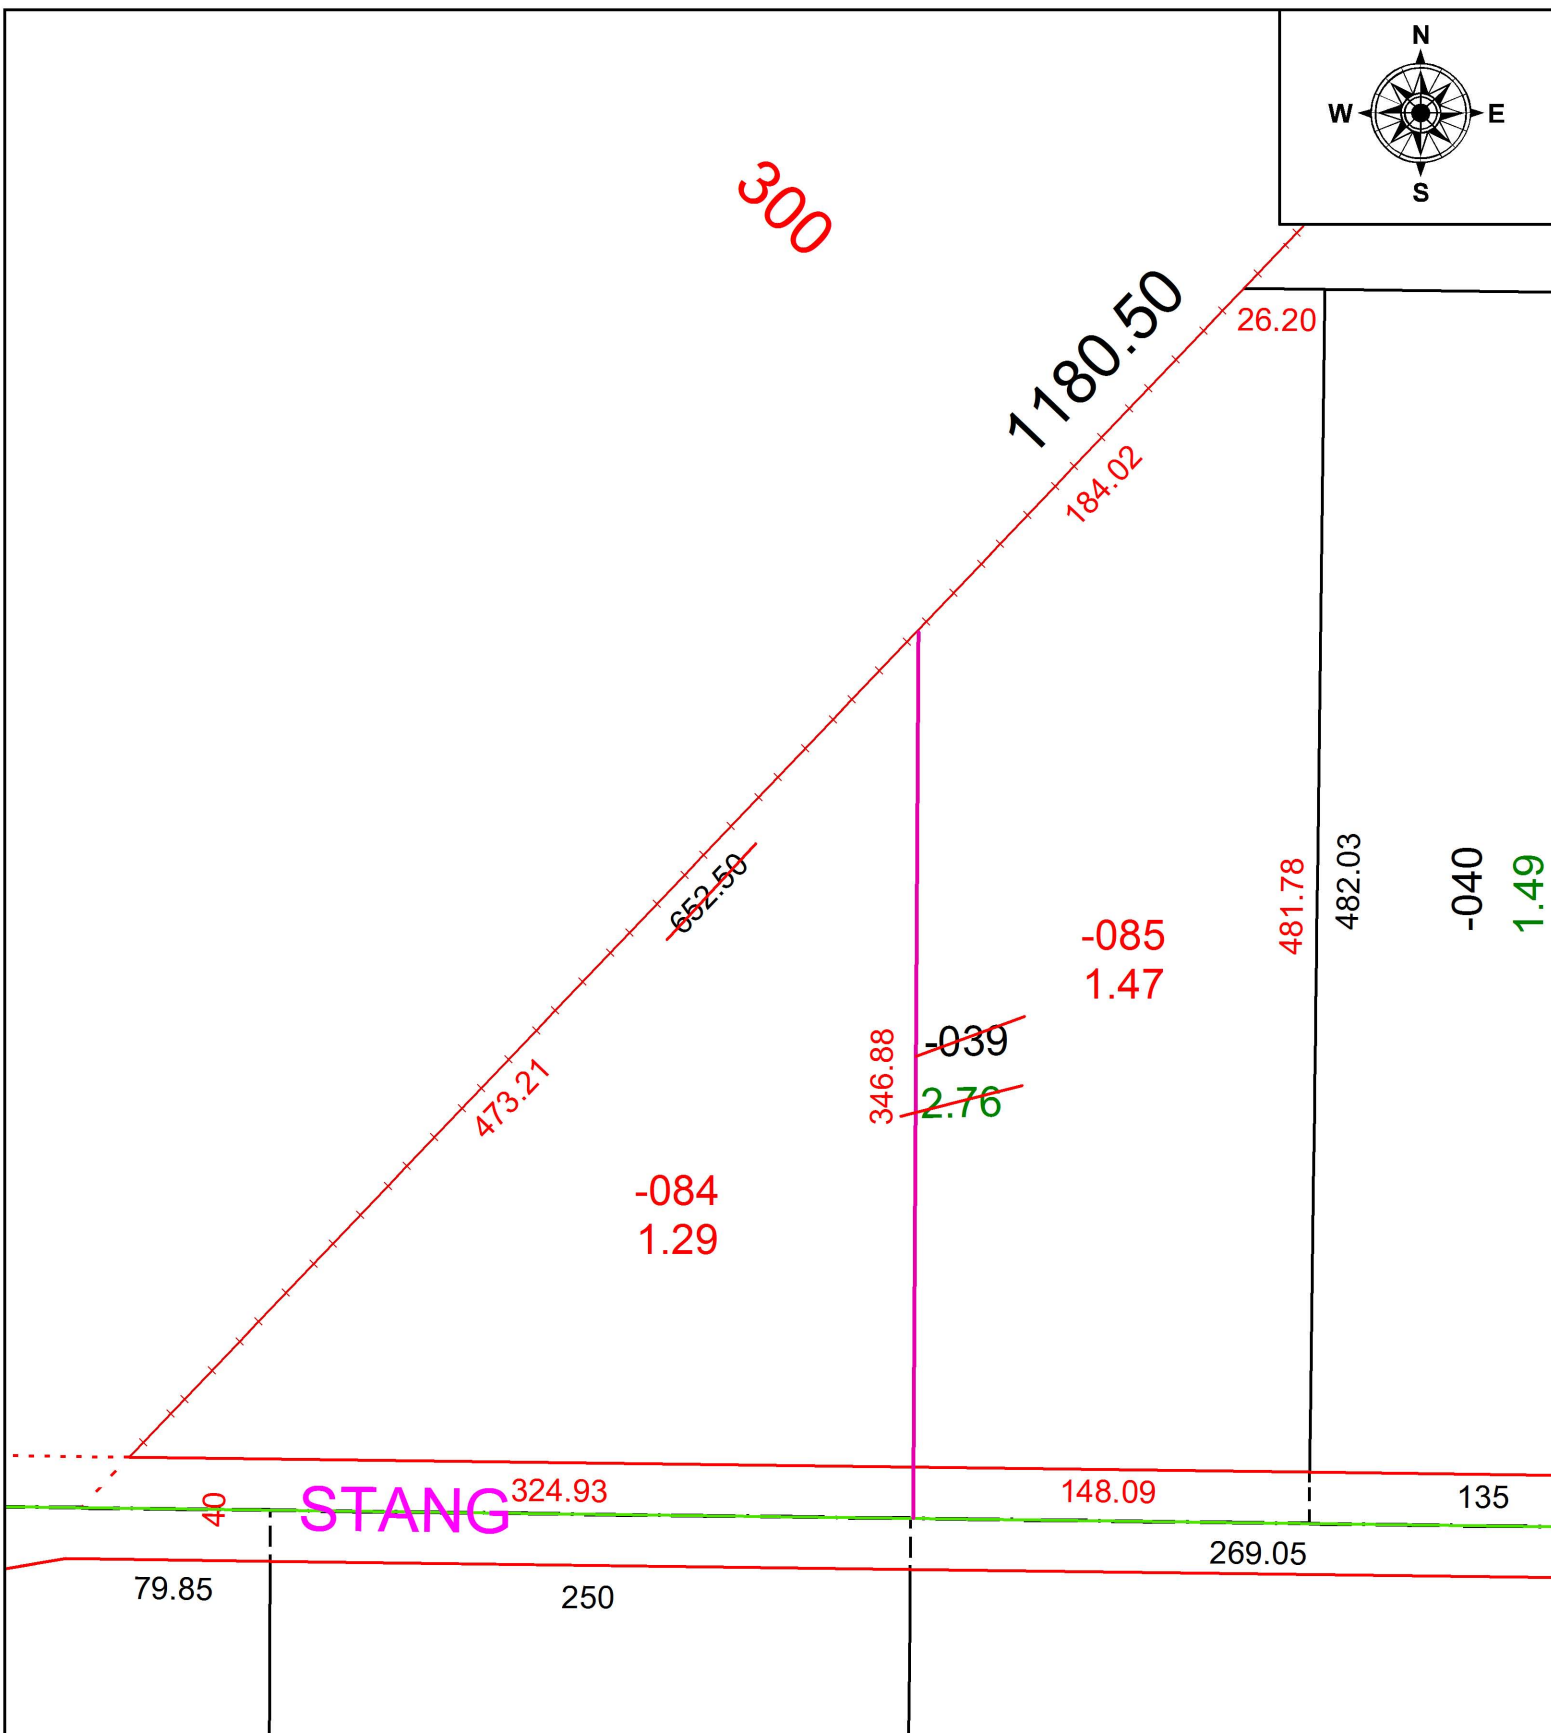


PARENT PARCEL: 05-00-064-000-039

CHILD PARCEL: 05-00-064-000-084, -085

STARTING POINT: SOUTHEAST CORNER OF O.L.64

18-03839

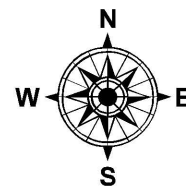

SPLITS/DEEDS PROCESSED
 LORAIN COUNTY TAX MAP DEPARTMENT
 226 MIDDLE AVE. ELYRIA, OH

SURVEYED BY: TIMOTHY D. HOZALSKI

CLOSURE: 1: 127,148

MAP PAGE(S): 5-00-064

APPROVED BY: RRM DATE: 7-25-18

SCALE: 1" = 75' PRIOR INSTRUMENT: 20180673146