


PARENT PARCEL: 08-00-103-000-038

CHILD PARCEL: 08-00-103-000-048, -049

STARTING POINT: INTERSECTION OF C/L OF BAUMHART RD. AND C/L OF RUSSIA RD.

18-03843

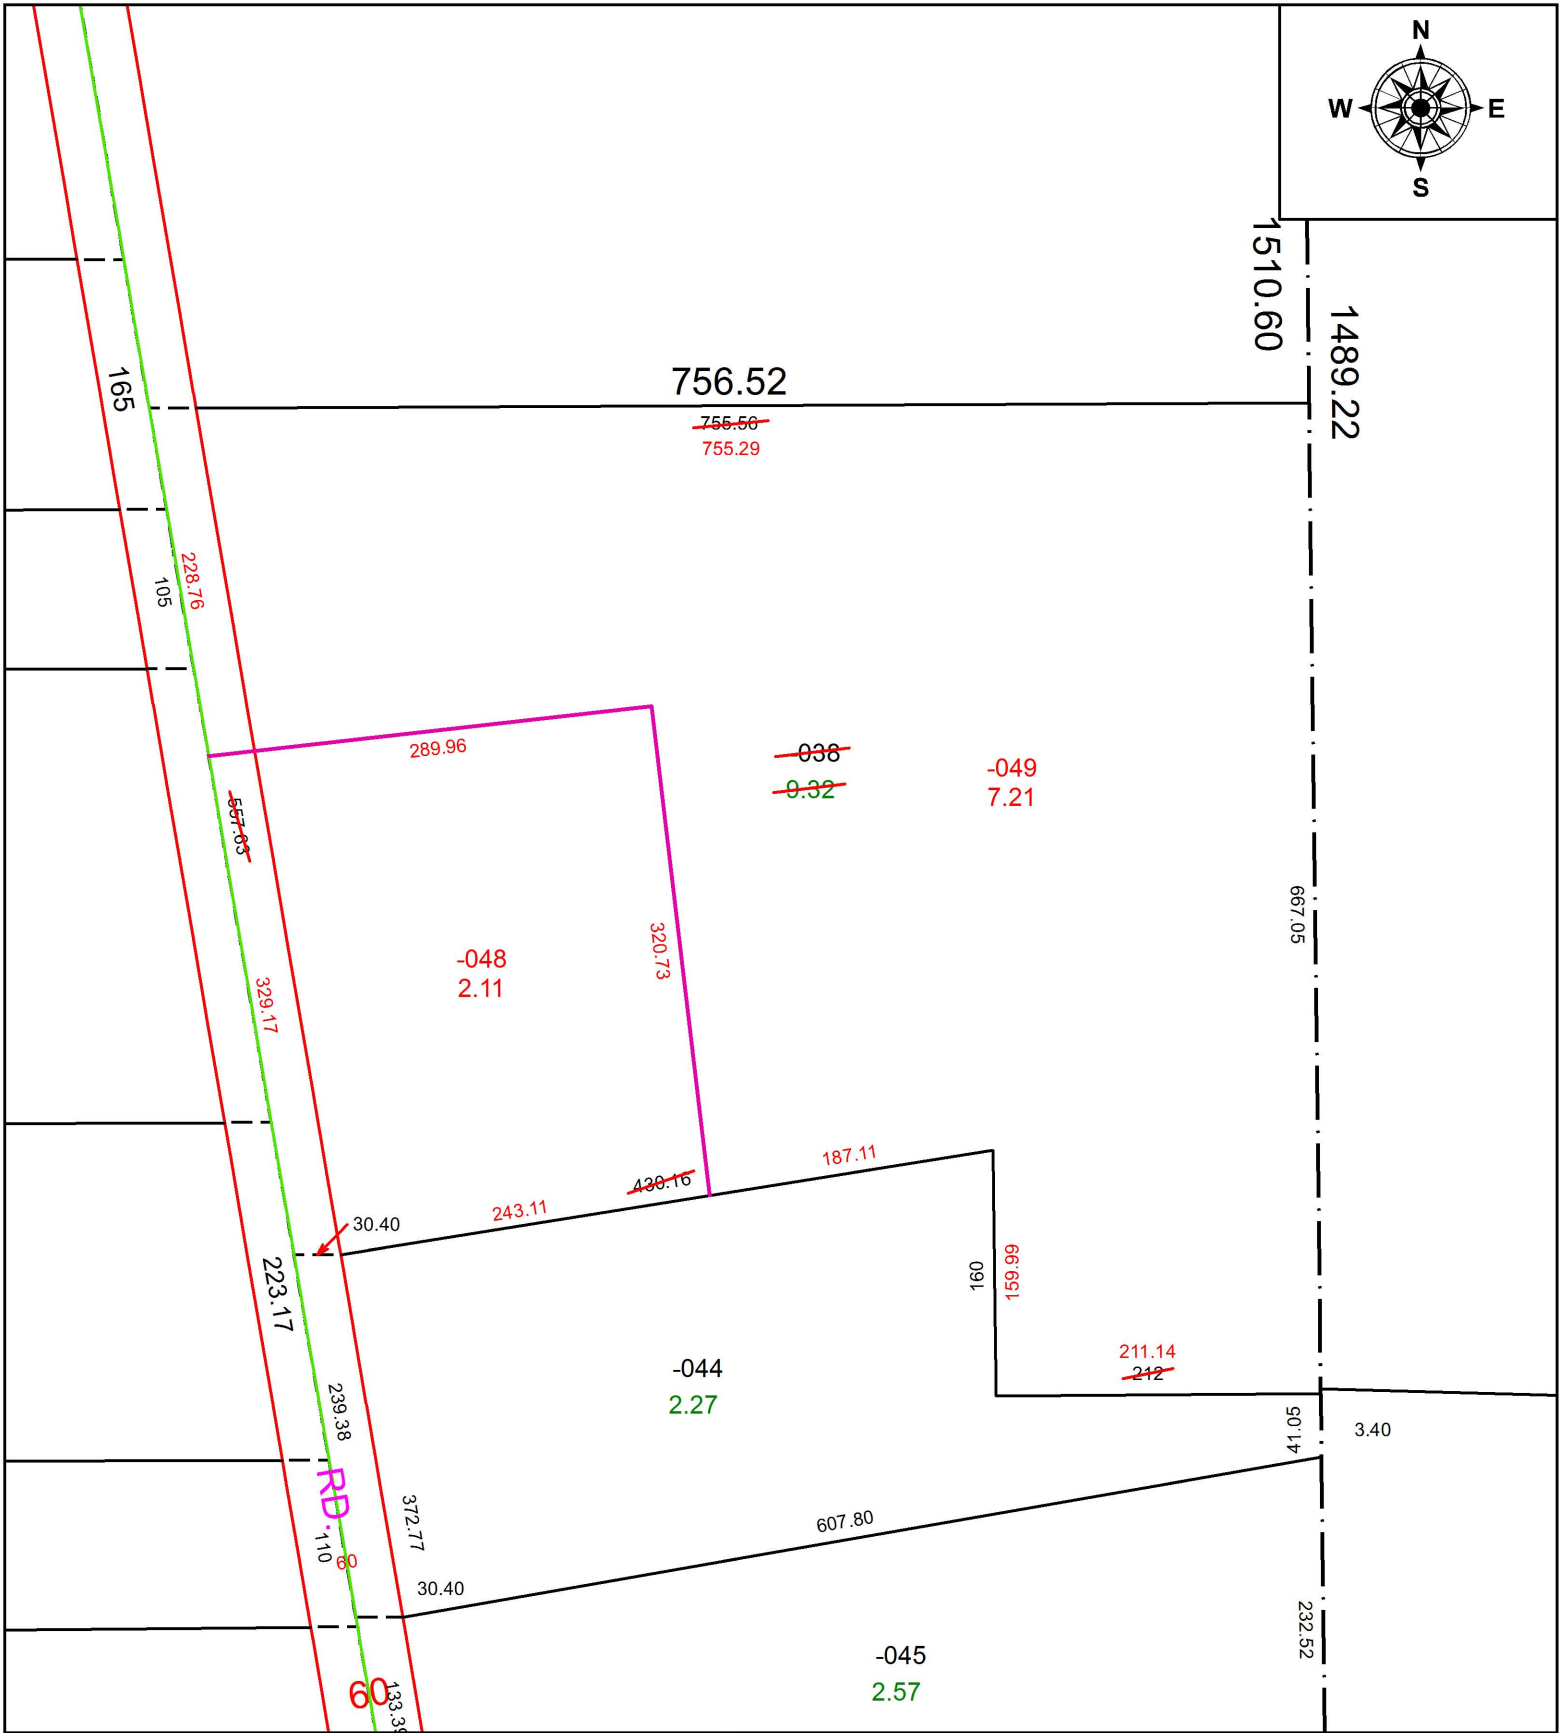

SPLITS/DEEDS PROCESSED
 LORAIN COUNTY TAX MAP DEPARTMENT
 226 MIDDLE AVE. ELYRIA, OH

SURVEYED BY: THOMAS A. SIMON

CLOSURE: 1: 407,096

MAP PAGE(S): 8-D

APPROVED BY: RRM DATE: 7-27-18

SCALE: 1" = 100 PRIOR INSTRUMENT: 20130482338