
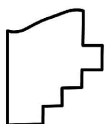


PARENT PARCEL: 11-00-045-000-036

CHILD PARCEL: 11-00-045-000-053, -054

STARTING POINT: NORTHWEST CORNER OF O.L.45

18-03853

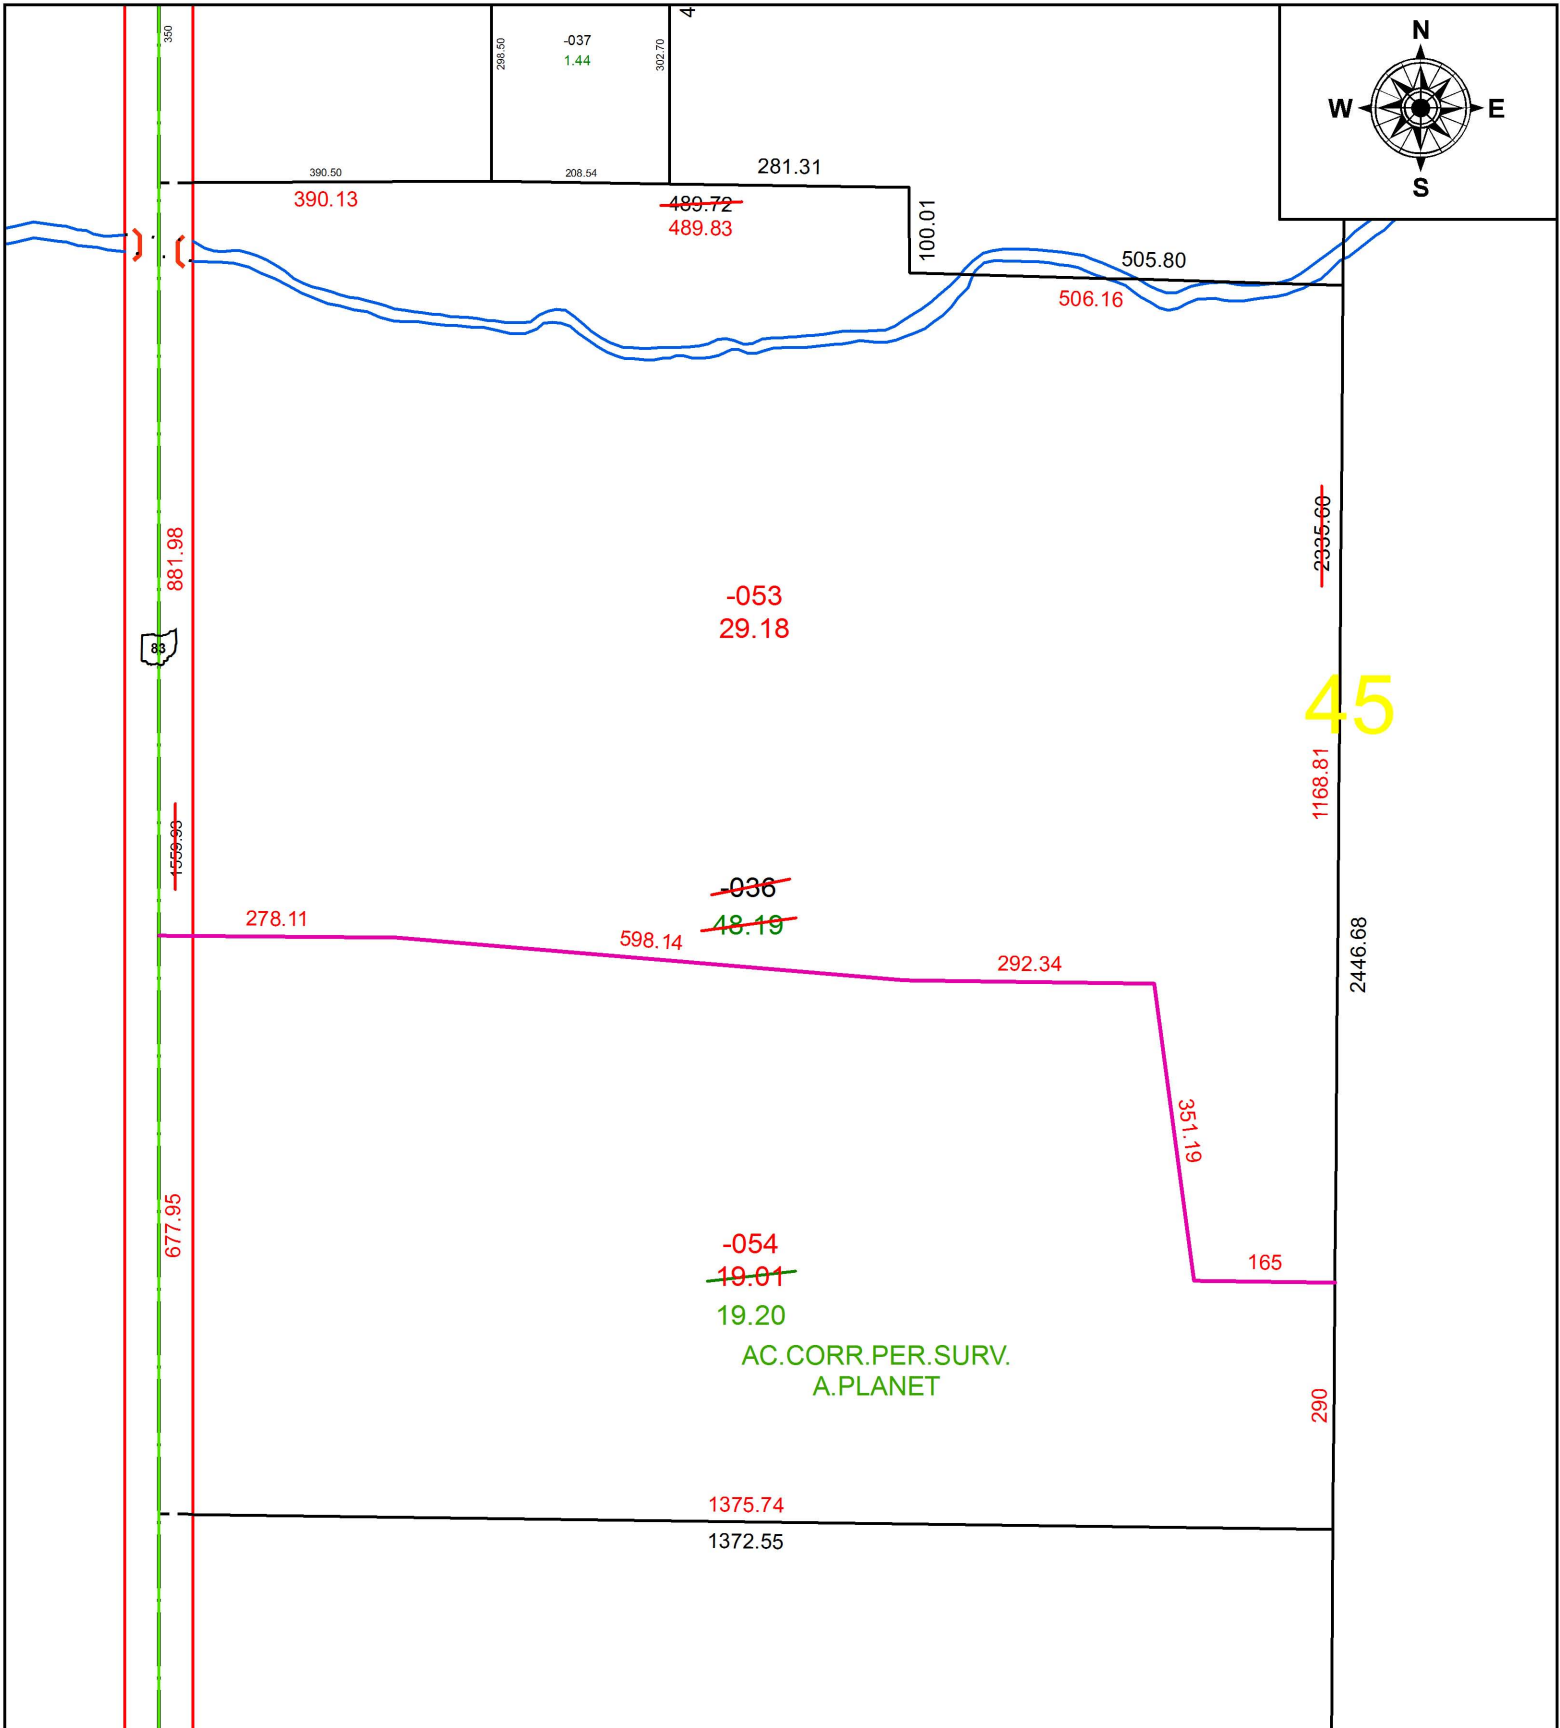

SPLITS/DEEDS PROCESSED
 LORAIN COUNTY TAX MAP DEPARTMENT
 226 MIDDLE AVE. ELYRIA, OH

SURVEYED BY: ANDREW G. PLANET

CLOSURE: 1: 2,632,652

MAP PAGE(S): 11-00-045

APPROVED BY: RRM DATE: 8-8-18

SCALE: 1" = 225 PRIOR INSTRUMENT: 20180678210