
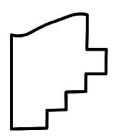
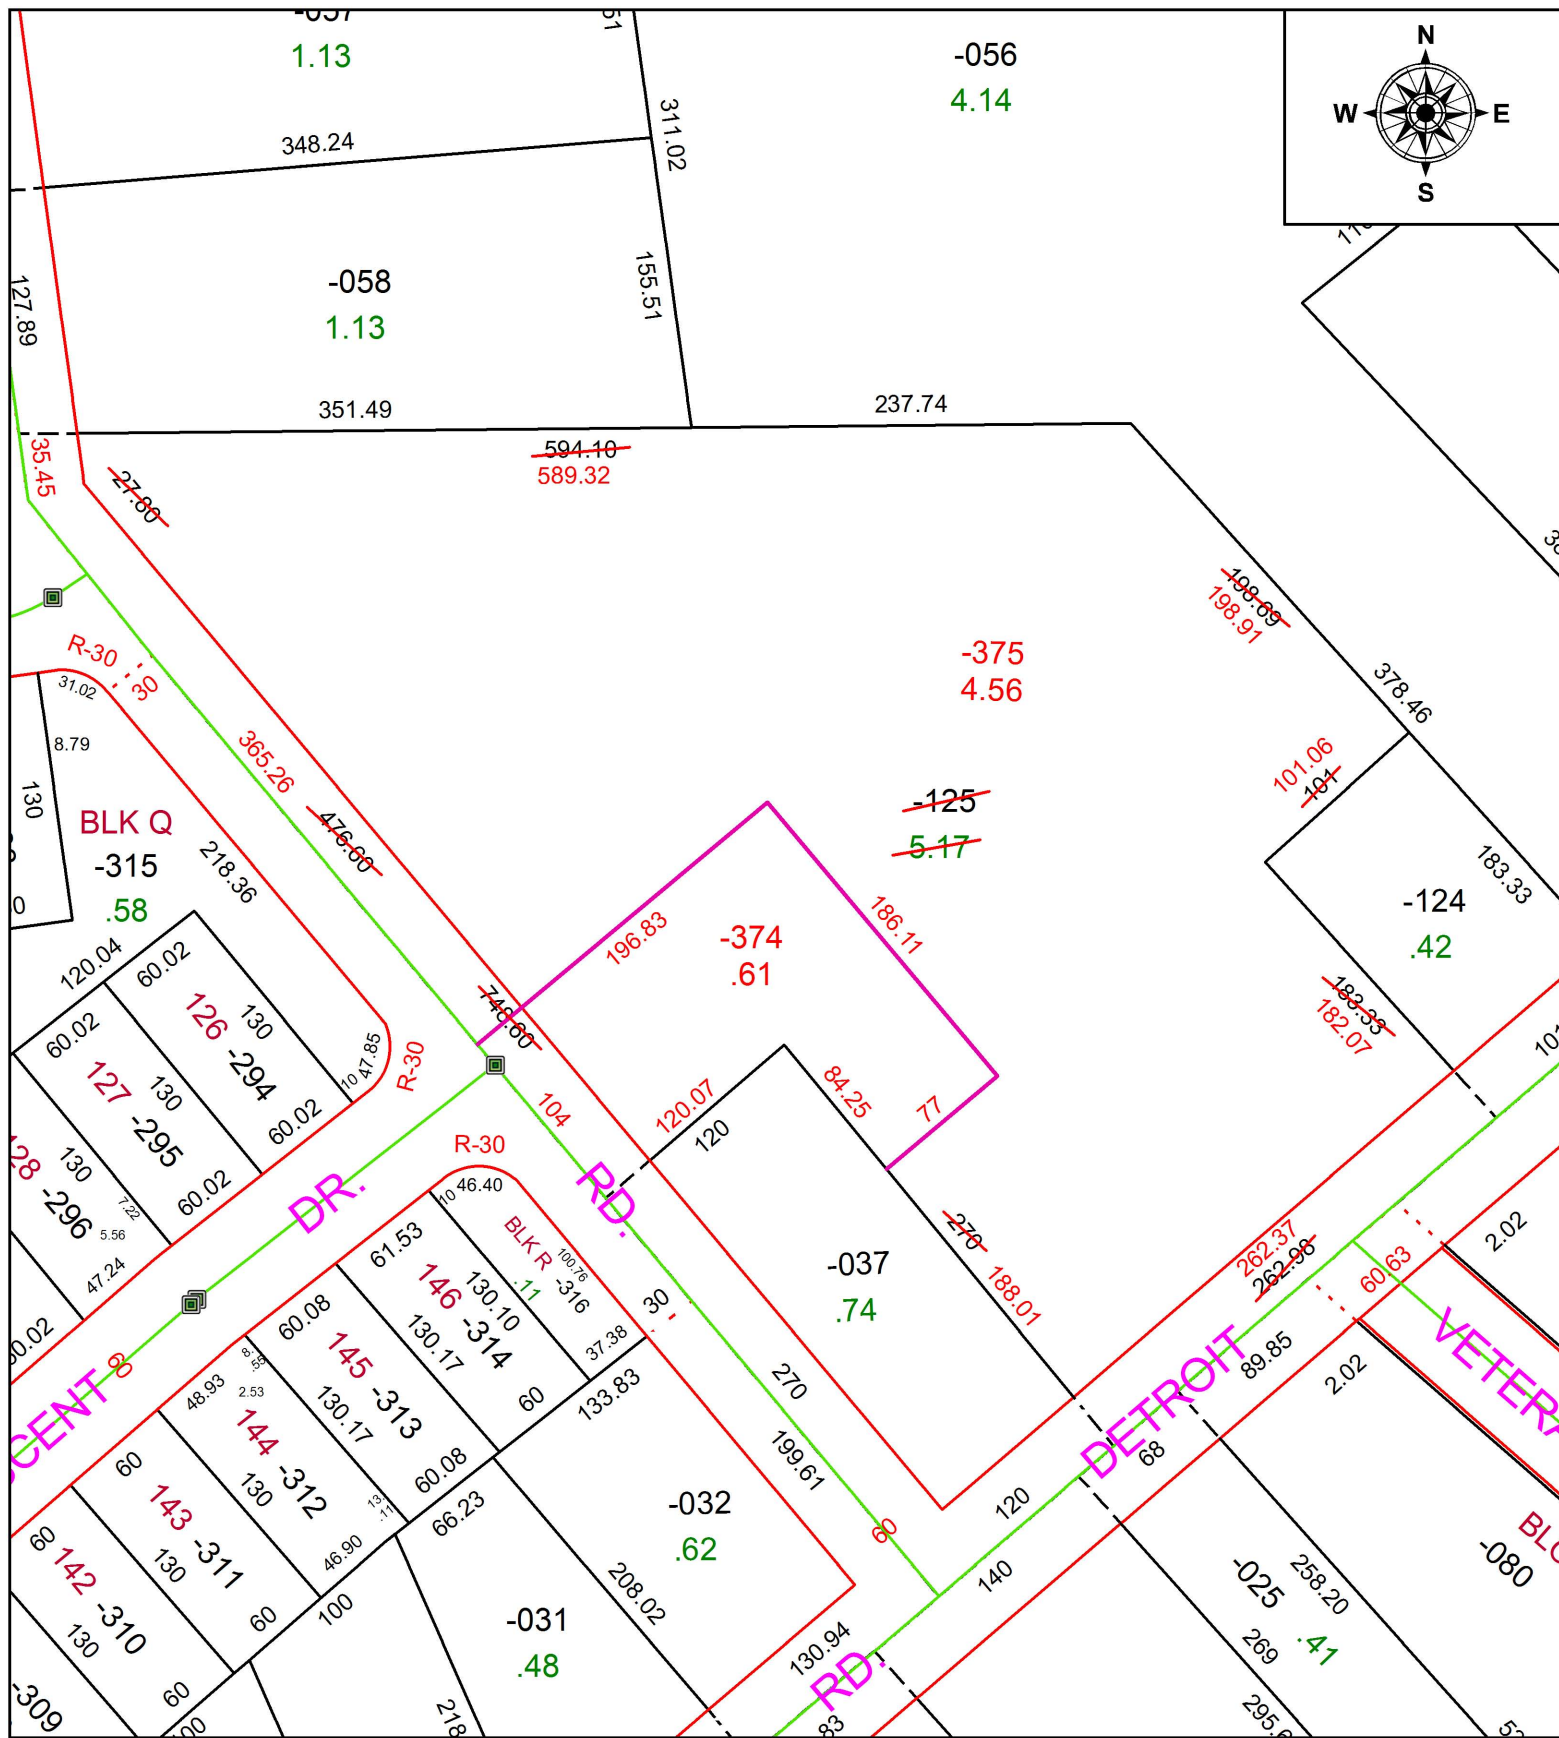


PARENT PARCEL: 04-00-002-102-125

CHILD PARCEL: 04-00-002-102-374, -375

STARTING POINT: INTERSECTION OF C/L OF S.R.254 AND C/L OF MOON RD.

18-03855

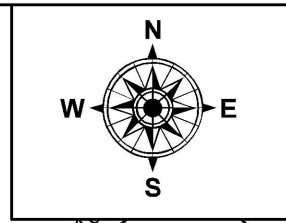

**SPLITS/DEEDS PROCESSED**  
LORAIN COUNTY TAX MAP DEPARTMENT  
226 MIDDLE AVE. ELYRIA, OH

SURVEYED BY: AMY M. KELLY  
CLOSURE: 1: 139,955  
MAP PAGE(S): 4-00-002  
APPROVED BY: RRM DATE: 8-10-18  
SCALE: 1" = 100 PRIOR INSTRUMENT: 20170614991