
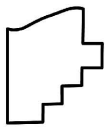


PARENT PARCEL: 03-00-107-104-044, 03-00-112-102-012, -022

CHILD PARCEL: 03-00-107-104-049, -050, 03-00-112-102-012, -020

STARTING POINT: INTERSECTION OF C/L OF ELYRIA AVE. AND C/L OF DUNTON RD.

18-03858

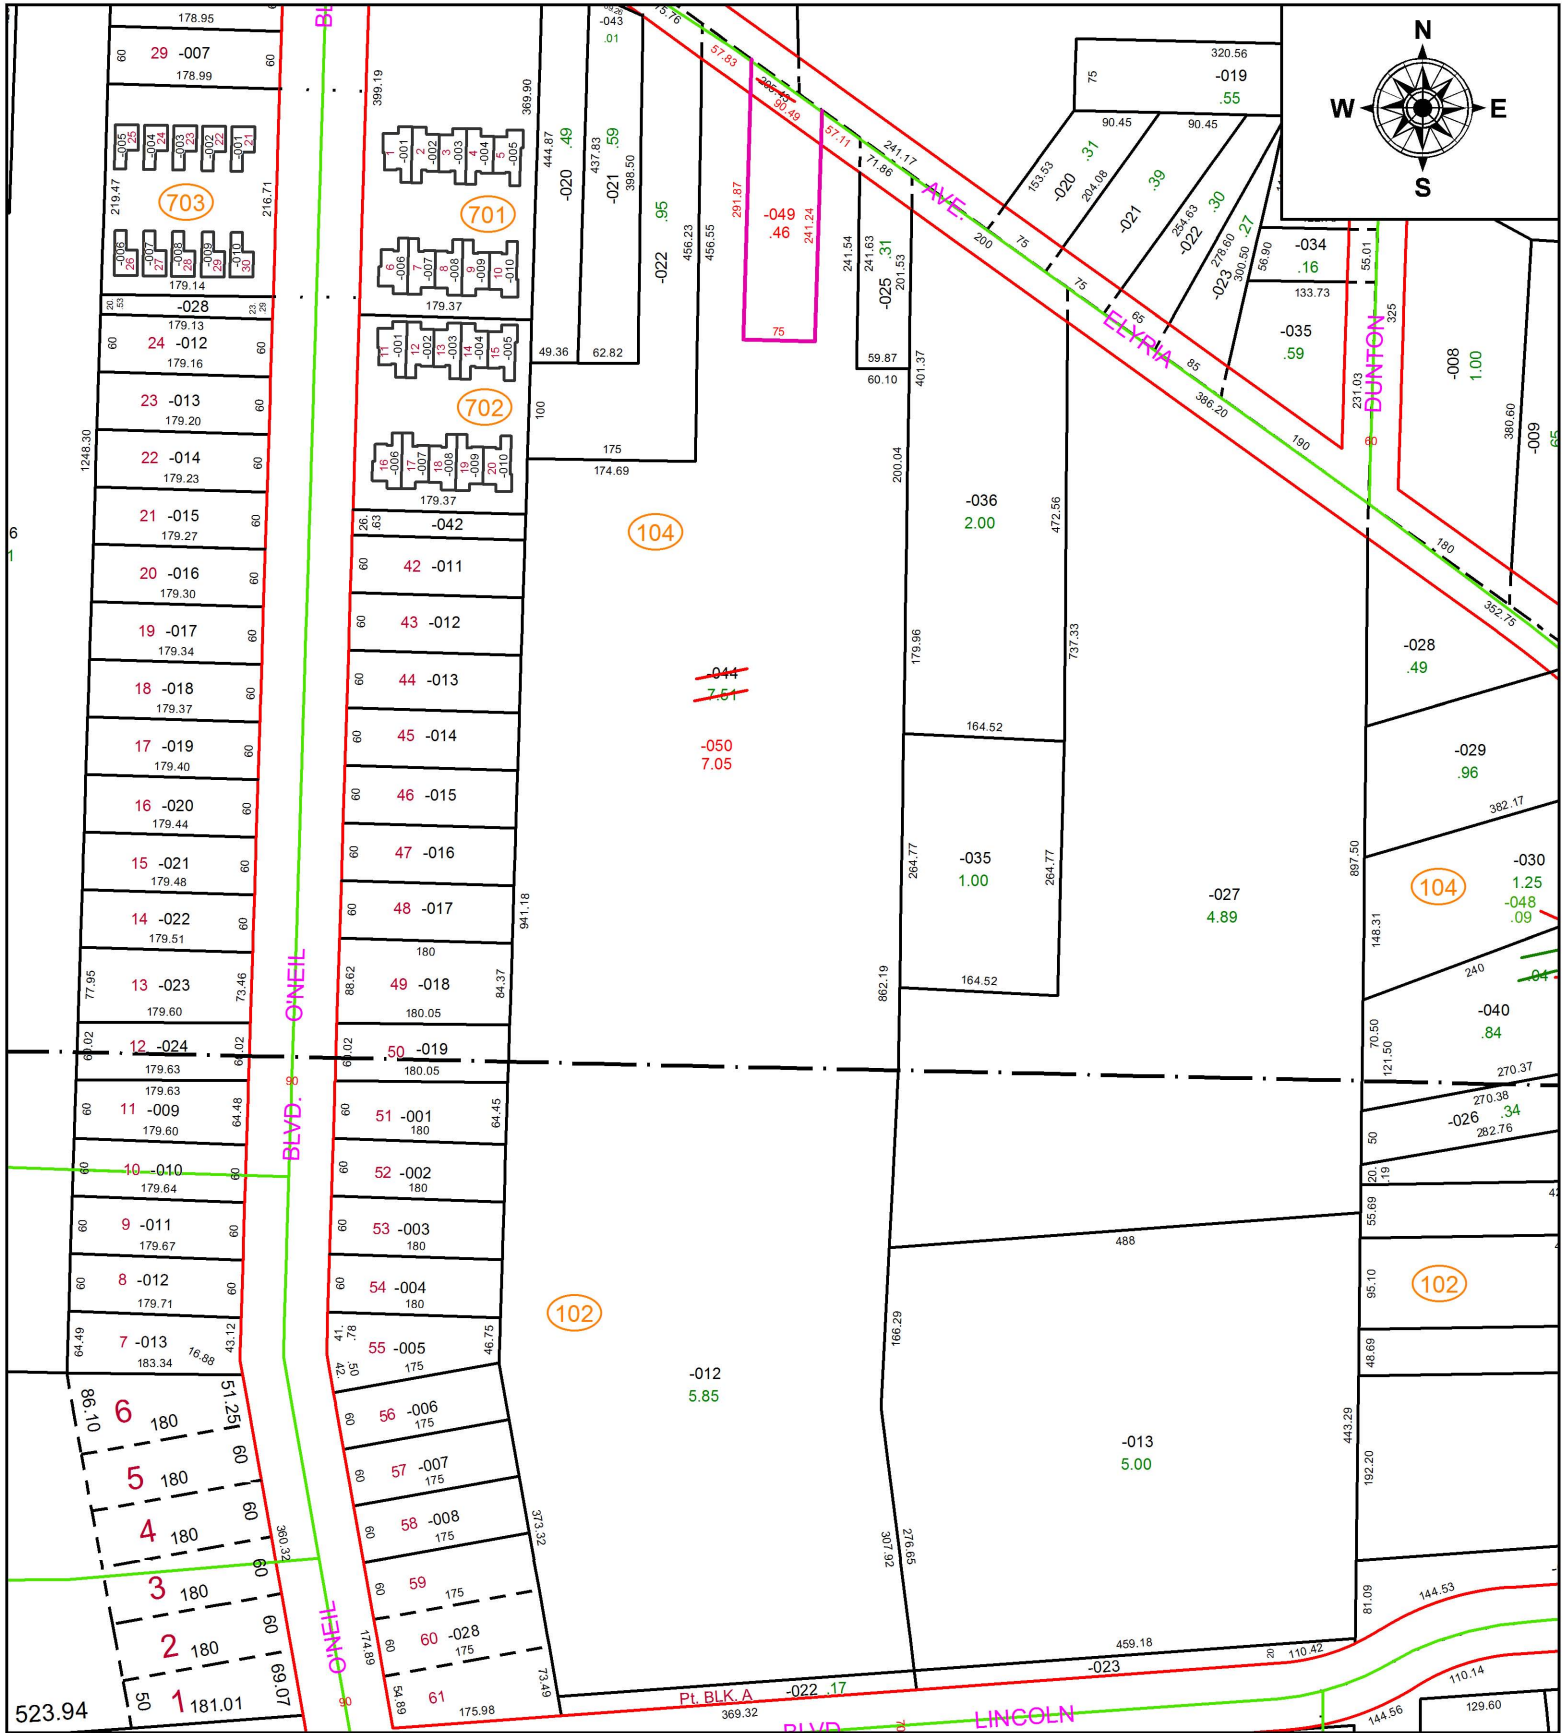

SPLITS/DEEDS PROCESSED
 LORAIN COUNTY TAX MAP DEPARTMENT
 226 MIDDLE AVE. ELYRIA, OH

SURVEYED BY: THOMAS A. SIMON
CLOSURE: 1: 201,257
MAP PAGE(S): 3-00-107
APPROVED BY: RRM **DATE:** 8-16-18
SCALE: 1" = 200 **PRIOR INSTRUMENT:** 20160602255