


PARENT PARCEL: 06-24-026-117-006

CHILD PARCEL: XX-XX-XXX-XXX-XXX


STARTING POINT: SOUTHWEST CORNER OF S/L 249 IN CRISP AND PETTIBONE'S FAIRVIEW ADD.

18-03863-D

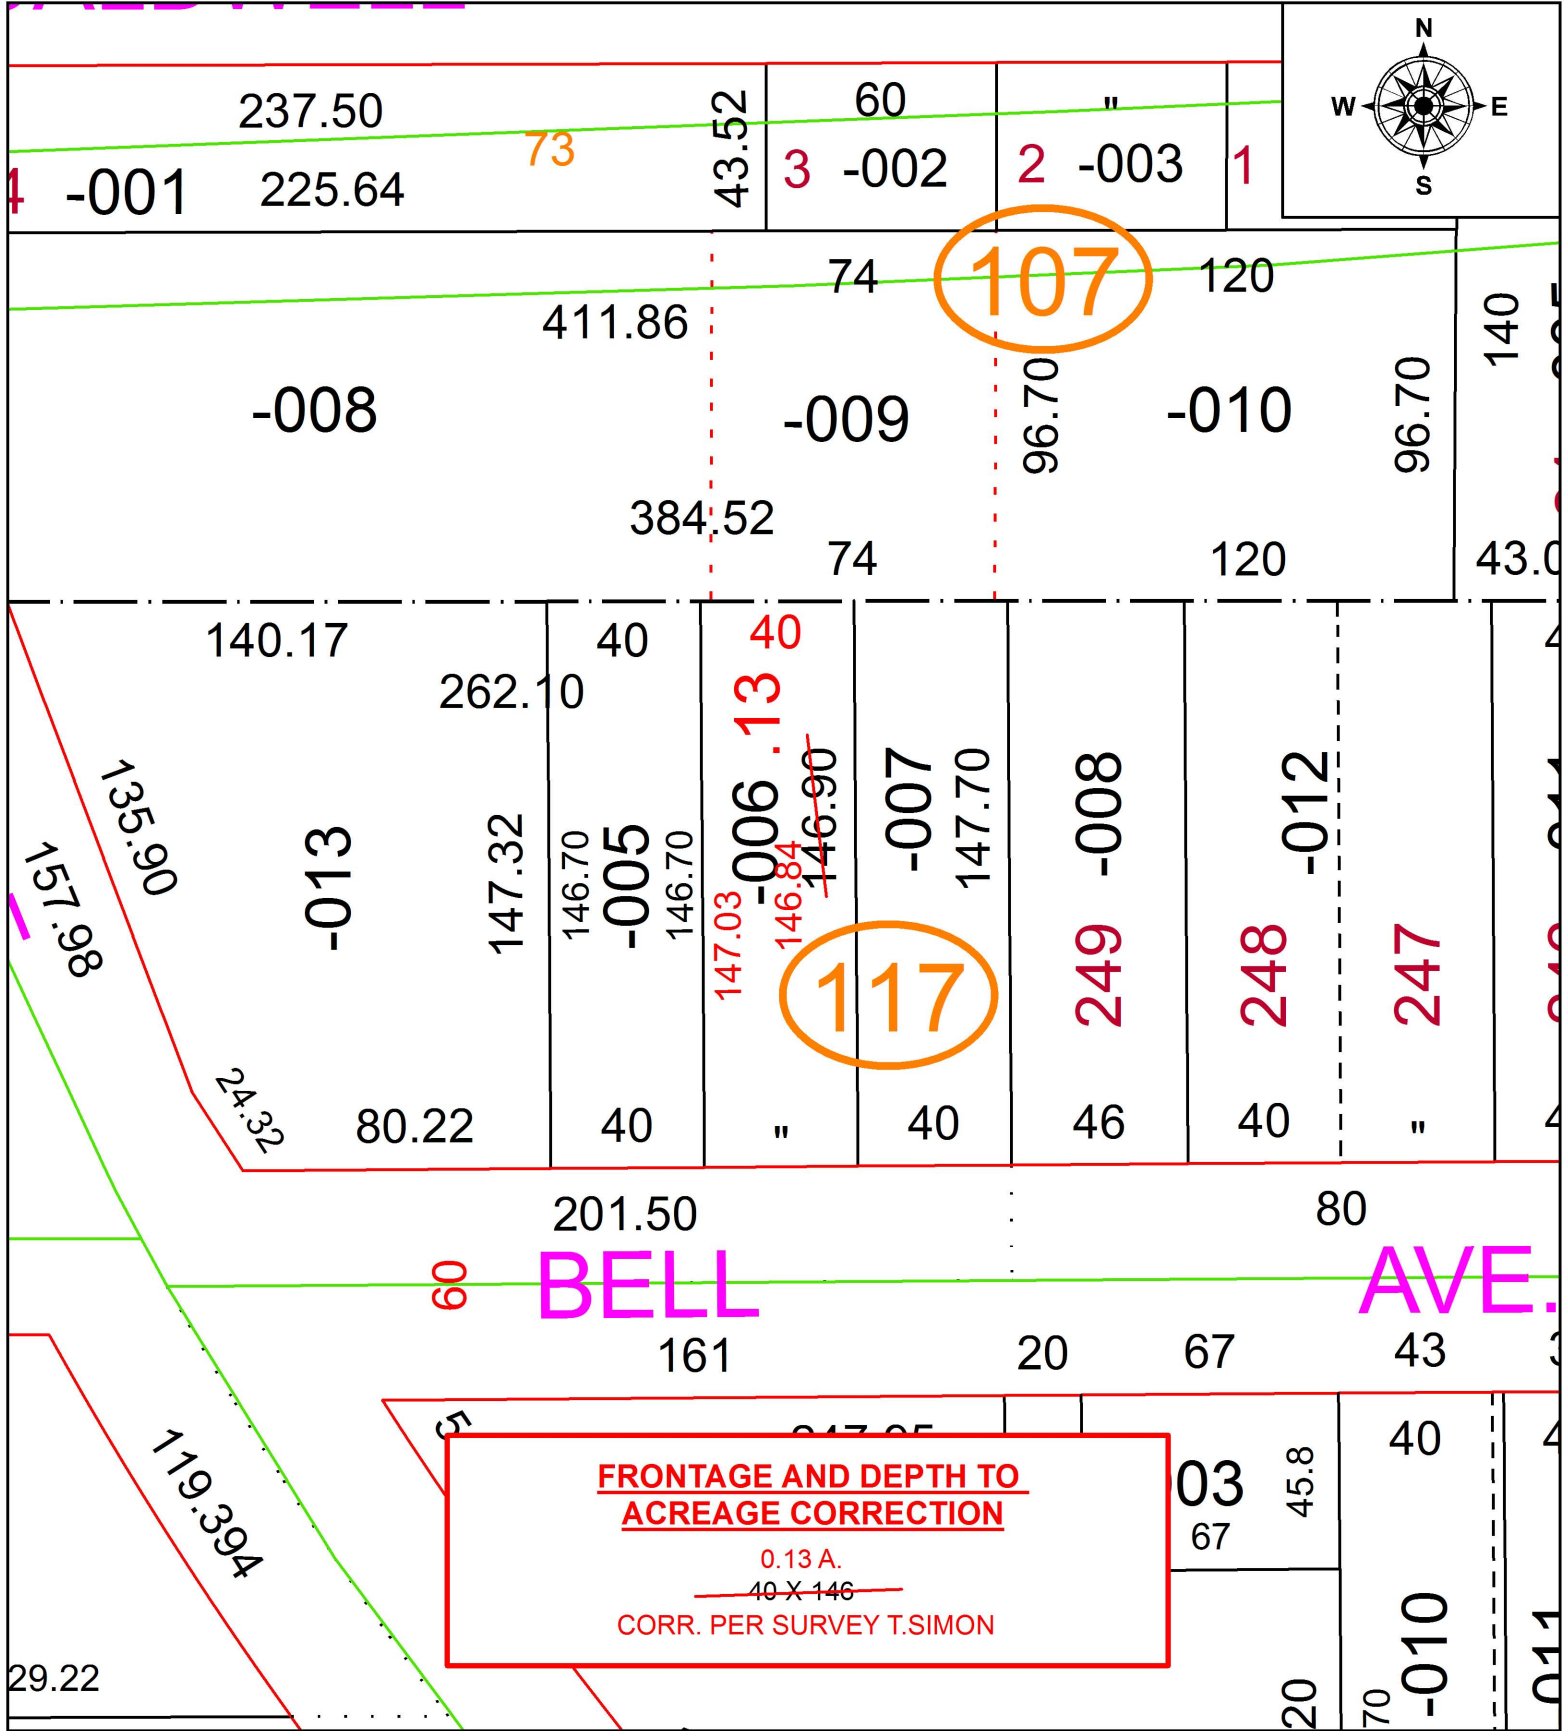

**FRONTAGE AND DEPTH TO
ACREAGE CORRECTION**

0.13 A.
~~40 X 146~~
CORR. PER SURVEY T.SIMON

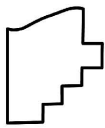

SPLITS/DEEDS PROCESSED
LORAIN COUNTY TAX MAP DEPARTMENT
226 MIDDLE AVE. ELYRIA, OH

SURVEYED BY: THOMAS A. SIMON
CLOSURE: 1: 111,653
MAP PAGE(S): 6-79
APPROVED BY: RRM DATE: 3-19-18
SCALE: 1" = 50 PRIOR INSTRUMENT: 20170654062