
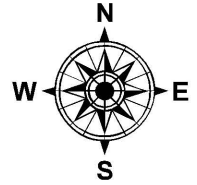


PARENT PARCEL: 14-00-096-000-038, 14-00-097-000-001

CHILD PARCEL: 14-00-096-000-051 THRU -053, 14-00-097-000-001

STARTING POINT: INTERSECTION OF C/L OF HALLAUER RD. AND NORTH LINE OF O.L.96

18-03864

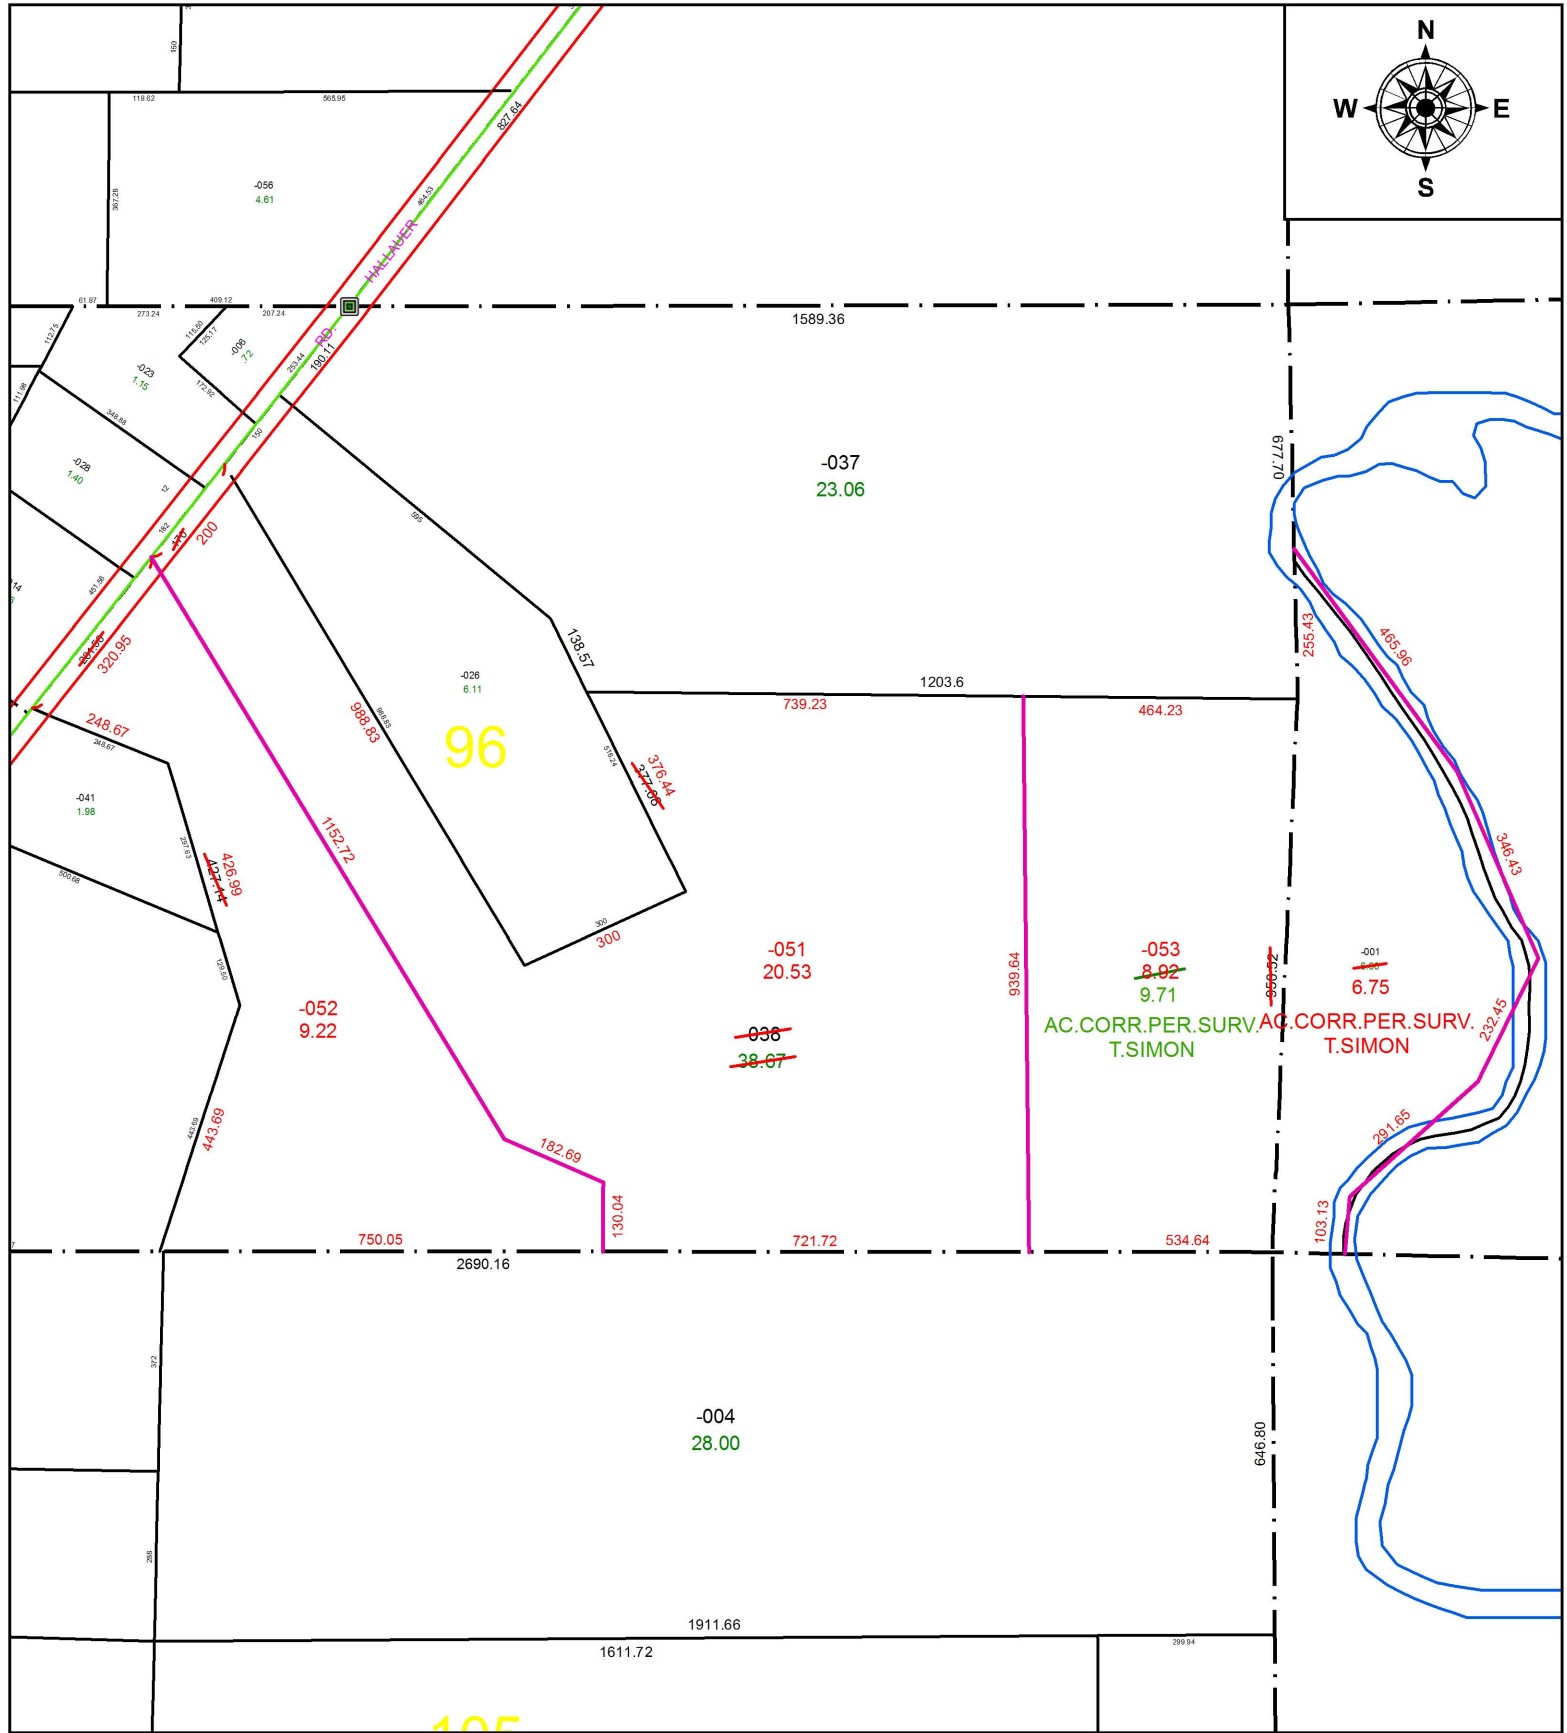

SPLITS/DEEDS PROCESSED
 LORAIN COUNTY TAX MAP DEPARTMENT
 226 MIDDLE AVE. ELYRIA, OH

SURVEYED BY: THOMAS A. SIMON
 CLOSURE: 1: 1,151,599
 MAP PAGE(S): 14-G
 APPROVED BY: RRM DATE: 8-28-18
 SCALE: 1" = 325 PRIOR INSTRUMENT: 20040982824