


PARENT PARCEL: 10-00-015-112-022

CHILD PARCEL: XX-XX-XXX-XXX-XXX

STARTING POINT: NORTHWEST CORNER OF S/L 207 IN BRENTWOOD ALLOT. NO. 5

18-03868-D

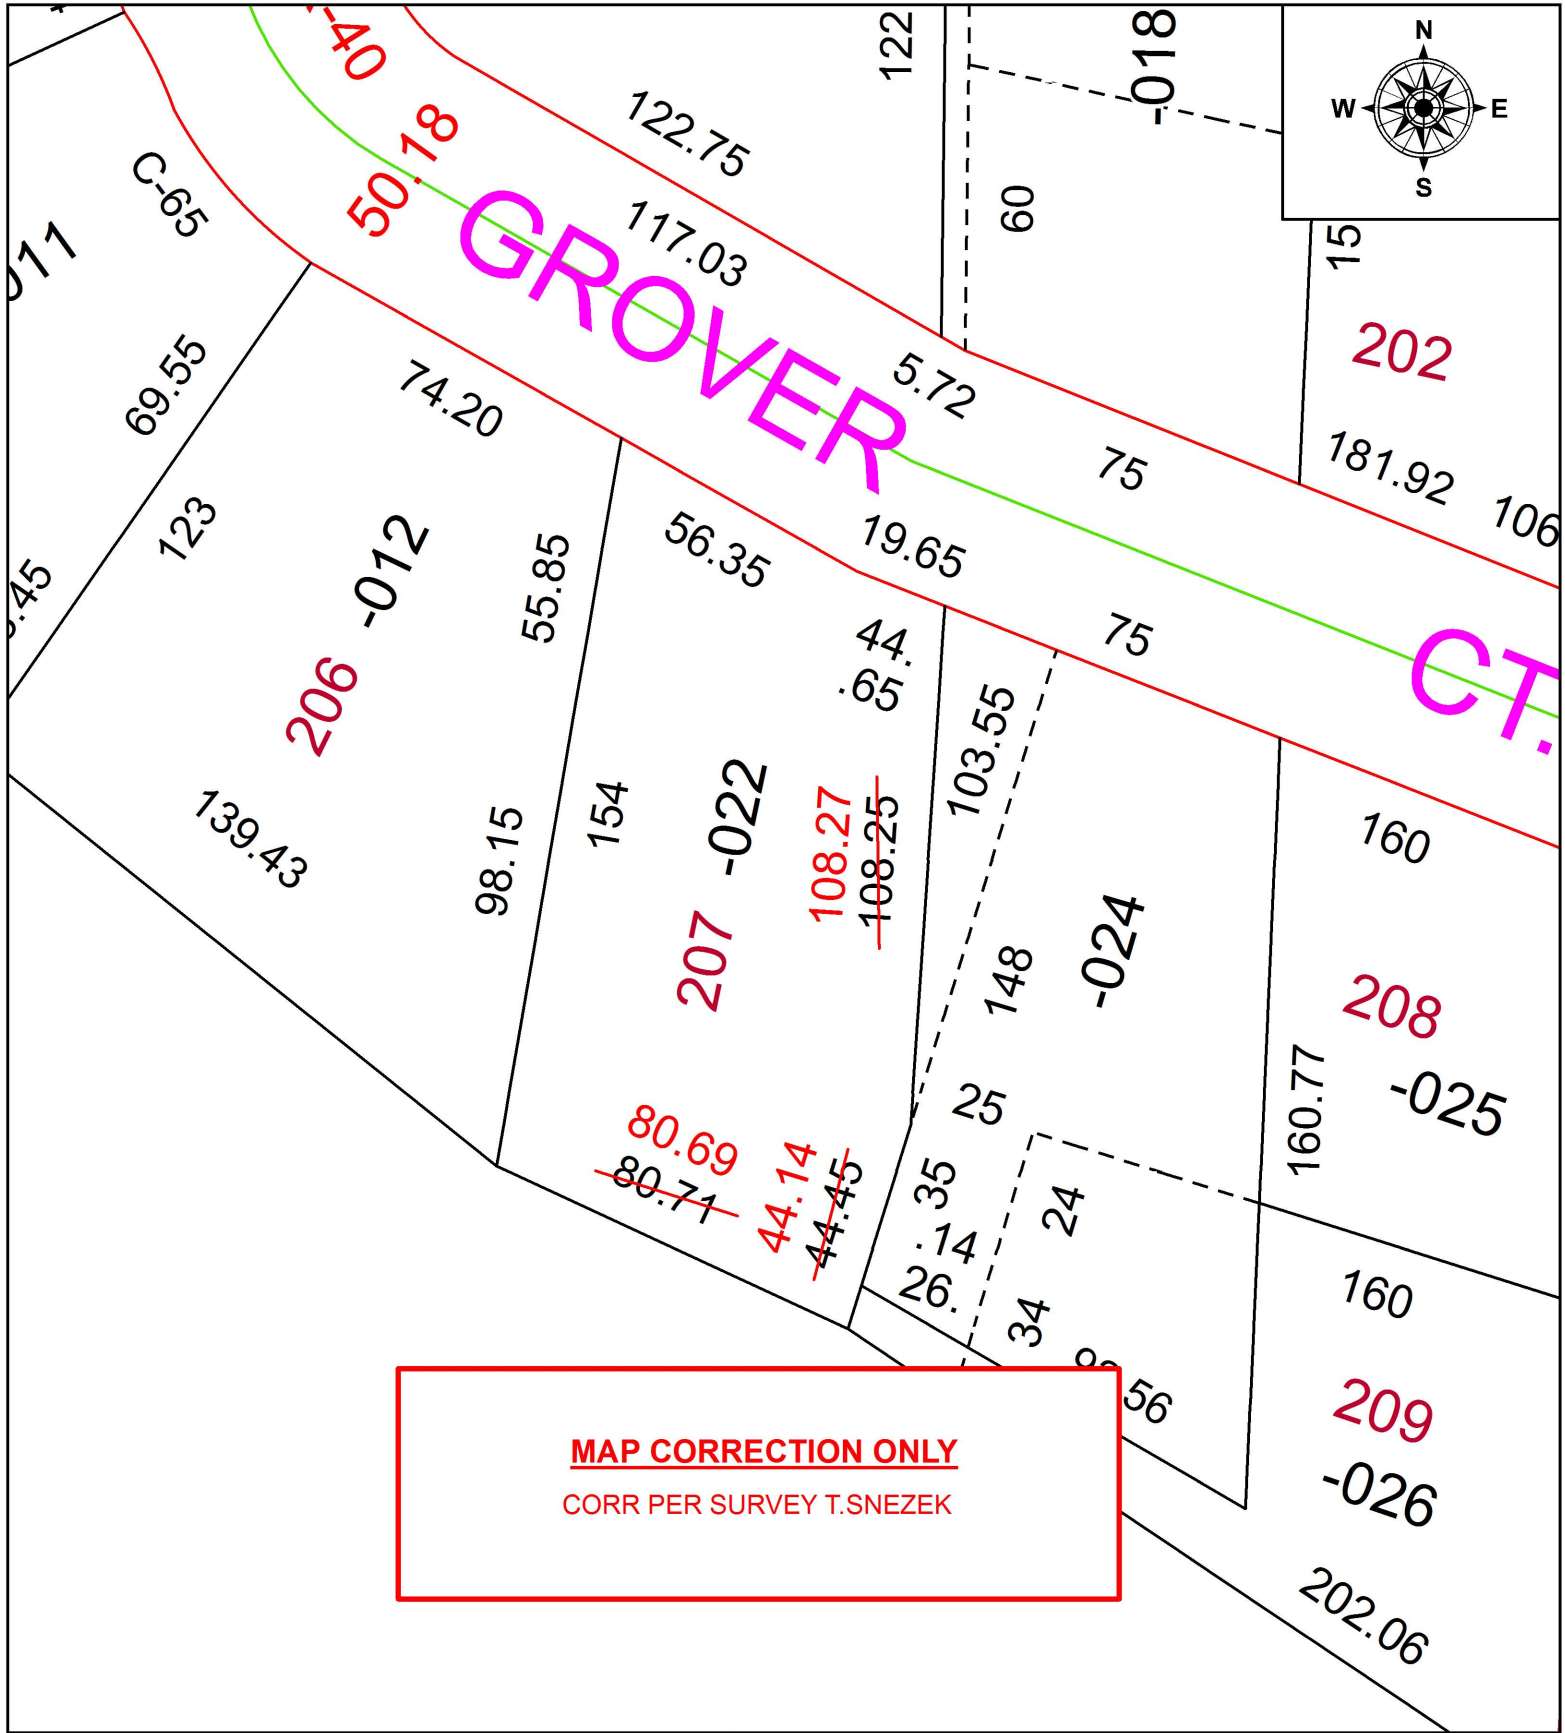

**MAP CORRECTION ONLY**  
 CORR PER SURVEY T.SNEZEK



**SPLITS/DEEDS PROCESSED**  
 LORAIN COUNTY TAX MAP DEPARTMENT  
 226 MIDDLE AVE. ELYRIA, OH

SURVEYED BY: THOMAS M. SNEZEK  
 CLOSURE: 1: 63,669  
 MAP PAGE(S): 10-00-015  
 APPROVED BY: RRM DATE: 3-28-18  
 SCALE: 1" = 40 PRIOR INSTRUMENT: 20130471747