
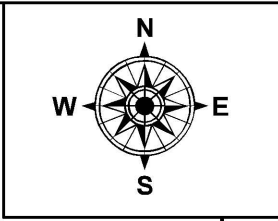


PARENT PARCEL: 05-00-051-000-018, -023


CHILD PARCEL: 05-00-051-000-026 THRU -028

STARTING POINT: INTERSECTION OF C/L OF OBERLIN RD. AND C/L OF ALBRECHT RD.

18-03868

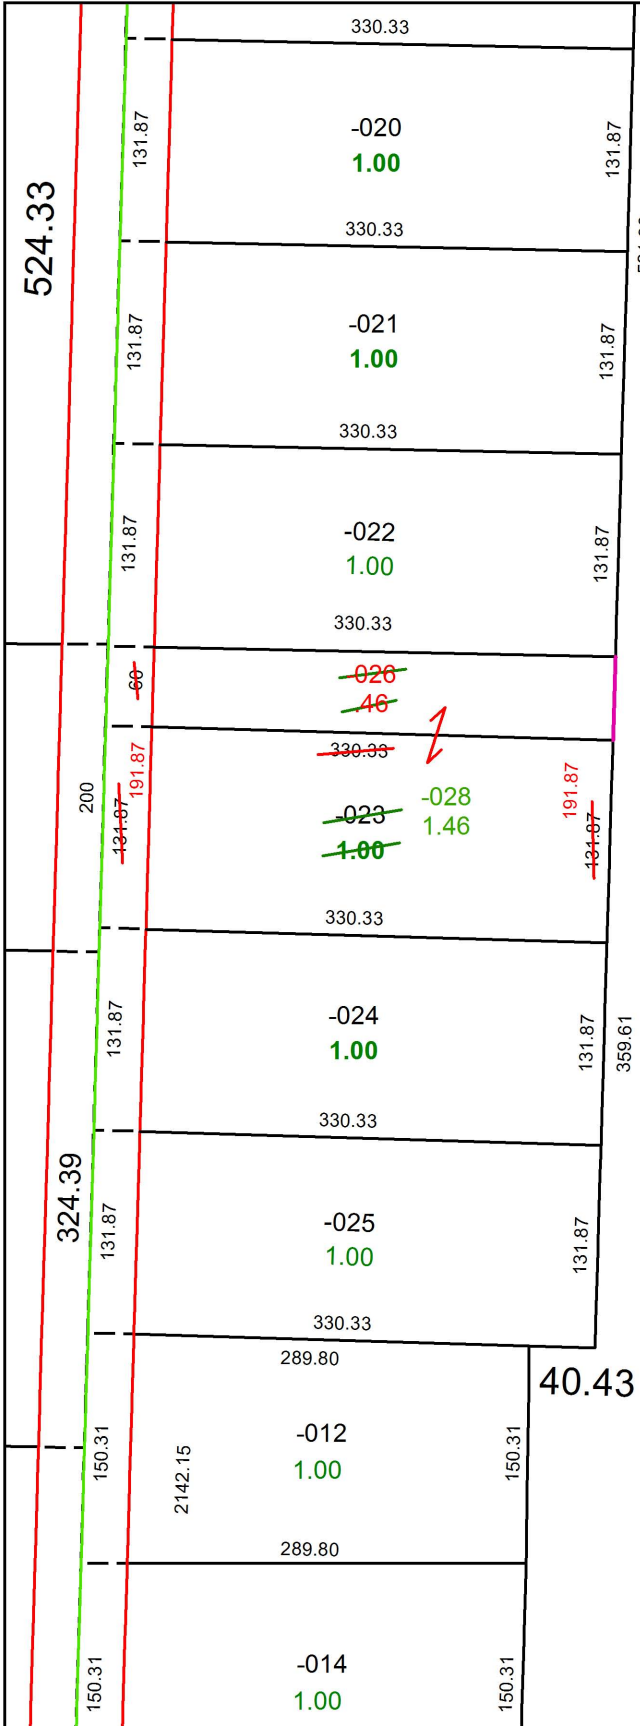

~~018~~
~~21.05~~
 -027
 20.59

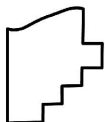

SPLITS/DEEDS PROCESSED
 LORAIN COUNTY TAX MAP DEPARTMENT
 226 MIDDLE AVE. ELYRIA, OH

SURVEYED BY: THOMAS A. SIMON
 CLOSURE: 1: 2147483648
 MAP PAGE(S): 5-00-051
 APPROVED BY: RRM DATE: 9-10-18
 SCALE: 1" = 125 PRIOR INSTRUMENT: 20070190193