


PARENT PARCEL: ADD TO DUP ATTACHED TO 01-00-001-108-012

CHILD PARCEL: 01-00-001-640-007, -008


STARTING POINT: SOUTHWEST CORNER OF S/L 12 IN EDISON VILLAGE ESTATES SUB. NO.1

18-03870

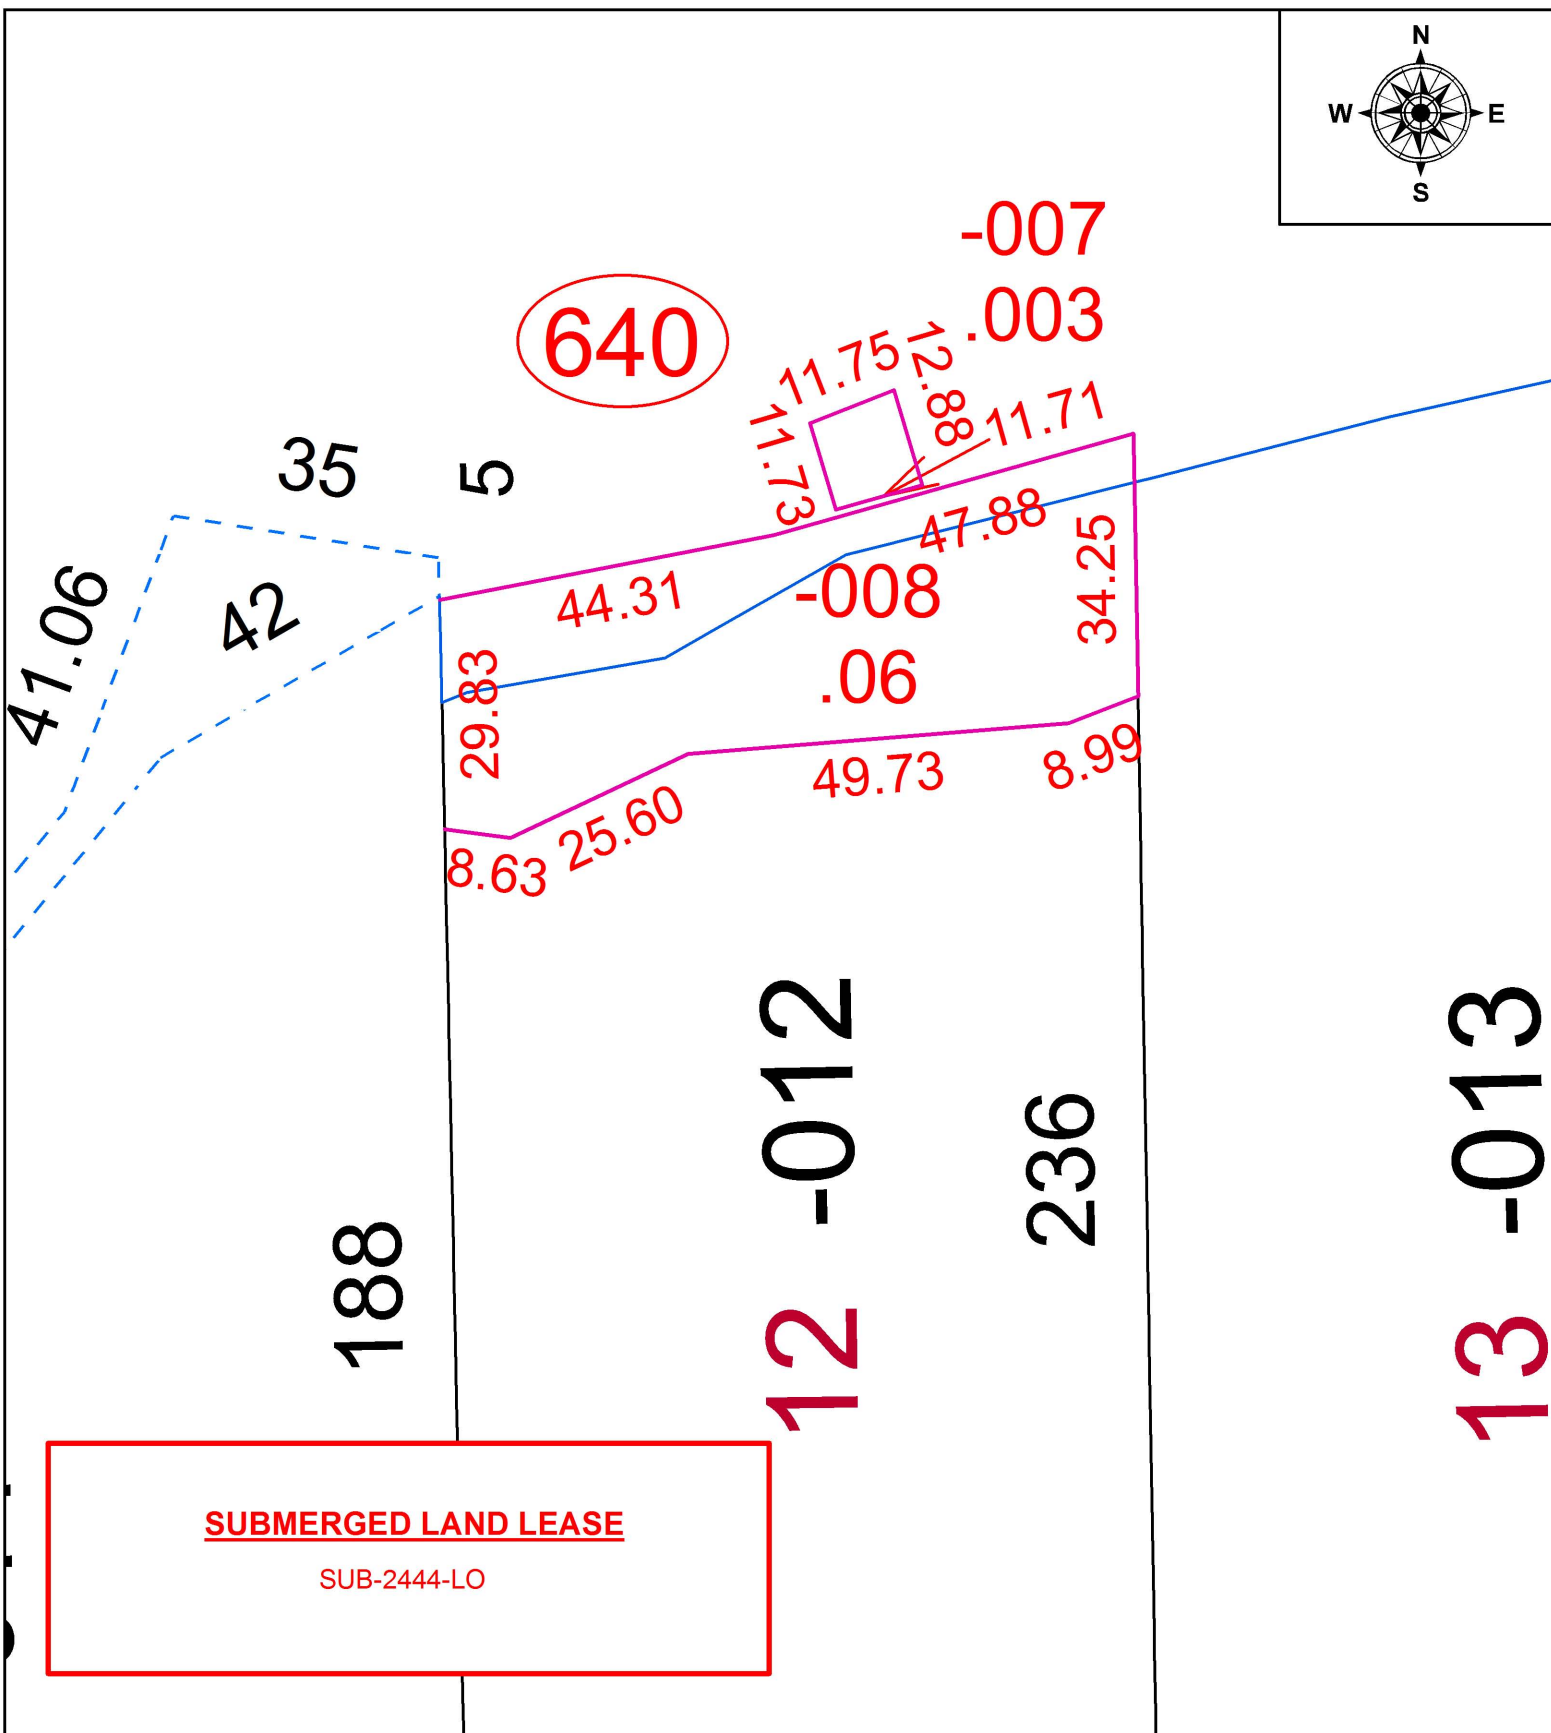

SUBMERGED LAND LEASE

SUB-2444-LO

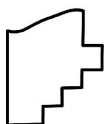

SPLITS/DEEDS PROCESSED
LORAIN COUNTY TAX MAP DEPARTMENT
226 MIDDLE AVE. ELYRIA, OH

SURVEYED BY: THOMAS M. SNEZEK

CLOSURE: 1: 27,779

MAP PAGE(S): 1-00-001

APPROVED BY: RRM DATE: 9-17-18

SCALE: 1" = 25' PRIOR INSTRUMENT: 20070200512