


PARENT PARCEL: 06-24-003-104-090, 06-24-015-000-021,-022,-023,-,032,-033,-036,-037,-040,-050,06-24-016-000-036,-,082,-081,-086

CHILD PARCEL: 06-24-003-104-090,06-24-015-000-021,-022,-023,-128,-129,-130,06-24-016-000-091

STARTING POINT: SOUTHWEST CORNER OF S/L 19 IN WEST RIDGE SUB. NO.2

18-03872-D

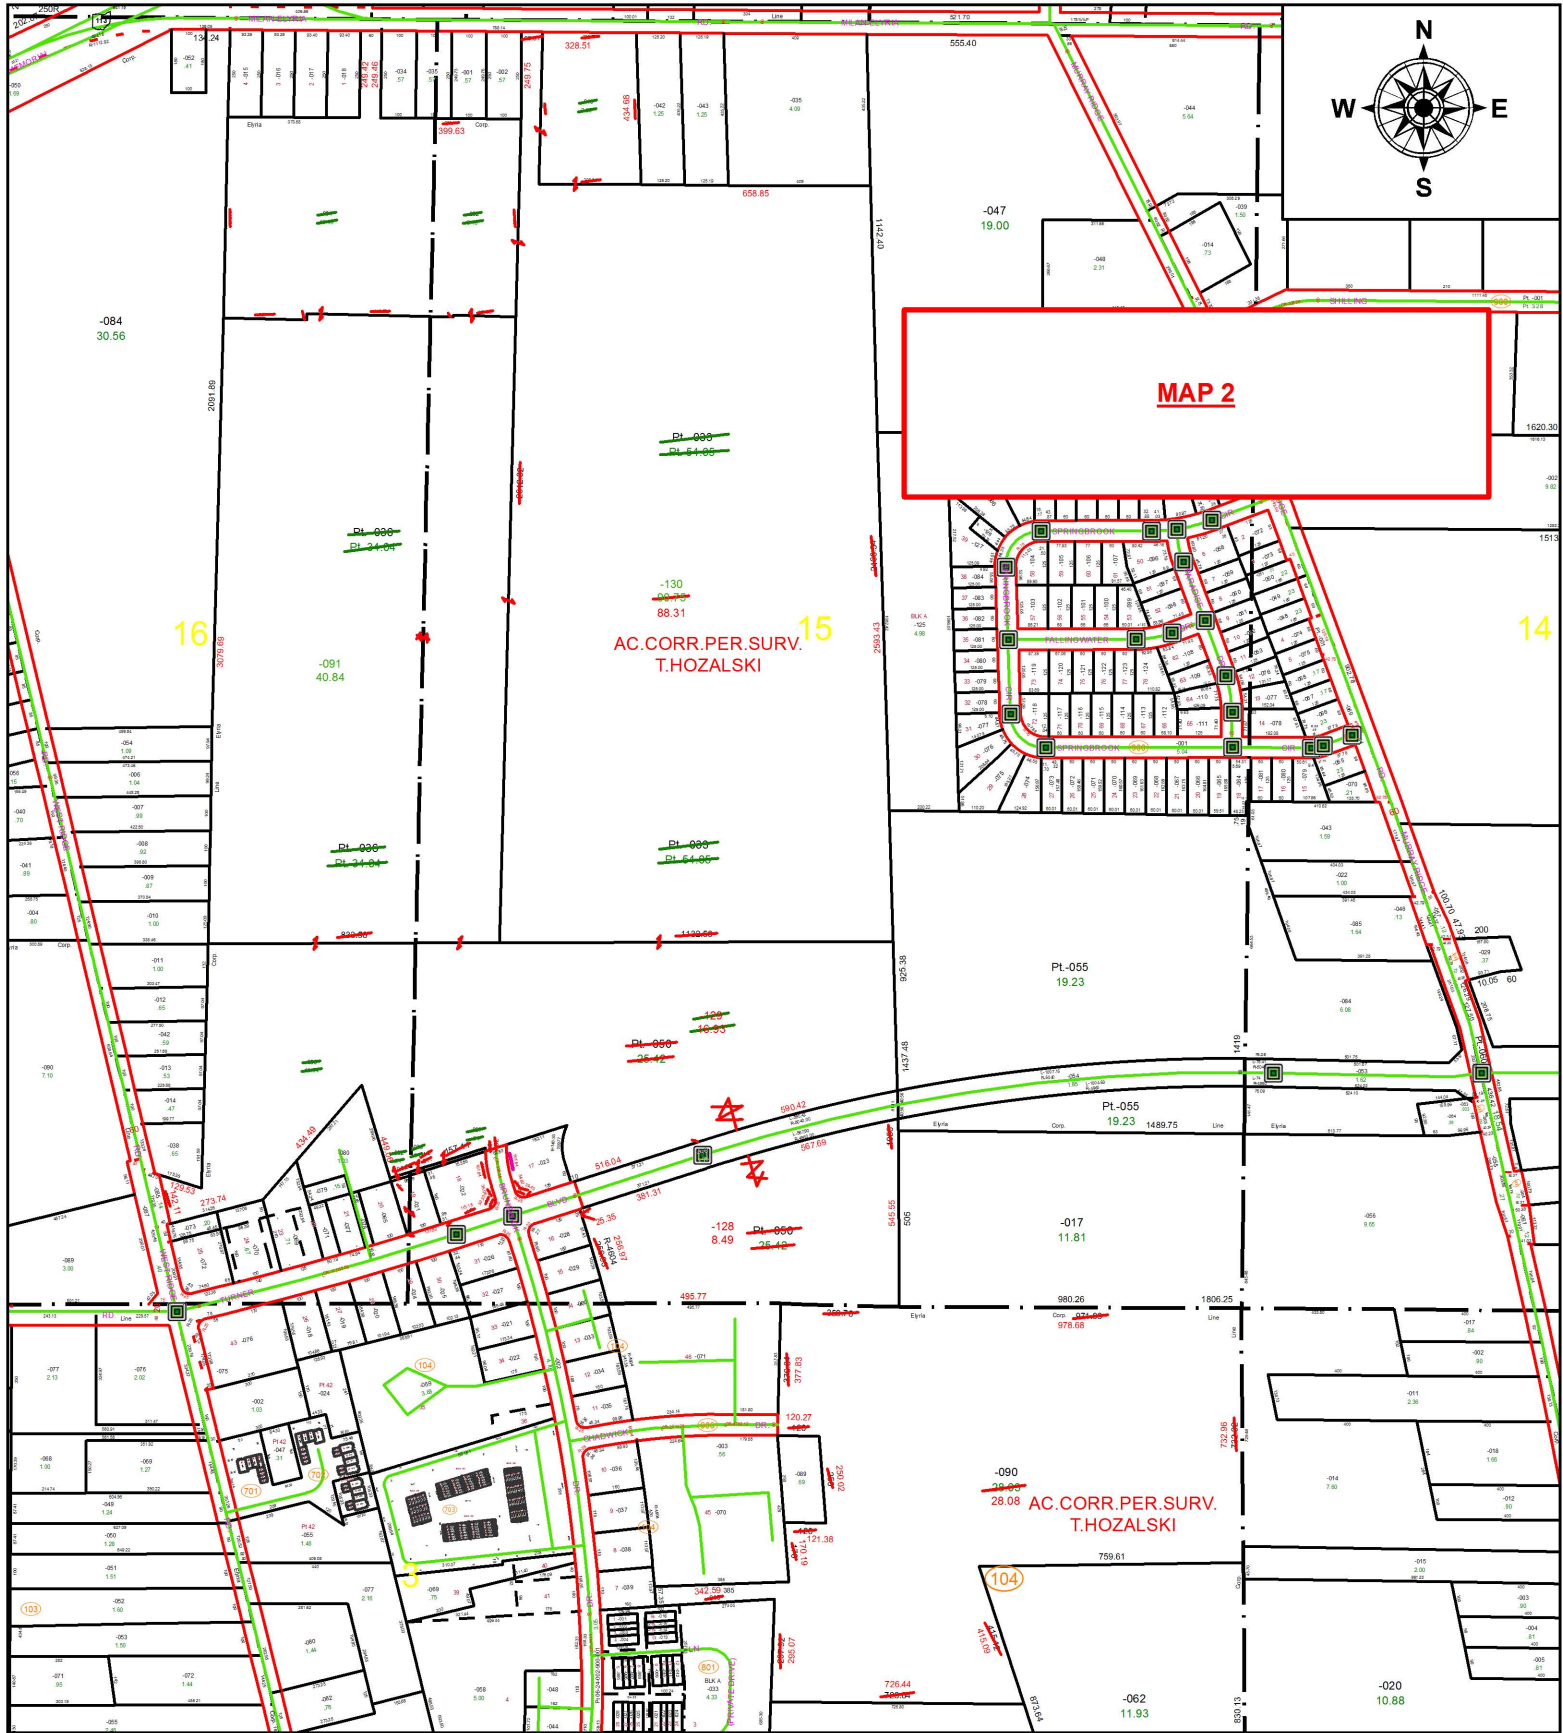

SPLITS/DEEDS PROCESSED

LORAIN COUNTY TAX MAP DEPARTMENT
226 MIDDLE AVE. ELYRIA, OH

SURVEYED BY: TIMOTHY D. HOZALSKI

CLOSURE: 1: 723,352

MAP PAGE(S): 6-110

APPROVED BY: RRM DATE: 4-16-18

SCALE: 1" = 550 PRIOR INSTRUMENT: 20170623477