
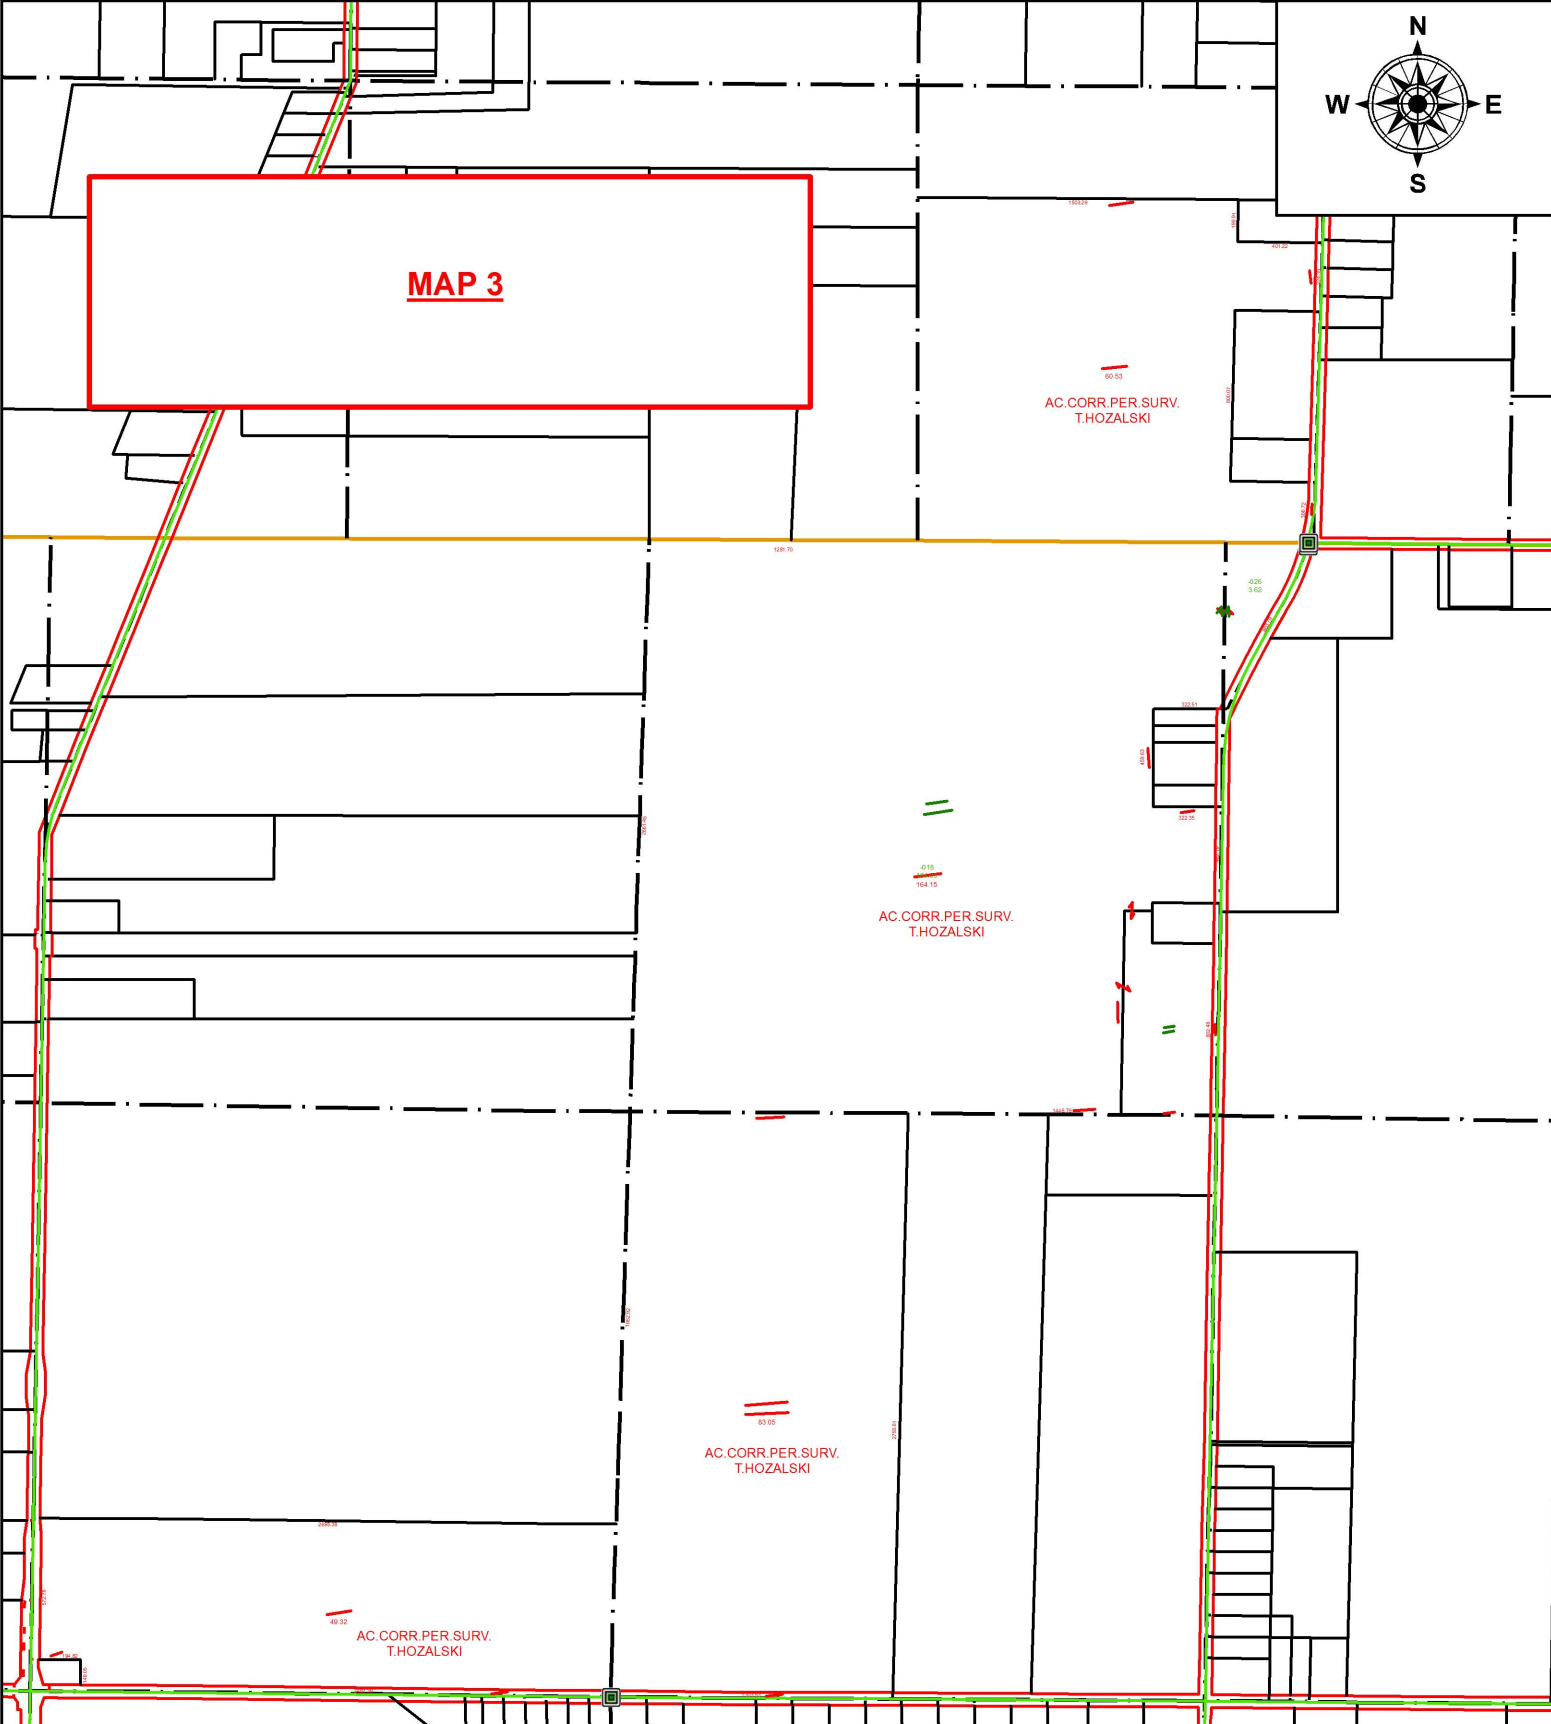


PARENT PARCEL: 05-00-051-000-011,09-00-007-000-014,-016,09-00-016-000-006,09-00-017-000-001
CHILD PARCEL: 05-00-051-000-011,09-00-007-000-018,09-00-008-000-026,09-00-016-000-006,09-00-017-000-001
STARTING POINT: SOUTHEAST CORNER OF O.L.7

18-03872-D

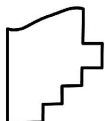


SPLITS/DEEDS PROCESSED
LORAIN COUNTY TAX MAP DEPARTMENT
226 MIDDLE AVE. ELYRIA, OH

SURVEYED BY: TIMOTHY D. HOZALSKI
CLOSURE: 1: 434,502
MAP PAGE(S): 9-C
APPROVED BY: RRM DATE: 4-16-18
SCALE: 1" = 900 PRIOR INSTRUMENT: 20120439998