
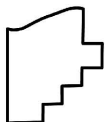


PARENT PARCEL: 09-00-008-000-013, -015

CHILD PARCEL: 09-00-008-000-027

STARTING POINT: SOUTHEAST CORNER OF O.L.7

18-03872-D

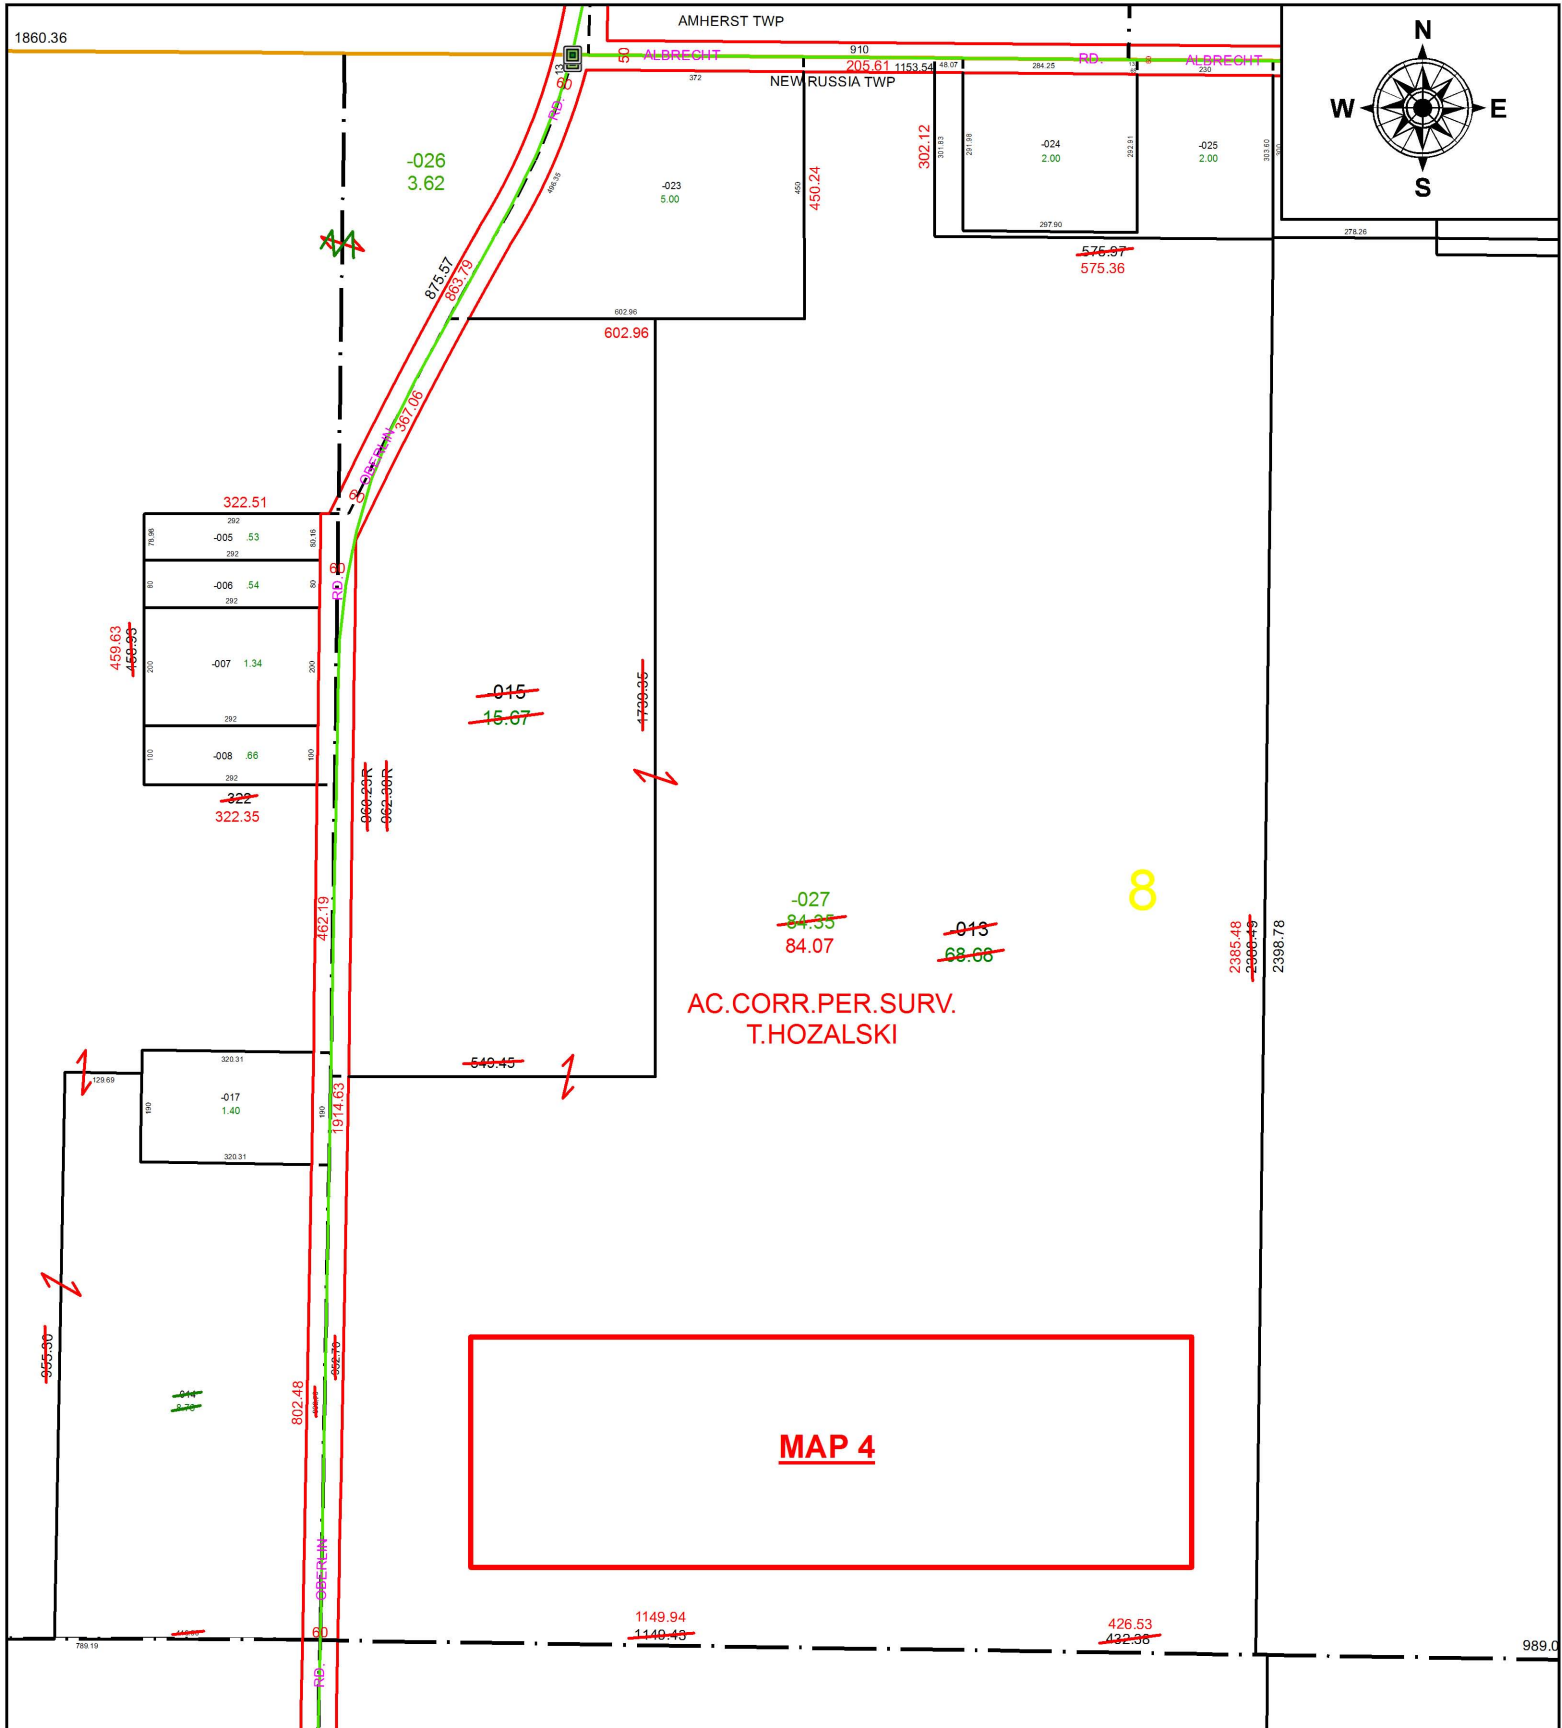

**SPLITS/DEEDS PROCESSED**  
 LORAIN COUNTY TAX MAP DEPARTMENT  
 226 MIDDLE AVE. ELYRIA, OH

**SURVEYED BY:** TIMOTHY D. HOZALSKI  
**CLOSURE:** 1: 1,157,006  
**MAP PAGE(S):** 9-C  
**APPROVED BY:** RRM **DATE:** 4-16-18  
**SCALE:** 1" = 325 **PRIOR INSTRUMENT:** 20120439990