

PARENT PARCEL: 05-00-042-104-091



CHILD PARCEL: 05-00-042-104-097, -098

STARTING POINT: INTERSECTION OF C/L OF S.R. 58 AND C/L OF NORTH RIDGE RD.

18-03872


8.30

10.2

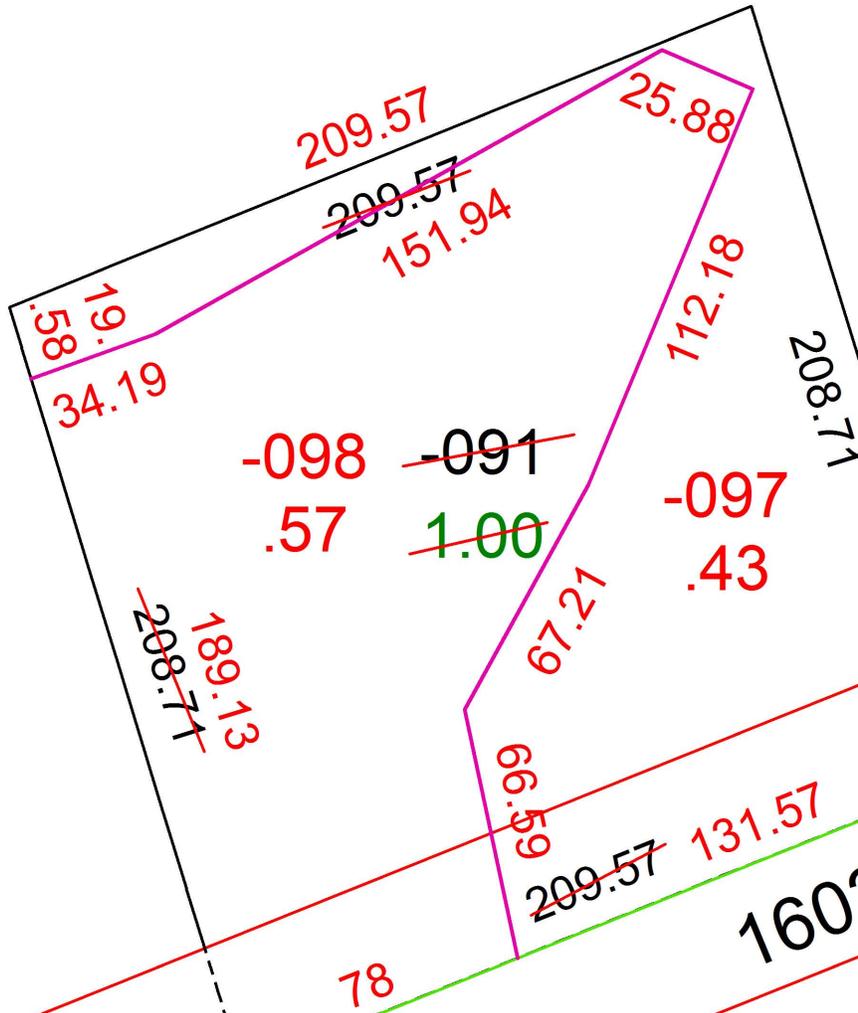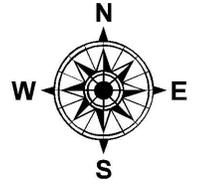

208.71

Corp.

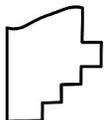

SPLITS/DEEDS PROCESSED
 LORAIN COUNTY TAX MAP DEPARTMENT
 226 MIDDLE AVE. ELYRIA, OH

SURVEYED BY: THOMAS A. SIMON
 CLOSURE: 1: 212,380
 MAP PAGE(S): 5-00-042
 APPROVED BY: RRM DATE: 9-20-18
 SCALE: 1" = 50' PRIOR INSTRUMENT: 20180672607