


PARENT PARCEL: 18-00-027-106-021, -075

CHILD PARCEL: XX-XX-XXX-XXX-XXX




STARTING POINT: NORTHEAST CORNER OF O.L.27

18-03873-D

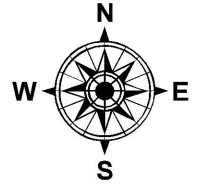

FRONTAGE CORRECTION
 22.91 X 97
~~21.34 X 97~~
 18-00-027-106-021
 CORR. PER SURVEY T.SNEZEK

FRONTAGE AND DEPTH CORRECTION
 32 X 97
~~33 X 100~~
 18-00-027-106-075
 CORR. PER SURVEY T.SNEZEK

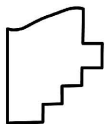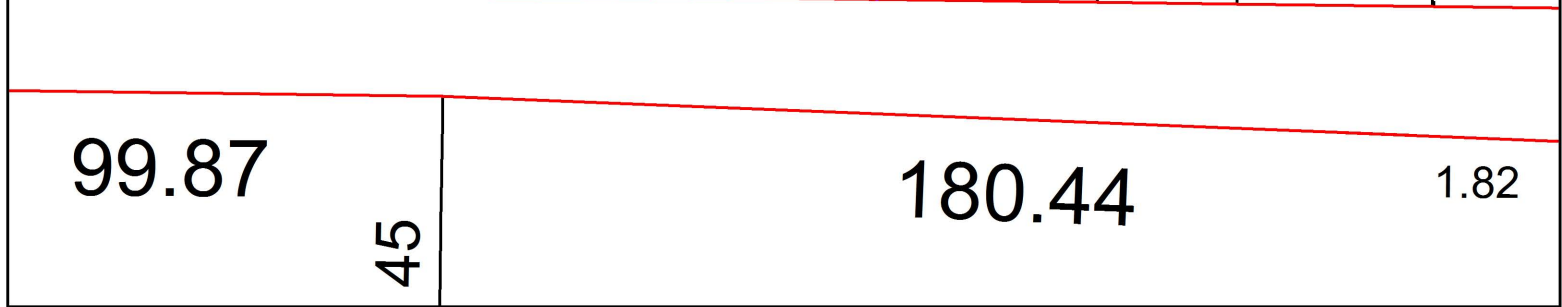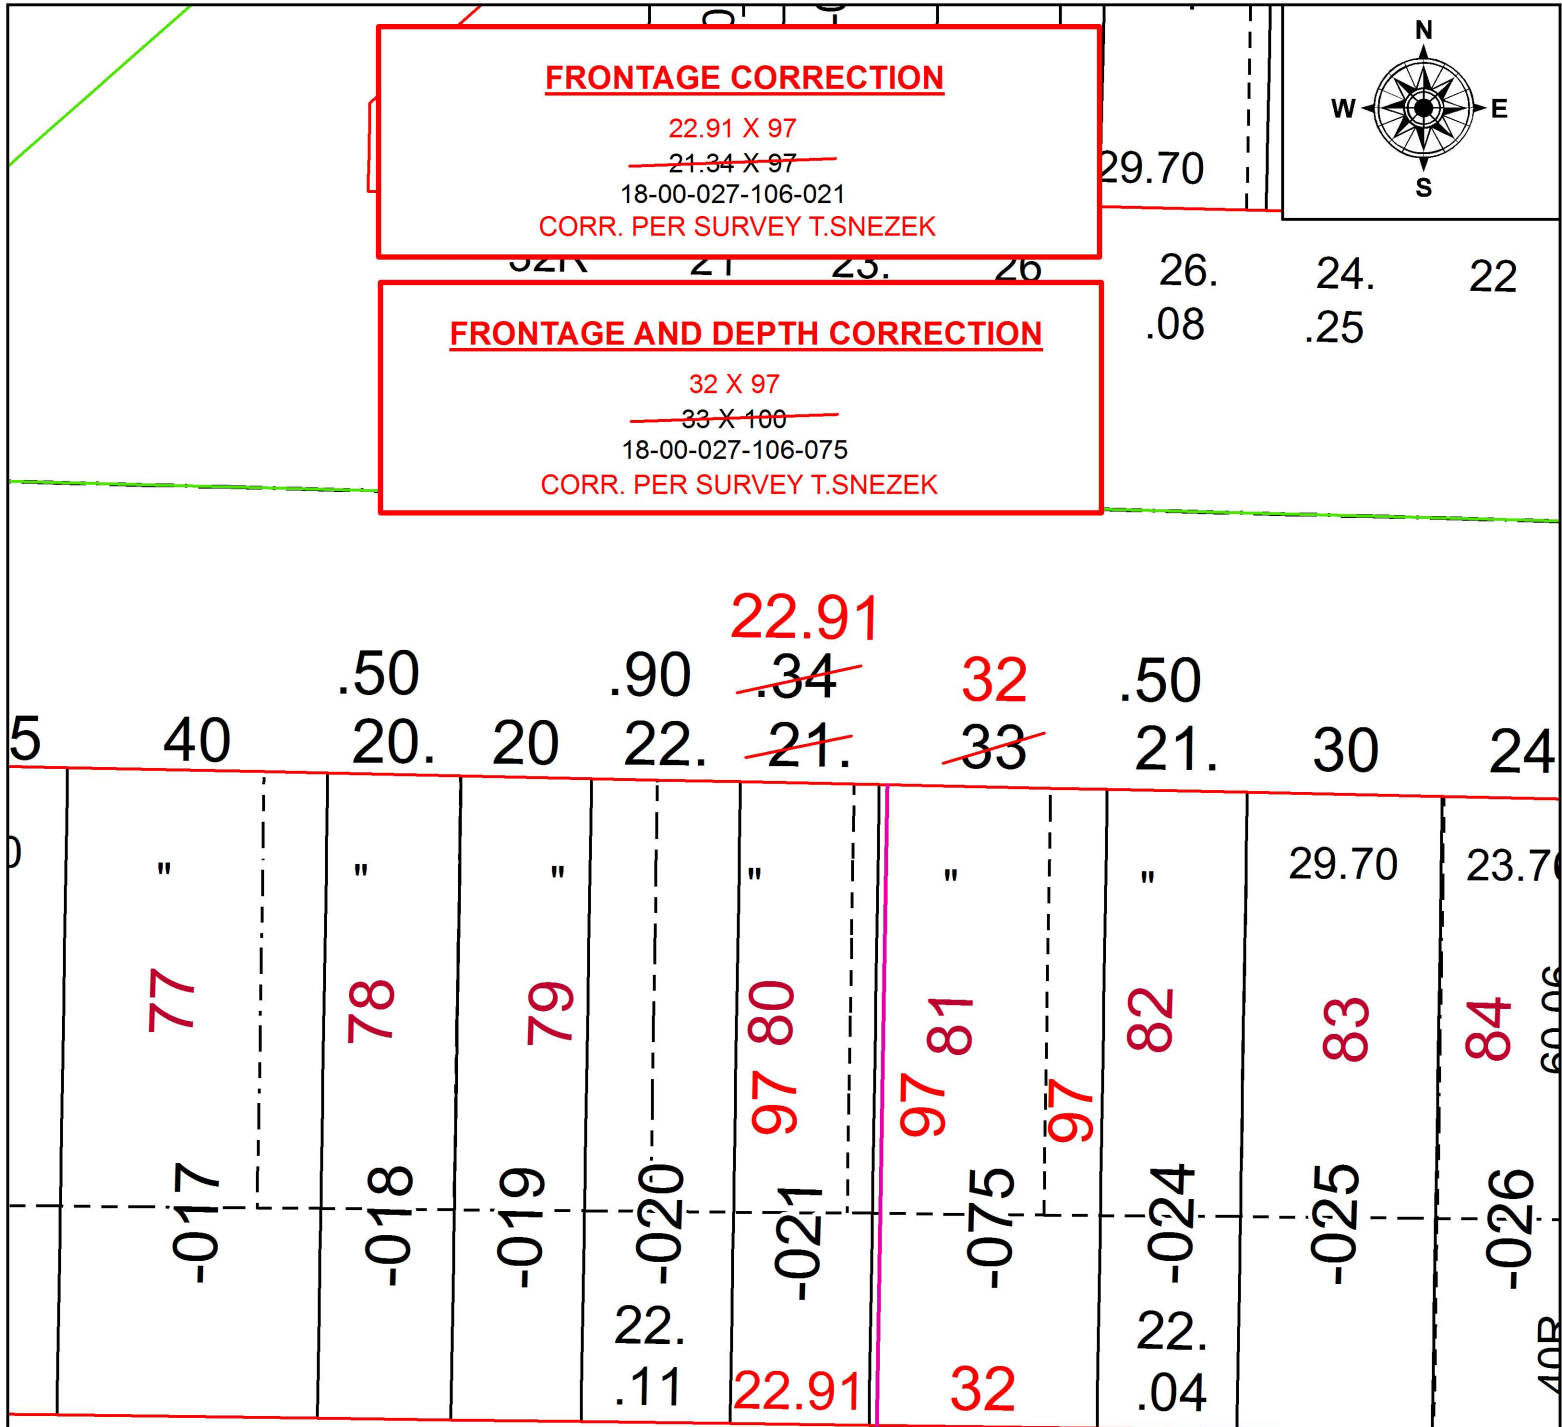

SPLITS/DEEDS PROCESSED
 LORAIN COUNTY TAX MAP DEPARTMENT
 226 MIDDLE AVE. ELYRIA, OH

SURVEYED BY: THOMAS M. SNEZEK
 CLOSURE: 1: 2147483648
 MAP PAGE(S): 18-00-027
 APPROVED BY: RRM DATE: 4-16-18
 SCALE: 1" = 30 PRIOR INSTRUMENT: 20150570035