
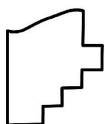


PARENT PARCEL: 11-00-045-000-050

CHILD PARCEL: 11-00-045-000-055, -056

STARTING POINT: NORTHWEST CORNER OF O.L.45

18-03873

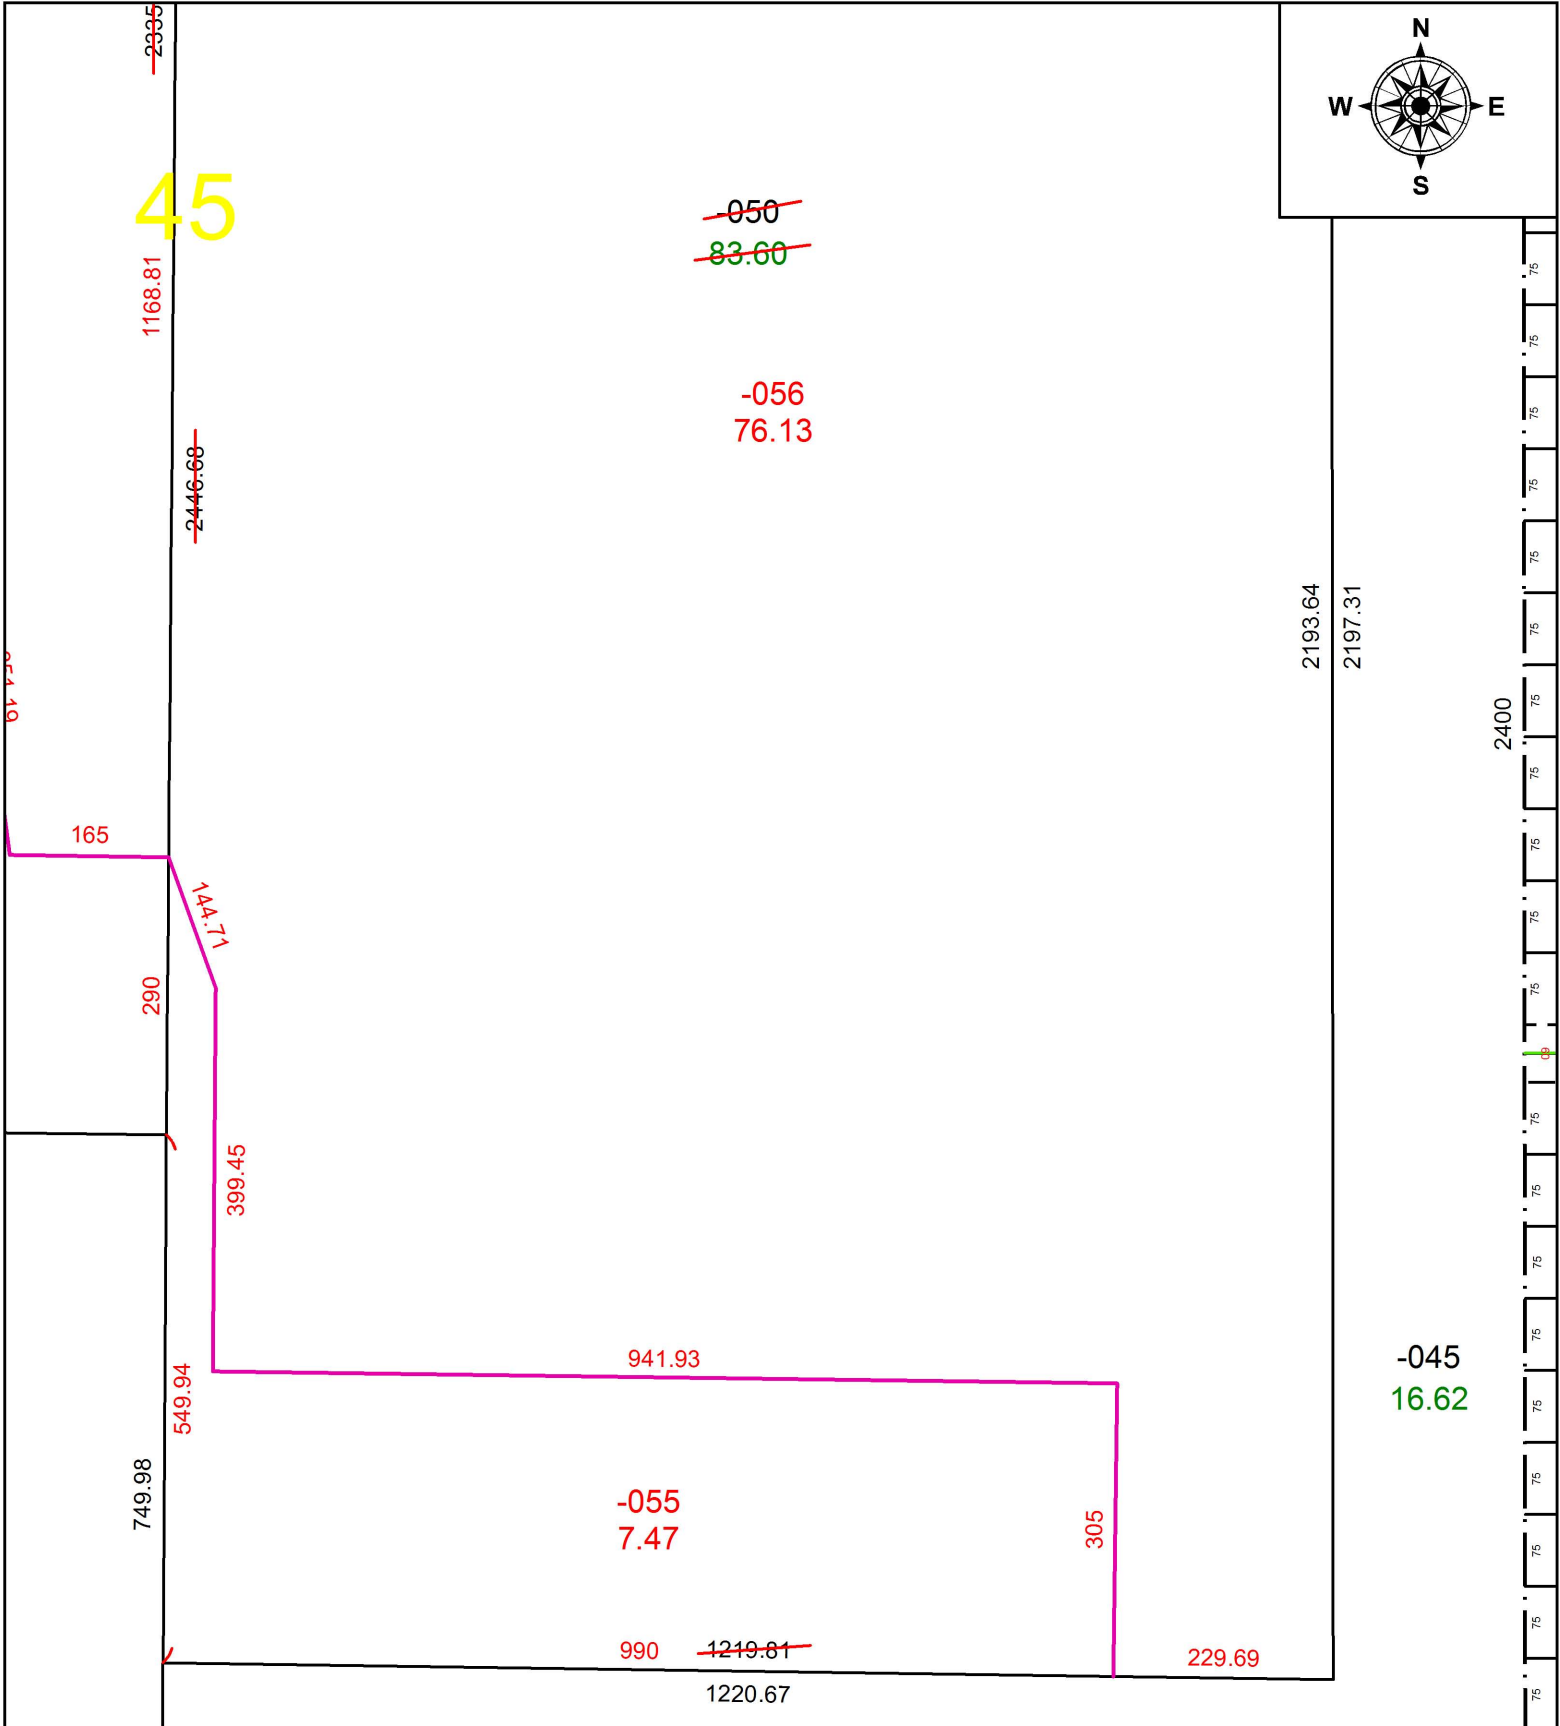

**SPLITS/DEEDS PROCESSED**  
 LORAIN COUNTY TAX MAP DEPARTMENT  
 226 MIDDLE AVE. ELYRIA, OH

SURVEYED BY: ANDREW G. PLANET

CLOSURE: 1: 1,559,512

MAP PAGE(S): 11-00-045

APPROVED BY: RRM DATE: 9-20-18

SCALE: 1" = 200 PRIOR INSTRUMENT: 20010738234