


PARENT PARCEL: 07-00-007-105-032

CHILD PARCEL: 07-00-007-105-034, -035

STARTING POINT: S/L'S 20 & 21 IN BLOCK JJ OF RIDGEVILLE HEIGHTS ALLOT.

18-03875-U

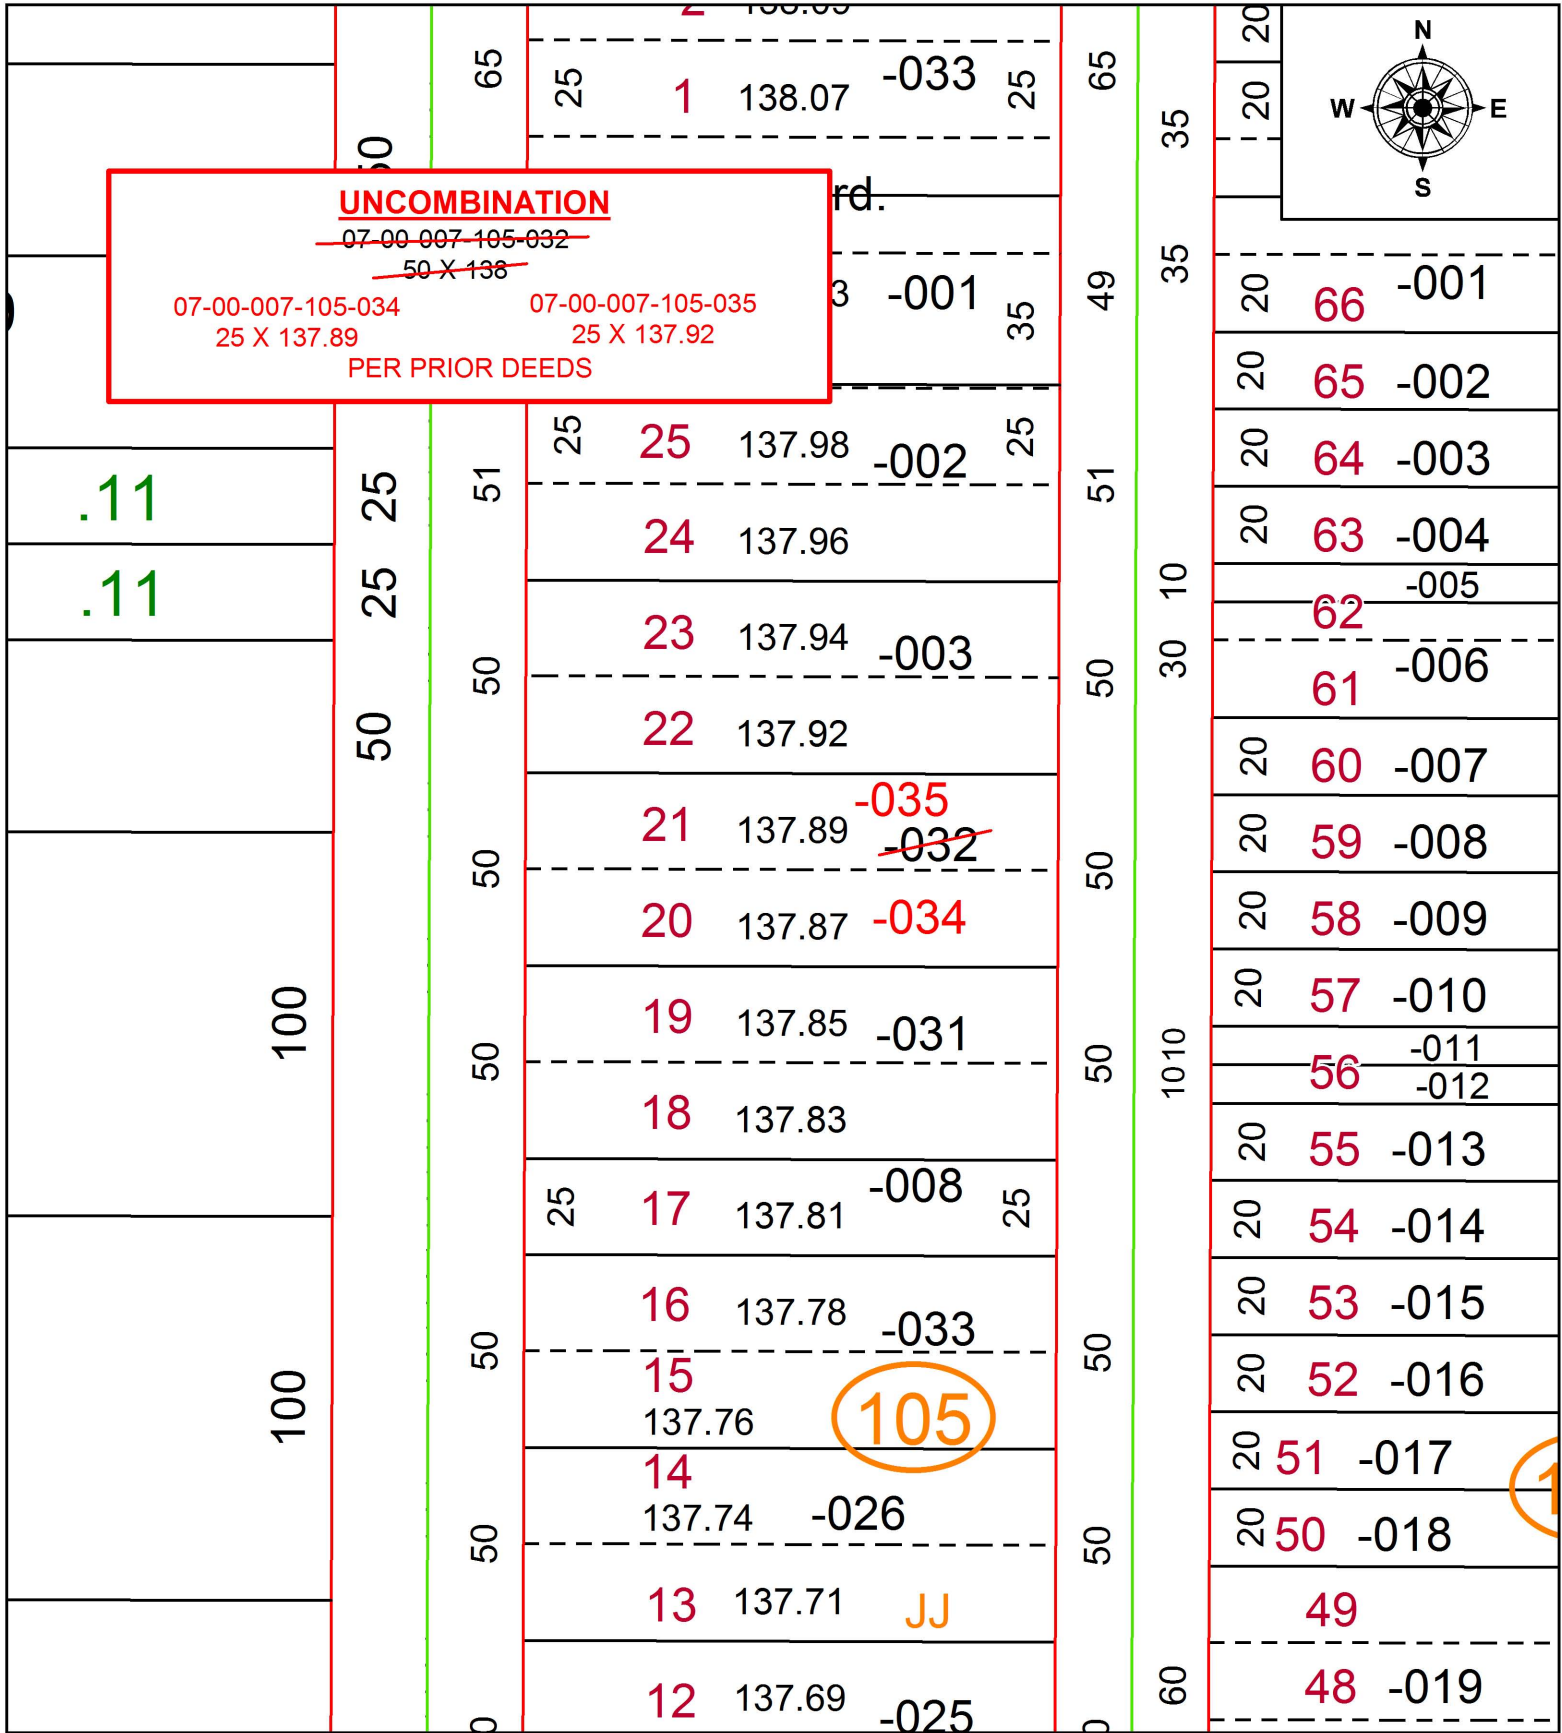

SPLITS/DEEDS PROCESSED
LORAIN COUNTY TAX MAP DEPARTMENT
226 MIDDLE AVE. ELYRIA, OH

SURVEYED BY: N/A
CLOSURE: N/A
MAP PAGE(S): 7-00-007
APPROVED BY: RRM DATE: 4-19-18
SCALE: 1" = 50 PRIOR INSTRUMENT: 20170624664