


PARENT PARCEL: 10-00-006-125-006, -028, -029


CHILD PARCEL: 10-00-006-125-041 THRU -043, 10-00-015-101-057 THRU -059

STARTING POINT: NORTHWEST CORNER OF BRENTWOOD ALLOTMENT NO. 4

18-03877

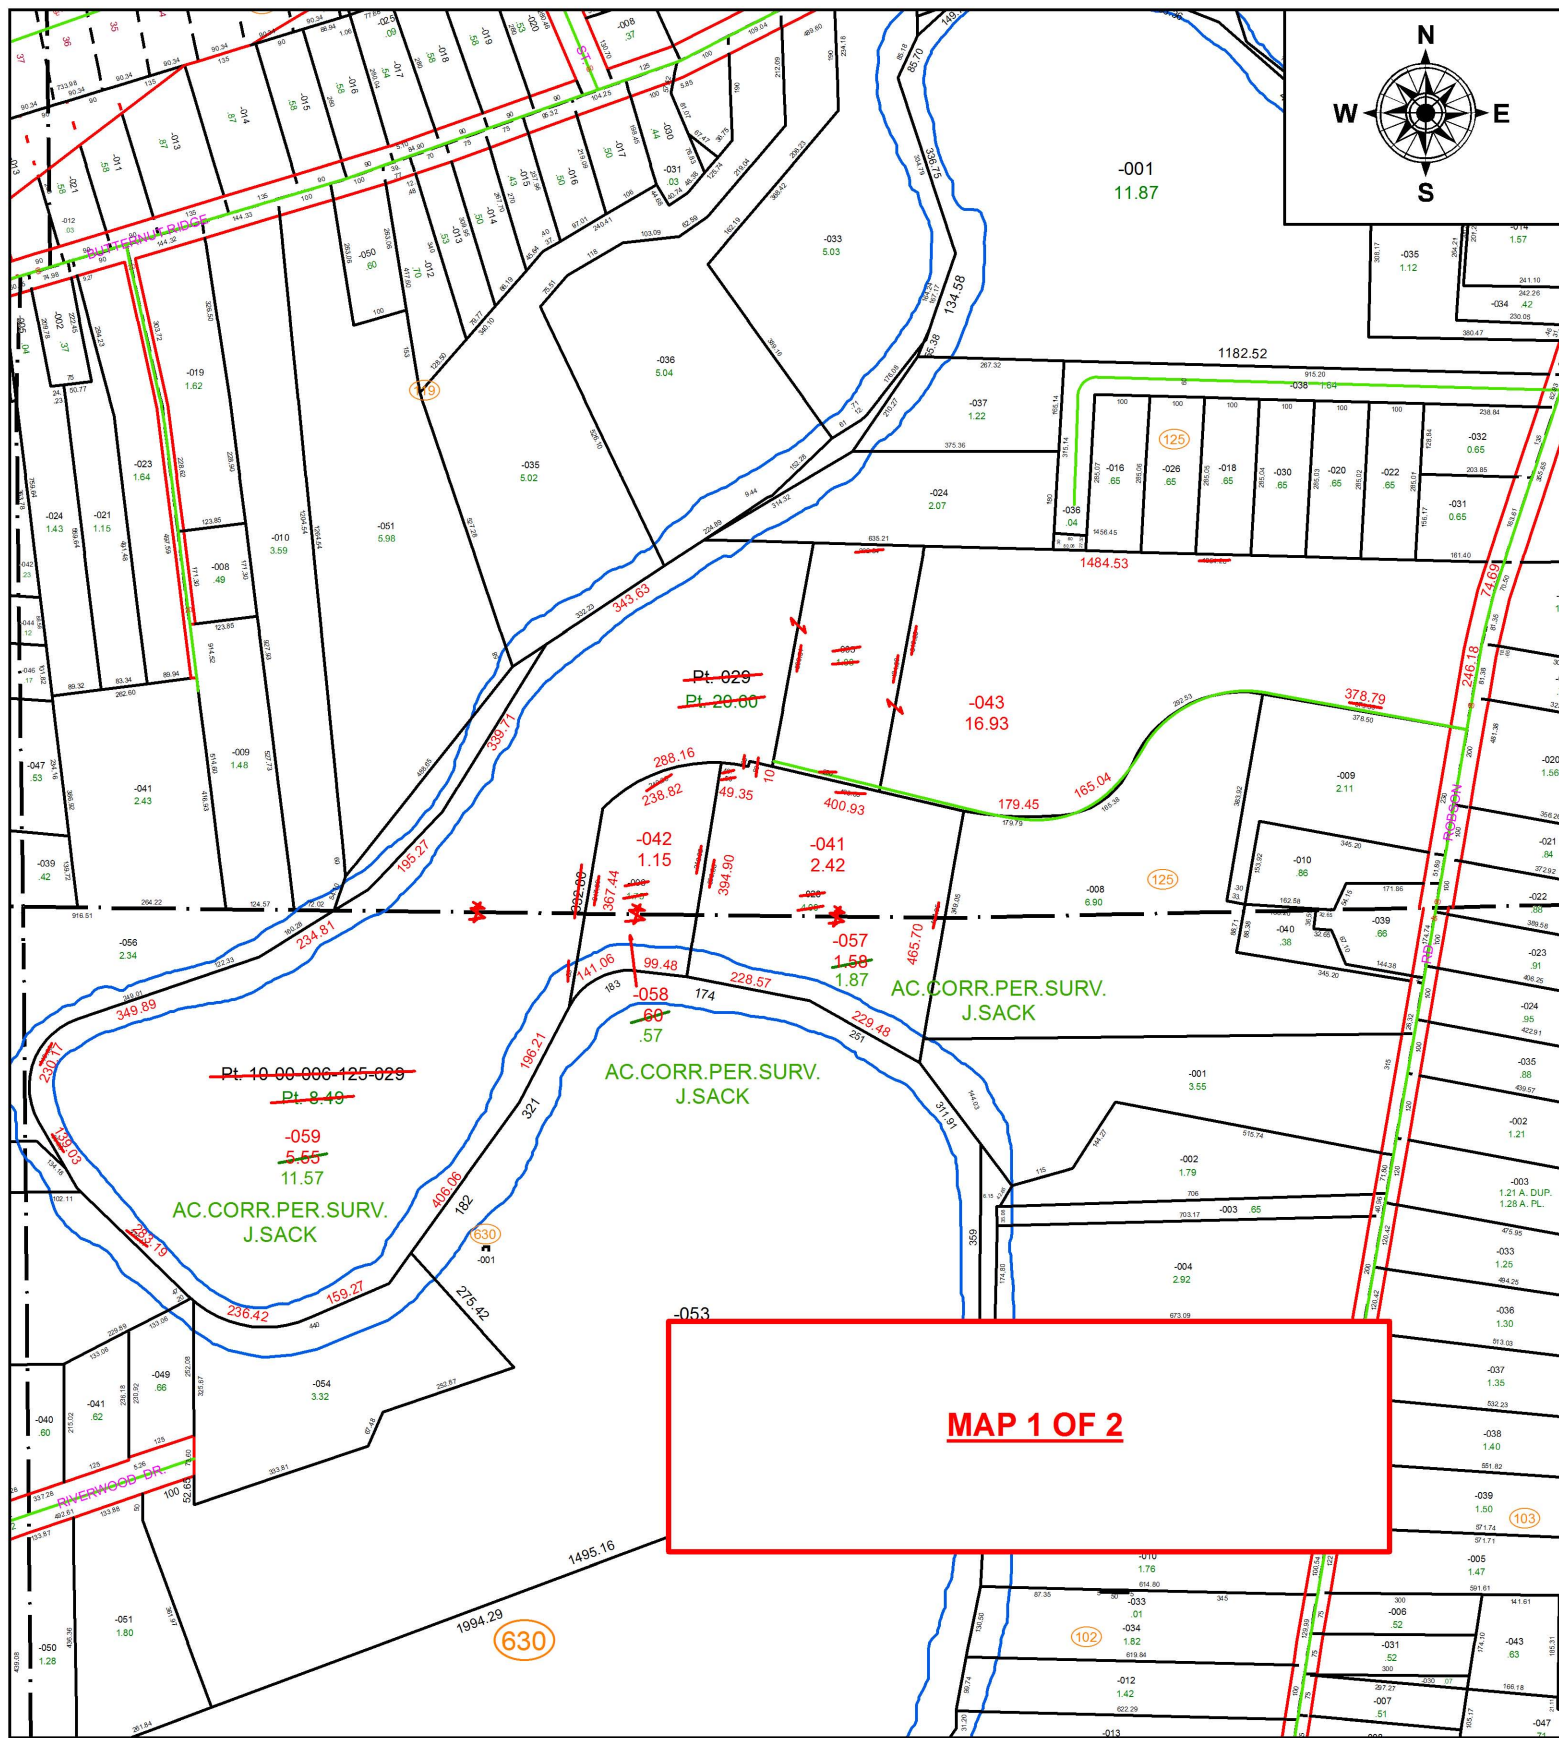

MAP 1 OF 2

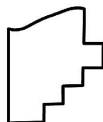

SPLITS/DEEDS PROCESSED
LORAIN COUNTY TAX MAP DEPARTMENT
226 MIDDLE AVE. ELYRIA, OH

SURVEYED BY: JEREMY M. SACK
CLOSURE: 1: 252,948
MAP PAGE(S): 10-00-006
APPROVED BY: RRM **DATE:** 10-1-18
SCALE: 1" = 350 **PRIOR INSTRUMENT:** 20160586637