


PARENT PARCEL: 03-00-098-126-033

CHILD PARCEL: 03-00-098-126-036, -037

STARTING POINT: S/L'S 49 & 50 IN HIGHLAND ADDITION

18-03877-U

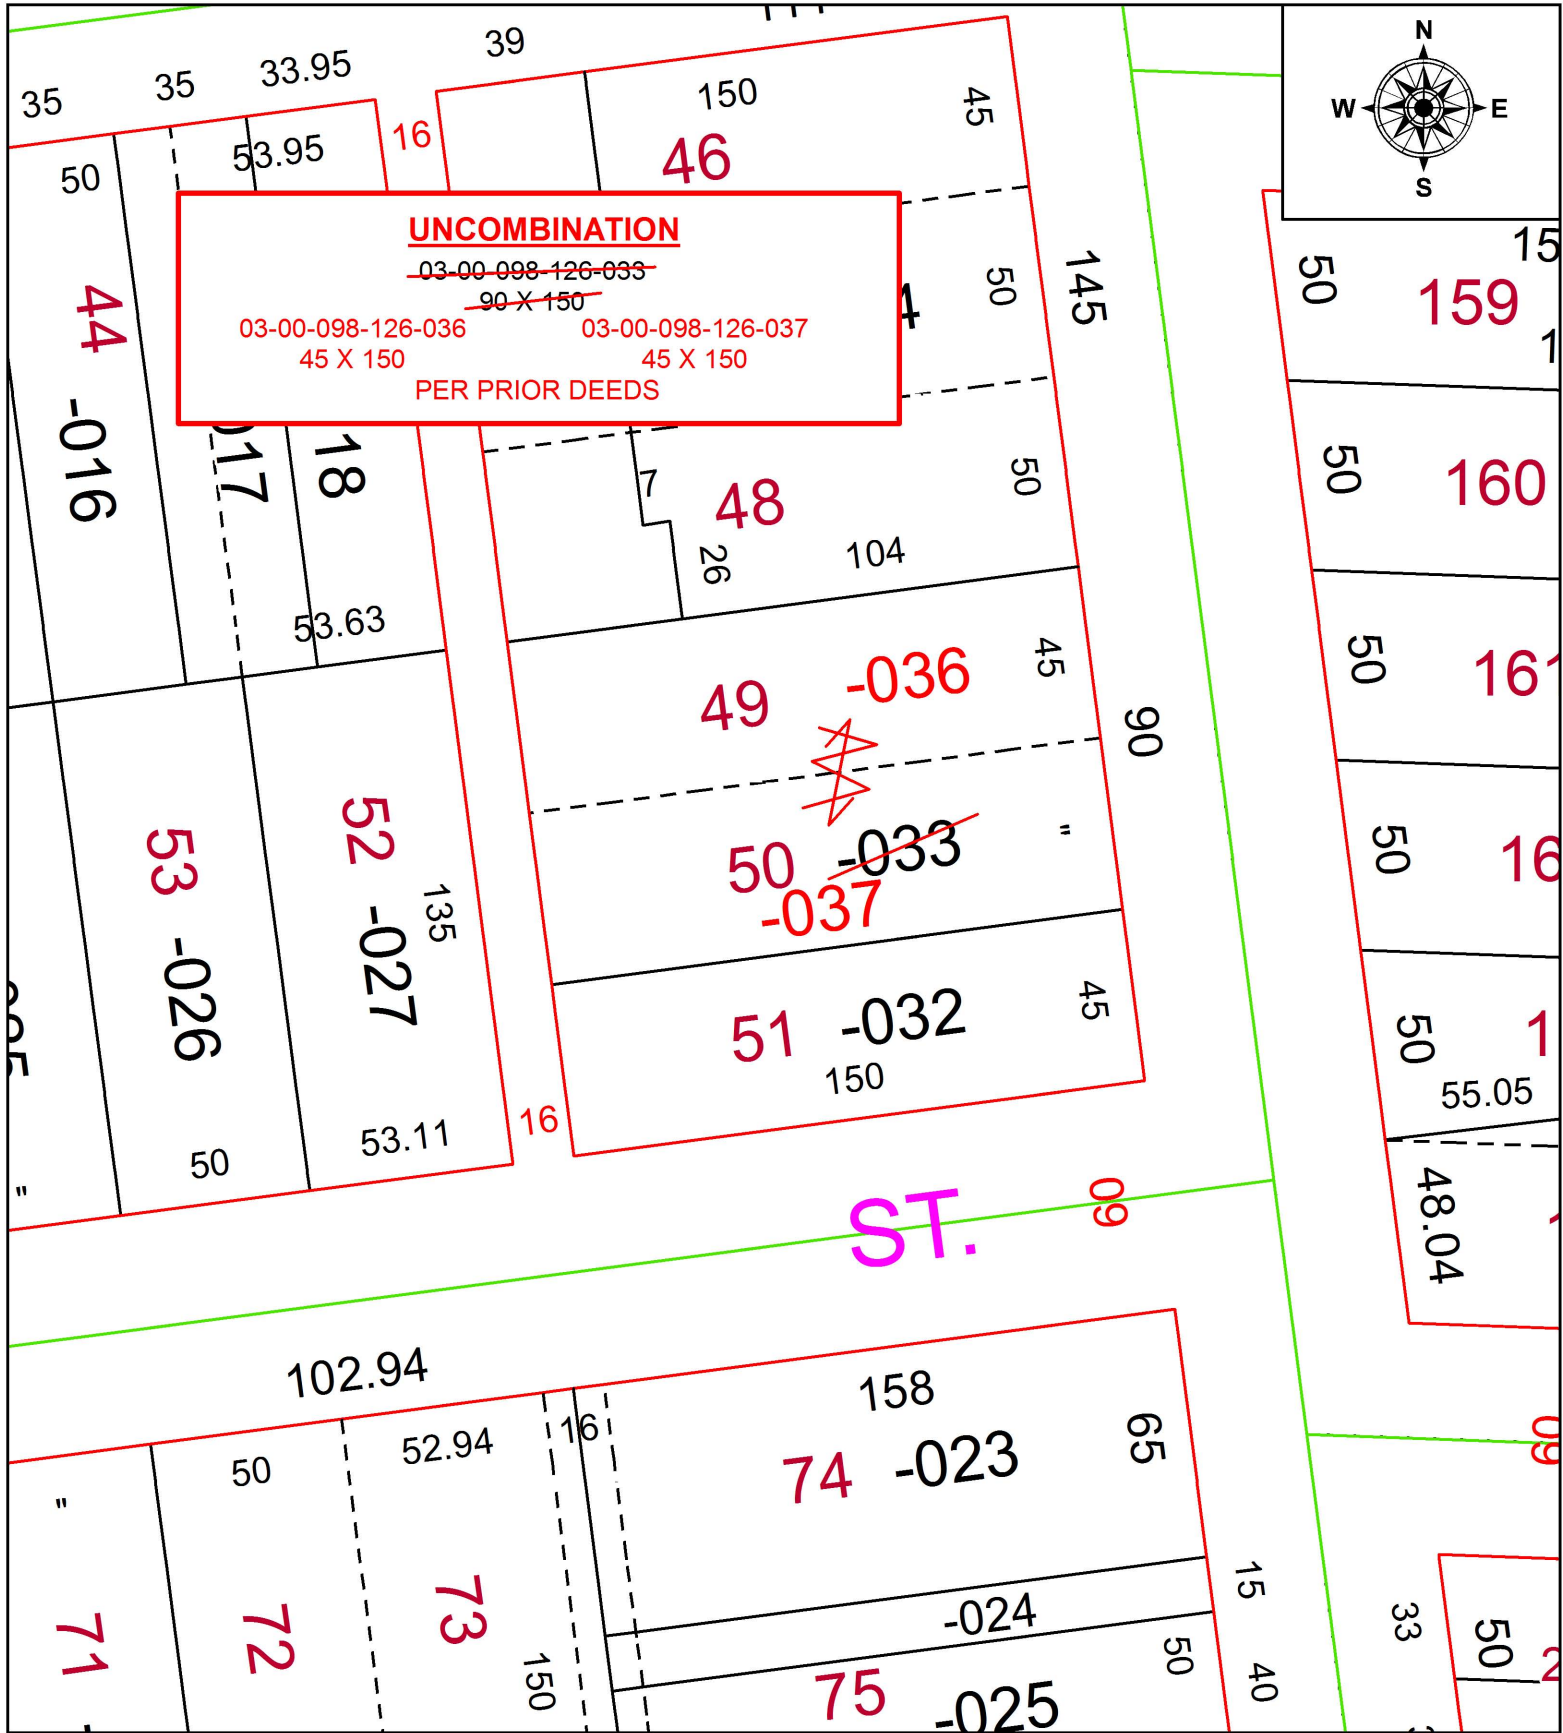

**SPLITS/DEEDS PROCESSED**

LORAIN COUNTY TAX MAP DEPARTMENT  
226 MIDDLE AVE. ELYRIA, OH

SURVEYED BY:	N/A
CLOSURE:	1: 2147483648
MAP PAGE(S):	3-00-098
APPROVED BY:	RRM DATE: 4-24-18
SCALE:	1" = 50
PRIOR INSTRUMENT:	20030909377