
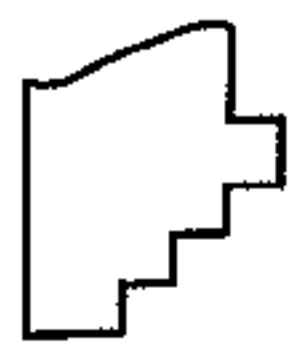


PARENT PARCEL: 10-00-006-125-006, -028, -029

CHILD PARCEL: 10-00-006-125-041 THRU -043, 10-00-015-101-057 THRU -059

STARTING POINT: NORTHWEST CORNER OF BRENTWOOD ALLOTMENT NO. 4

18-03877

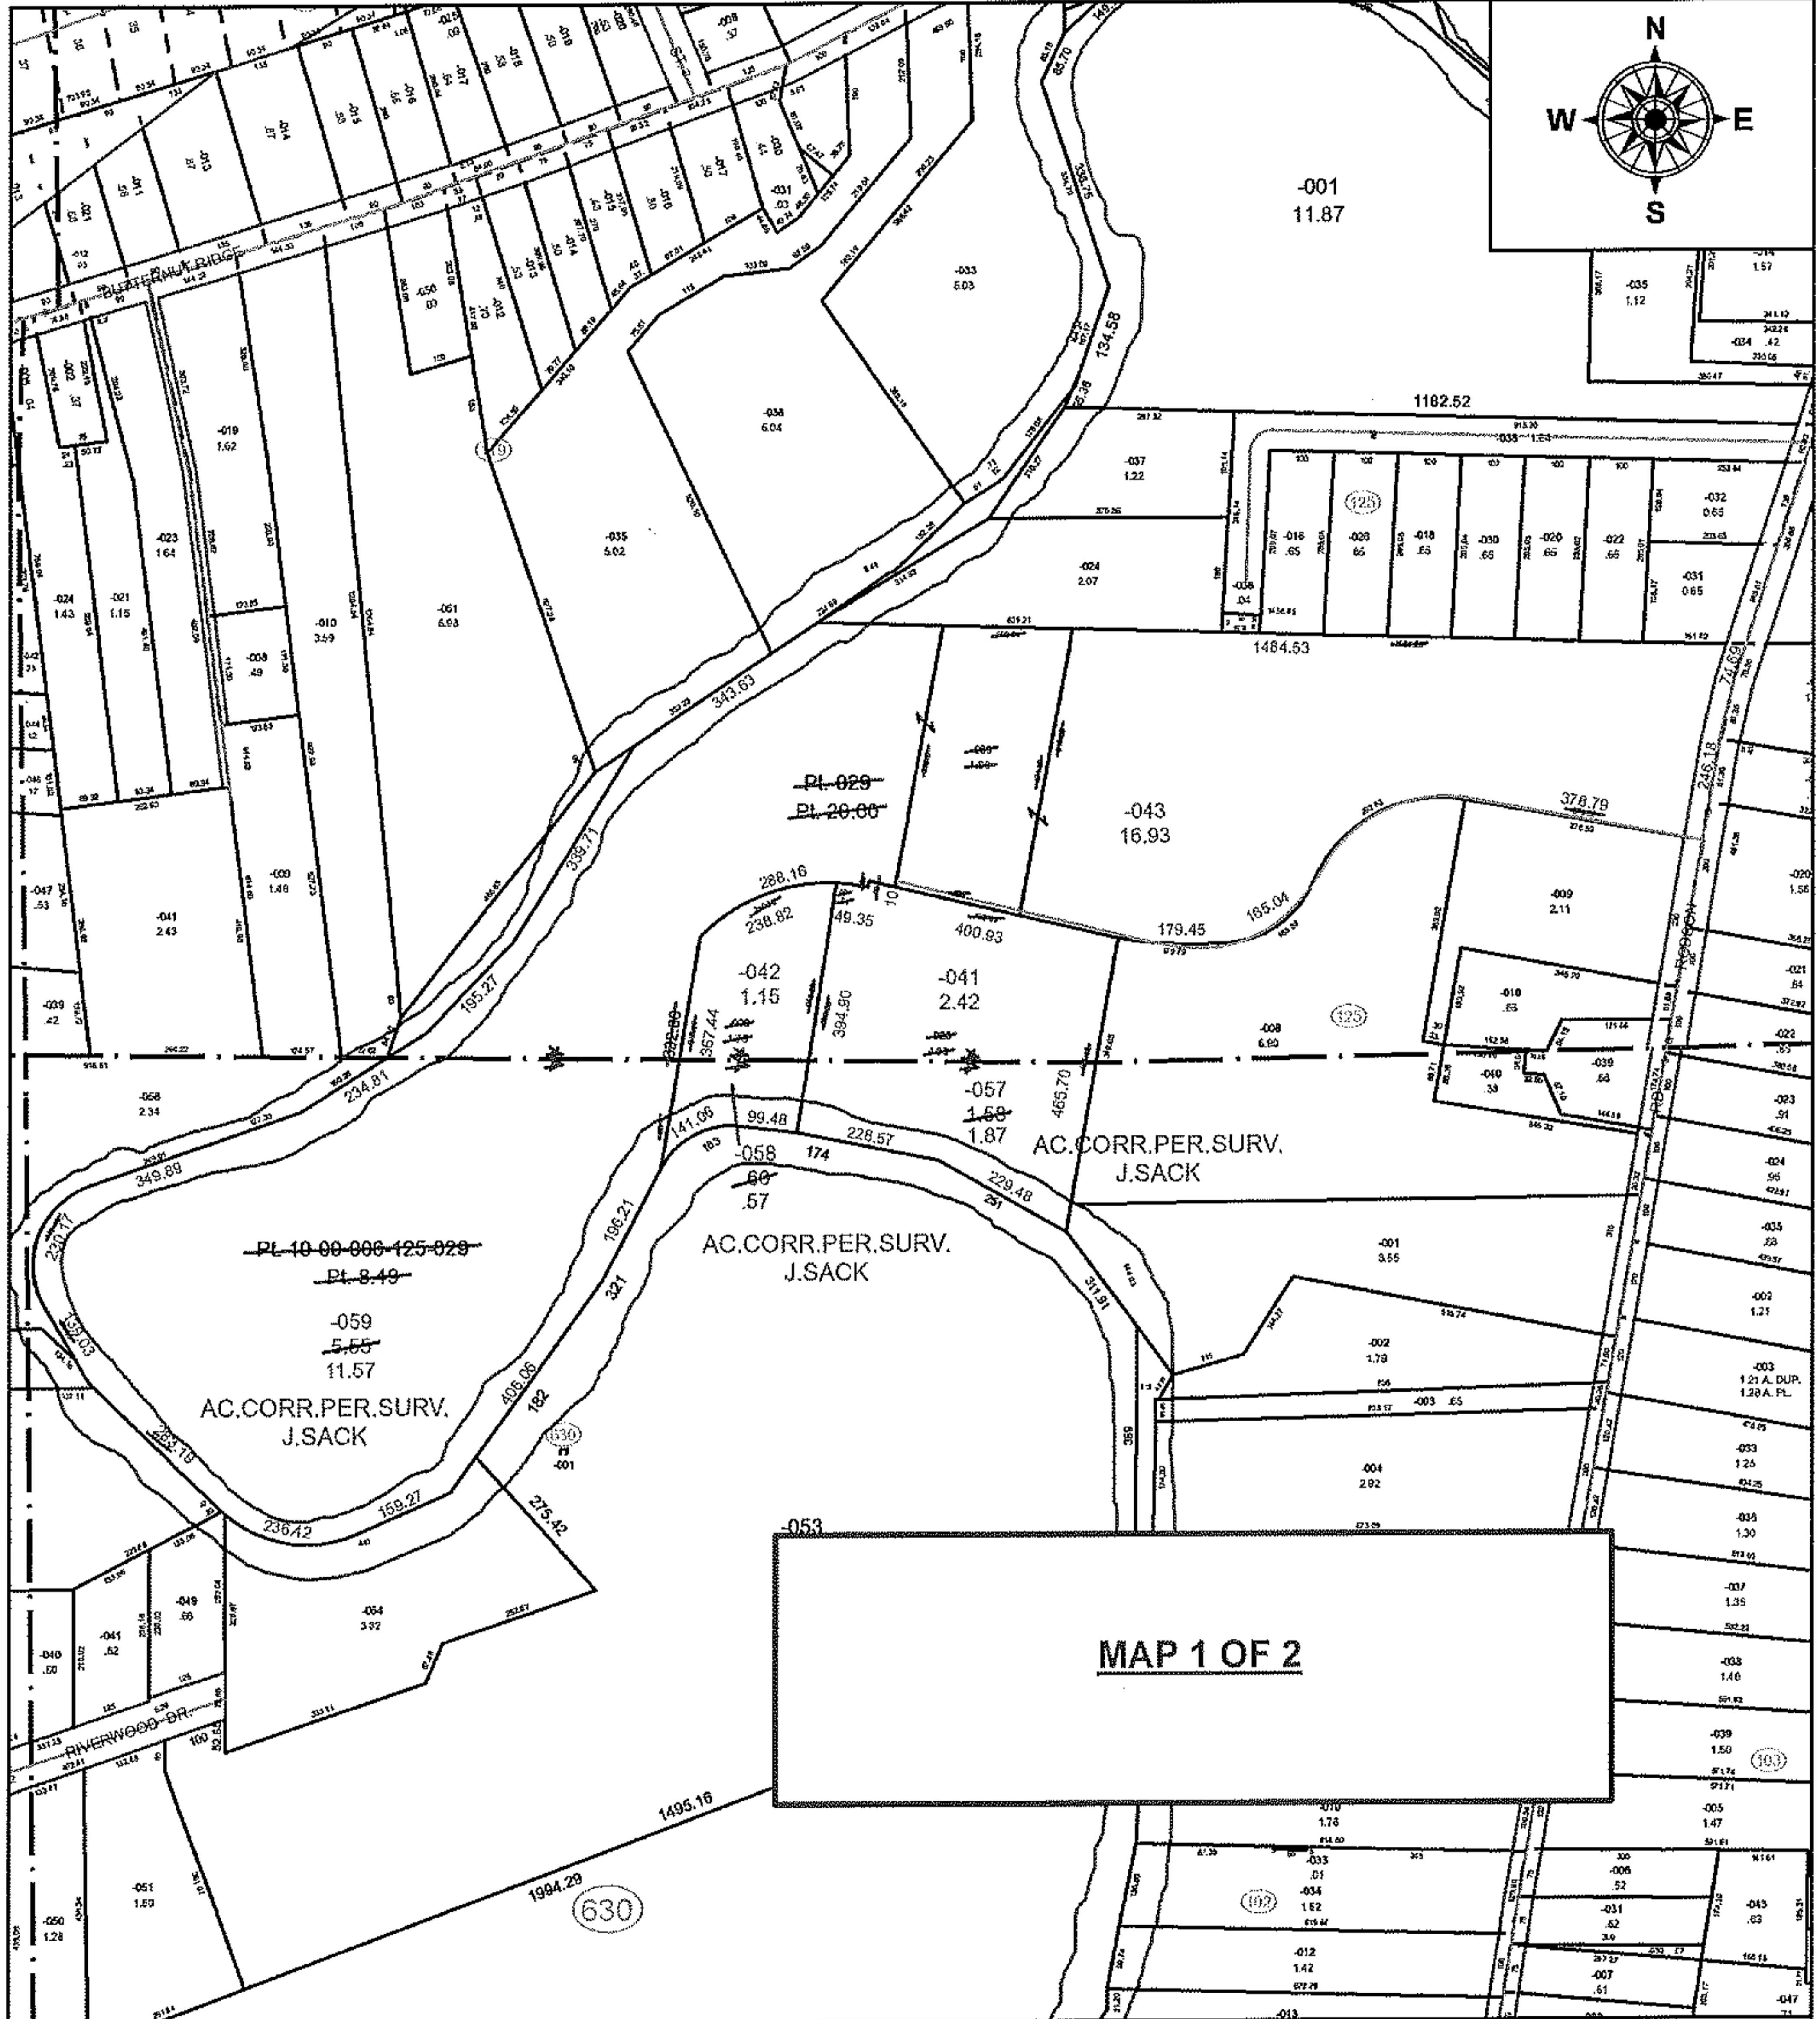

**SPLITS/DEEDS PROCESSED**  
 LORAIN COUNTY TAX MAP DEPARTMENT  
 226 MIDDLE AVE. ELYRIA, OH

SURVEYED BY: JEREMY M. SACK  
 CLOSURE: 1: 252,948  
 MAP PAGE(S): 10-00-006  
 APPROVED BY: RRM DATE: 10-1-18  
 SCALE: 1" = 350 PRIOR INSTRUMENT: 20160586637