


PARENT PARCEL: 07-00-020-138-029, -047

CHILD PARCEL: 07-00-020-138-048 THRU -050

STARTING POINT: NORTHWEST CORNER OF S/L 3 IN NORTHVIEW ALLOTMENT

18-03881

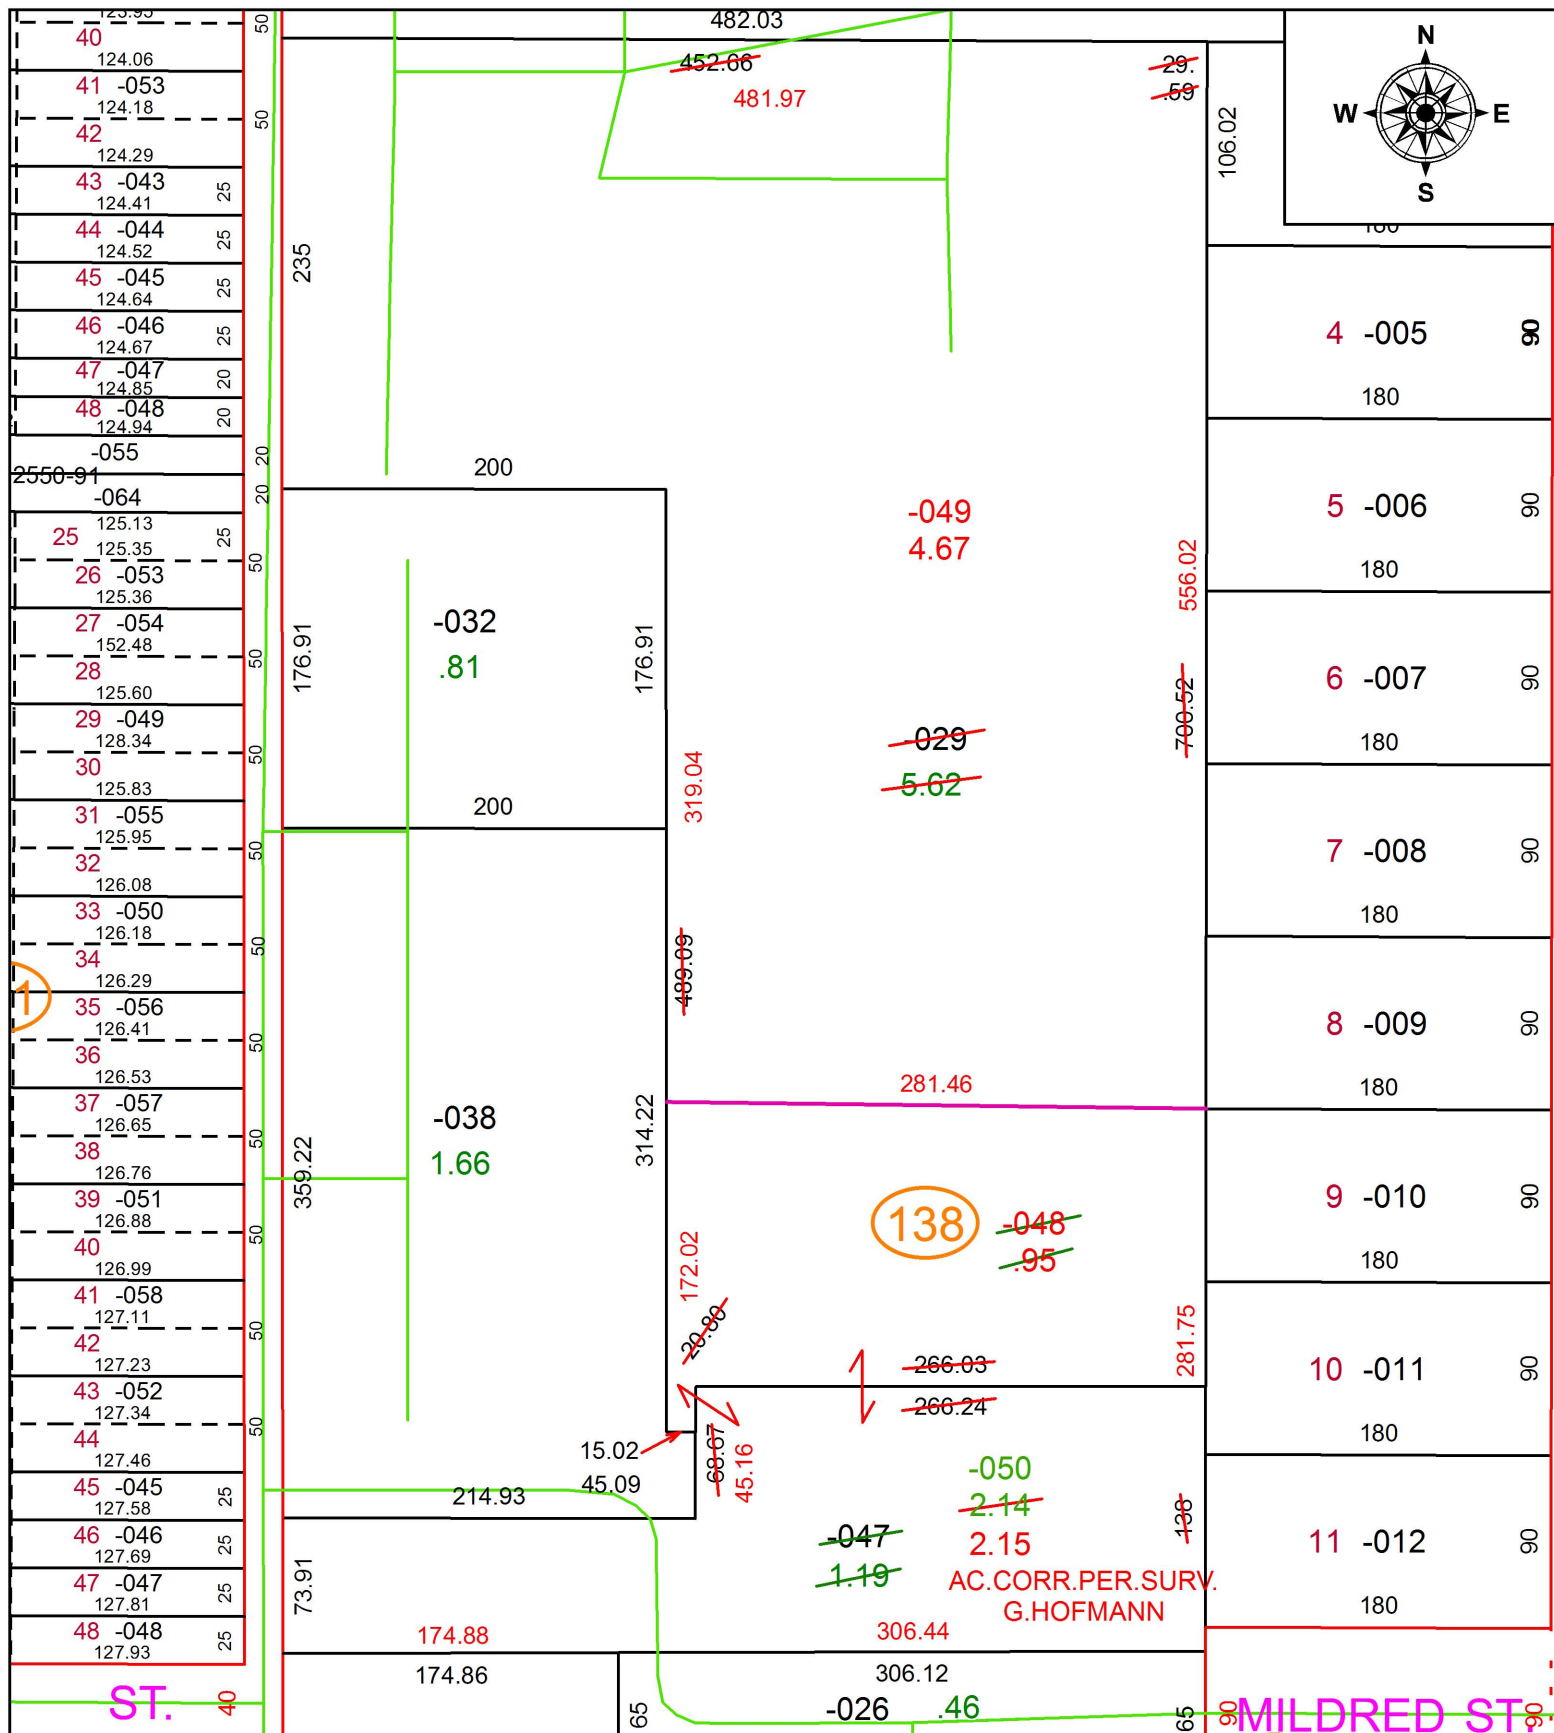

SPLITS/DEEDS PROCESSED
 LORAIN COUNTY TAX MAP DEPARTMENT
 226 MIDDLE AVE. ELYRIA, OH

SURVEYED BY: GEORGE HOFMANN
 CLOSURE: 1: 89,278
 MAP PAGE(S): 7-00-020
 APPROVED BY: RRM DATE: 10-2-18
 SCALE: 1" = 100 PRIOR INSTRUMENT: 20140500630