
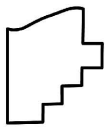


PARENT PARCEL: 06-24-009-108-023, 06-24-010-103-019, -020, 06-24-102-000-037

CHILD PARCEL: 06-24-009-108-023, 06-24-010-103-021, 06-24-102-000-038

18-03882-D

STARTING POINT: INTERSECTION OF SOUTH LINE OF WOODFORD AVE. AND WEST LINE OF GATEWAY BLVD

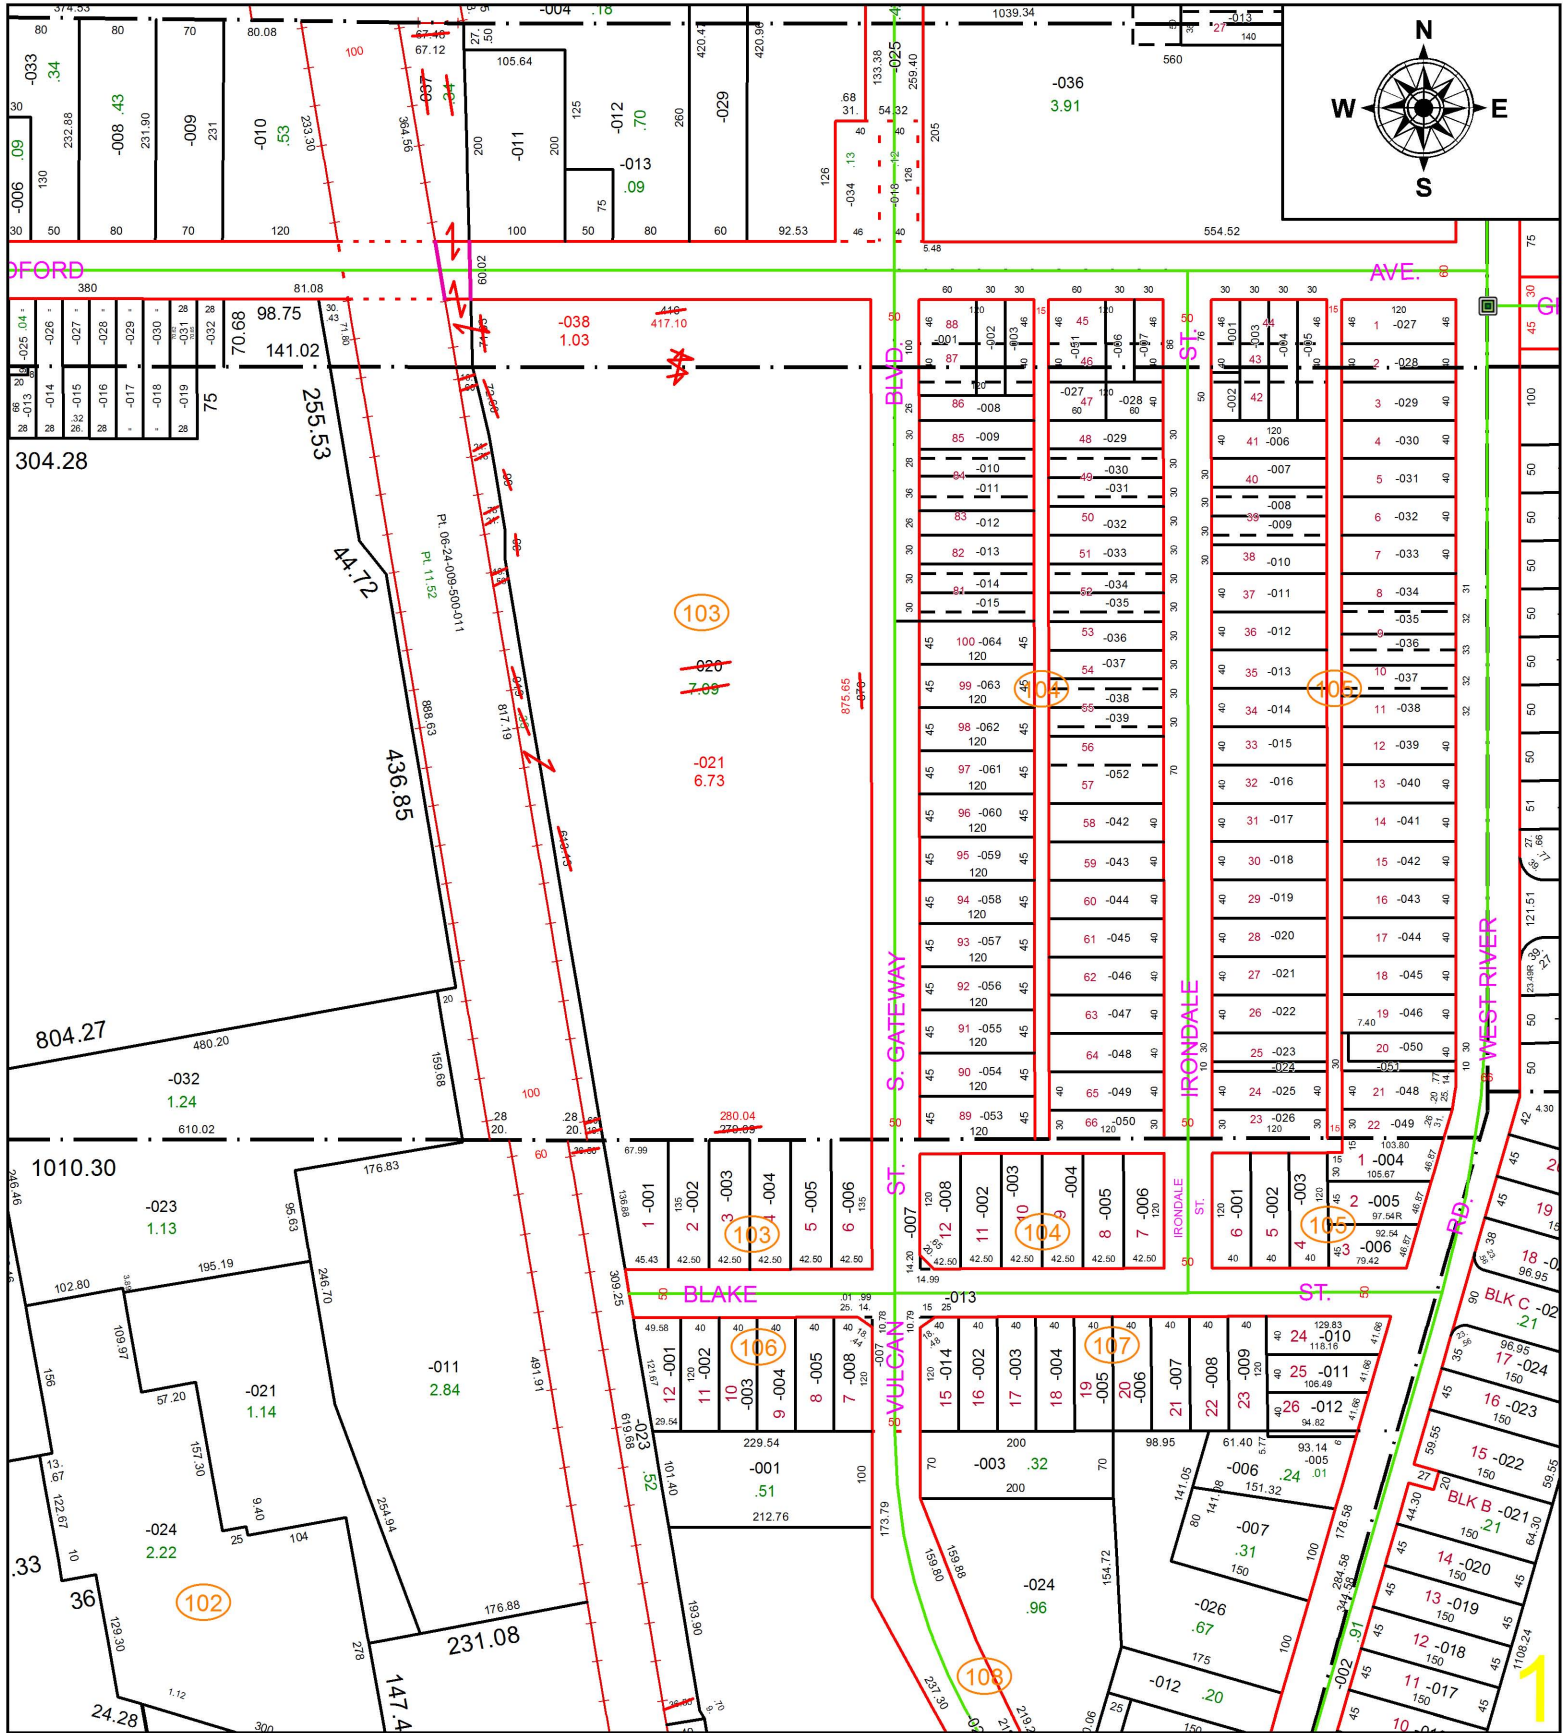

**SPLITS/DEEDS PROCESSED**  
 LORAIN COUNTY TAX MAP DEPARTMENT  
 226 MIDDLE AVE. ELYRIA, OH

**SURVEYED BY:** CHISTOPHER M. COOK  
**CLOSURE:** 1: 107,906  
**MAP PAGE(S):** 6-117  
**APPROVED BY:** RRM **DATE:** 5-3-18  
**SCALE:** 1" = 200 **PRIOR INSTRUMENT:** 20130467146