
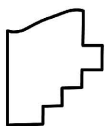


PARENT PARCEL: 01-00-036-000-049

CHILD PARCEL: 01-00-036-000-055, -056

STARTING POINT: INTERSECTION OF C/L OF COOPER FOSTER PARK RD. AND C/L OF SUNNYSIDE RD.

18-03890

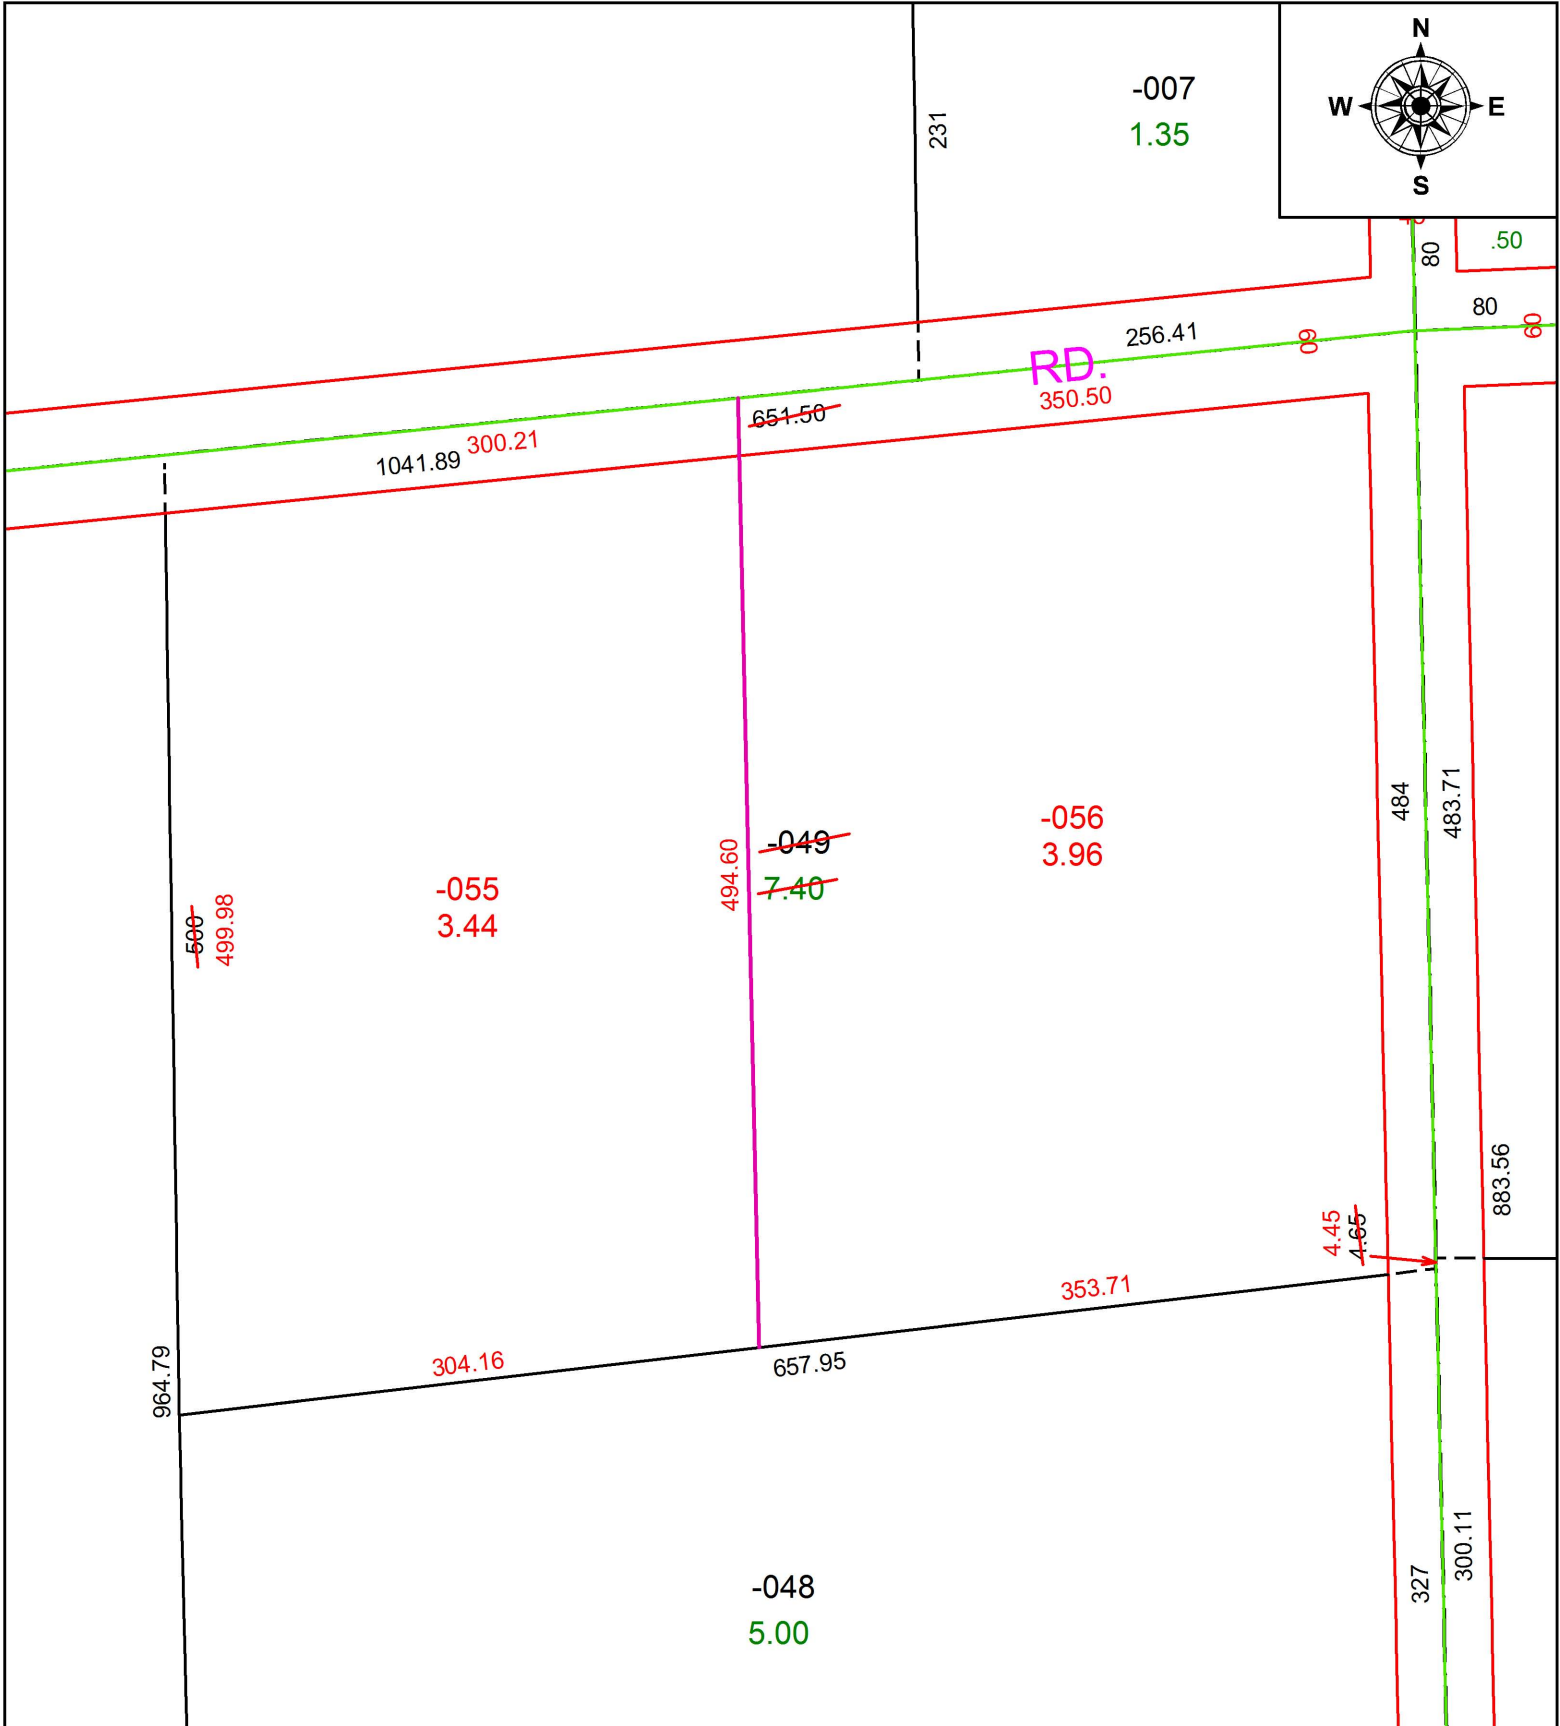

SPLITS/DEEDS PROCESSED
 LORAIN COUNTY TAX MAP DEPARTMENT
 226 MIDDLE AVE. ELYRIA, OH

SURVEYED BY: TIMOTHY D. HOZALSKI
 CLOSURE: 1: 212,159
 MAP PAGE(S): 1-00-036
 APPROVED BY: RRM DATE: 10-19-18
 SCALE: 1" = 100 PRIOR INSTRUMENT: 20170620508