


PARENT PARCEL: 07-00-013-000-120, -374, -443, 07-00-024-101-111

CHILD PARCEL: 07-00-013-000-469 THRU -474, 07-00-024-101-111

STARTING POINT: INTERSECTION OF C/L OF LORAIN RD. AND C/L OF ISLAND RD.

18-03891

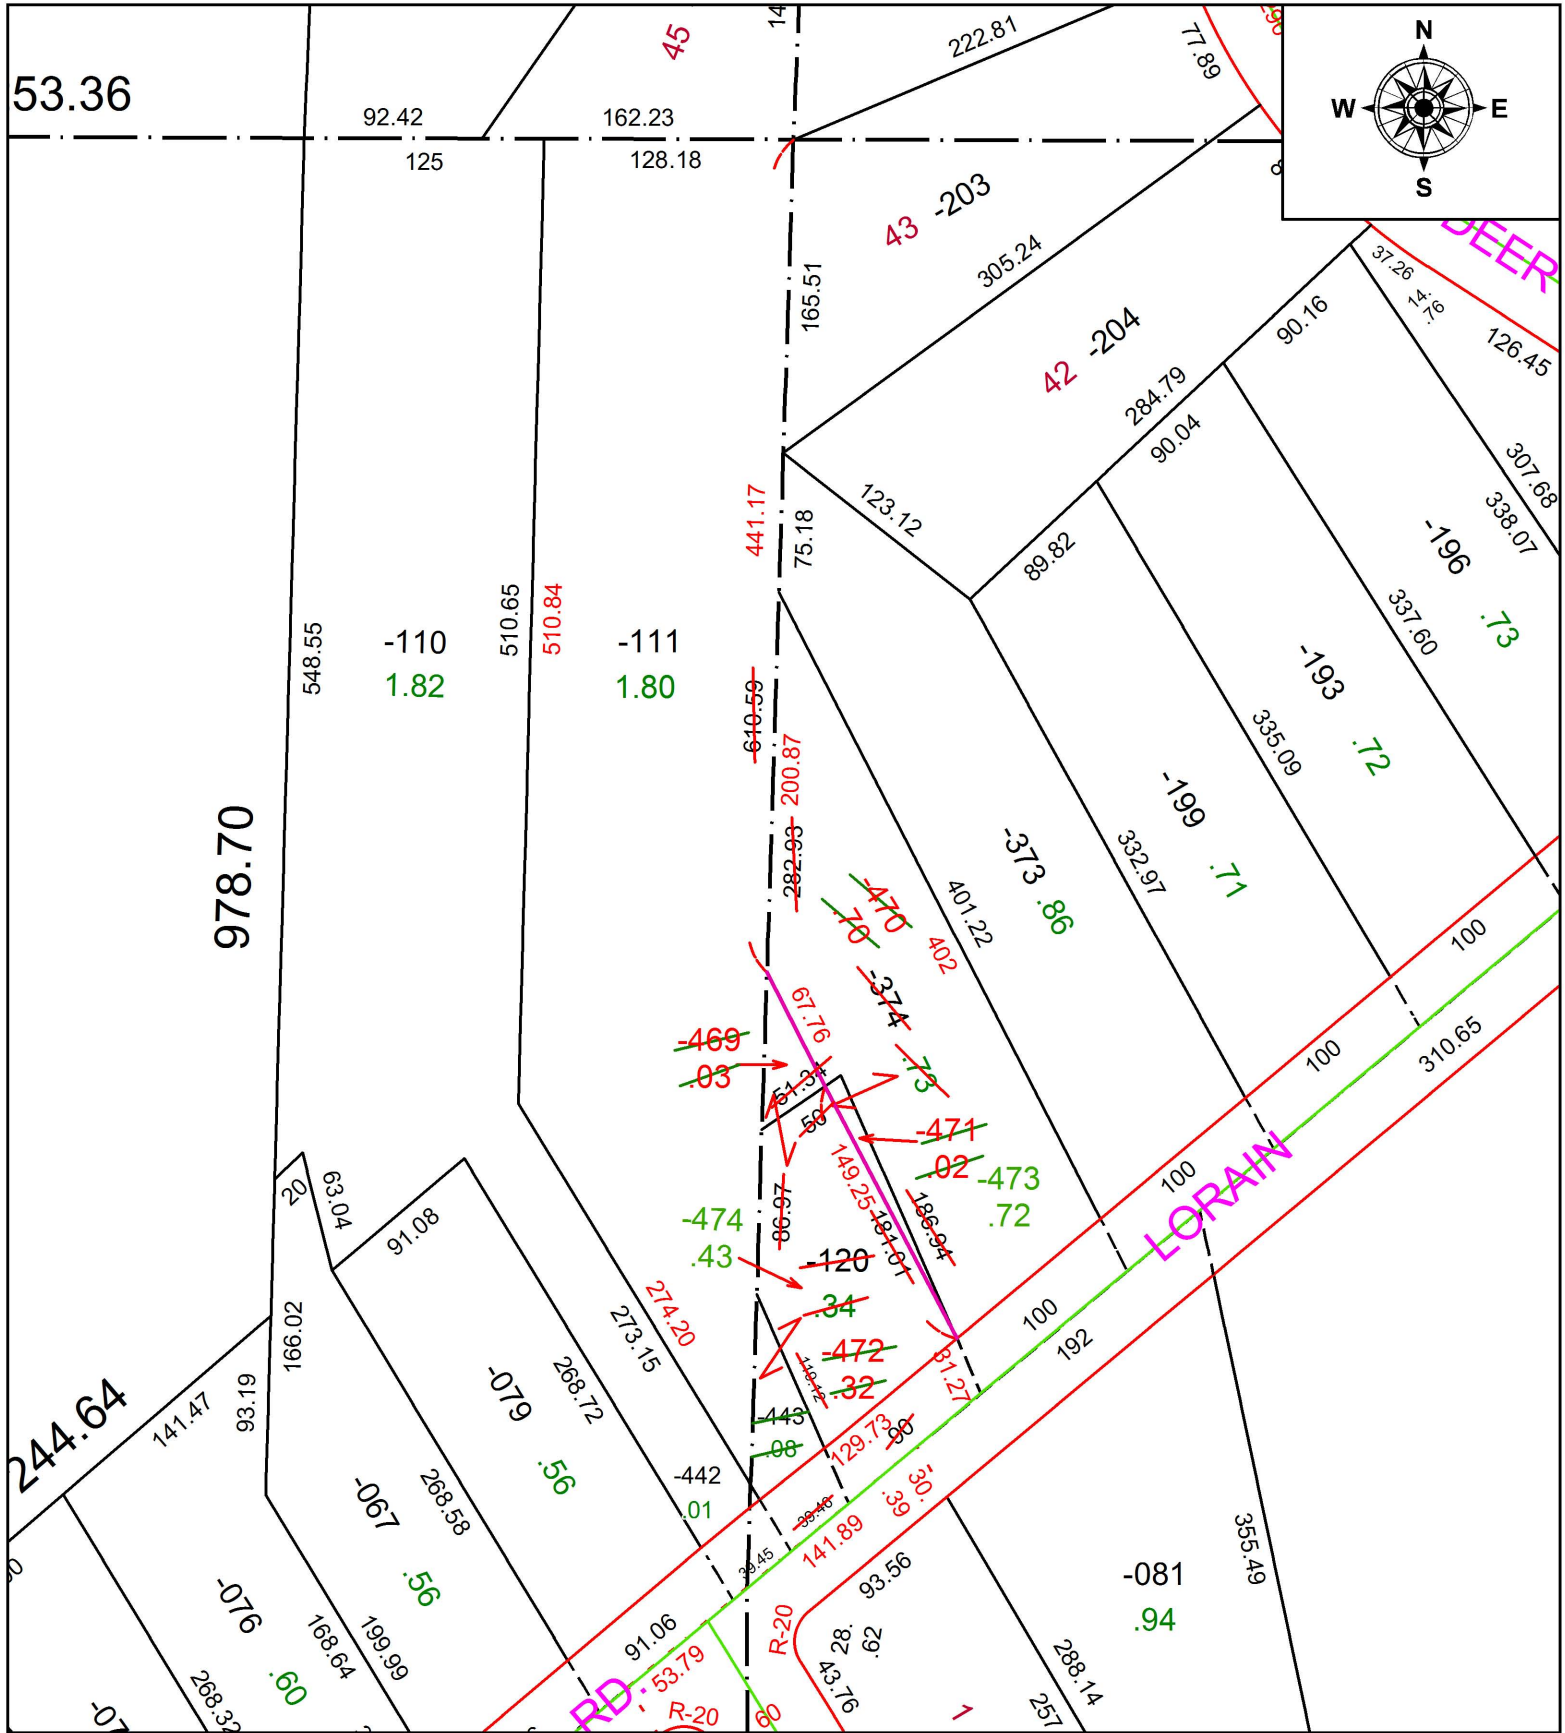

**SPLITS/DEEDS PROCESSED**  
 LORAIN COUNTY TAX MAP DEPARTMENT  
 226 MIDDLE AVE. ELYRIA, OH

SURVEYED BY: WILFREDO BARBOSA

CLOSURE: 1: 121,277

MAP PAGE(S): 7-00-013

APPROVED BY: RRM DATE: 10-30-18

SCALE: 1" = 100 PRIOR INSTRUMENT: 20060159270