
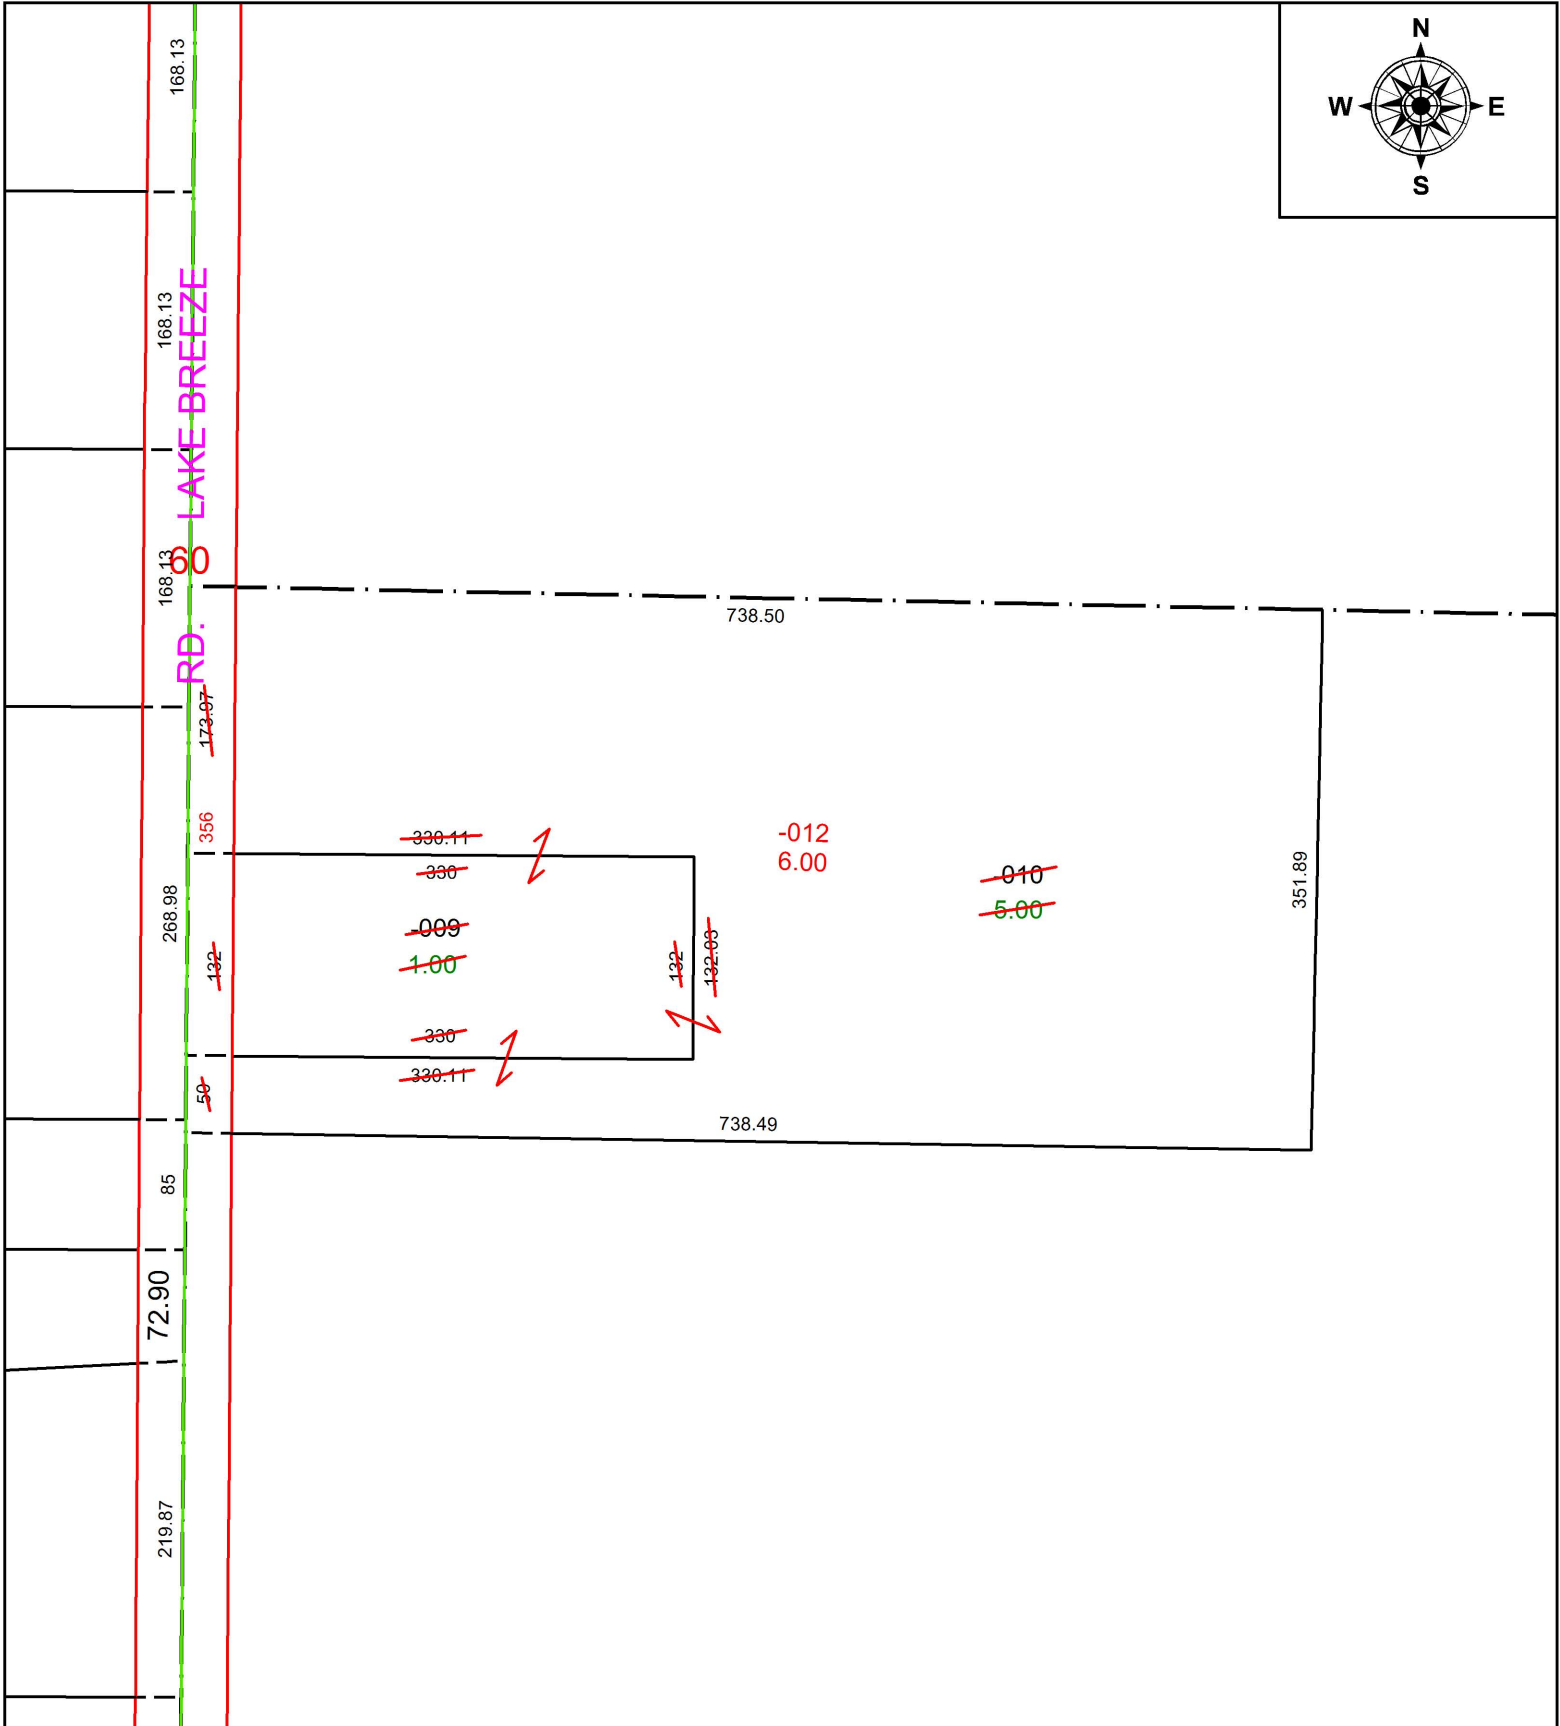


PARENT PARCEL: 03-00-028-000-009, -010

CHILD PARCEL: 03-00-028-000-012

STARTING POINT: NORTHWEST CORNER OF O.L.28

18-03900

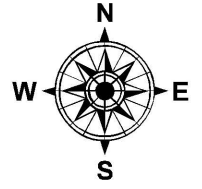

SPLITS/DEEDS PROCESSED
 LORAIN COUNTY TAX MAP DEPARTMENT
 226 MIDDLE AVE. ELYRIA, OH

SURVEYED BY: BRENT D. ANDERSON

CLOSURE: 1: 536,839

MAP PAGE(S): 3-00-028

APPROVED BY: RRM DATE: 11-6-18

SCALE: 1" = 125 PRIOR INSTRUMENT: 20170645932