
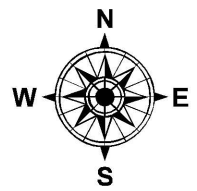


PARENT PARCEL: 05-00-098-000-107, -108

CHILD PARCEL: 05-00-003-106-030, -031, 05-00-098-000-147, -148

STARTING POINT: INTERSECTION OF C/L OF QUARRY RD, AND C/L OF MILAN AVE.

18-03905

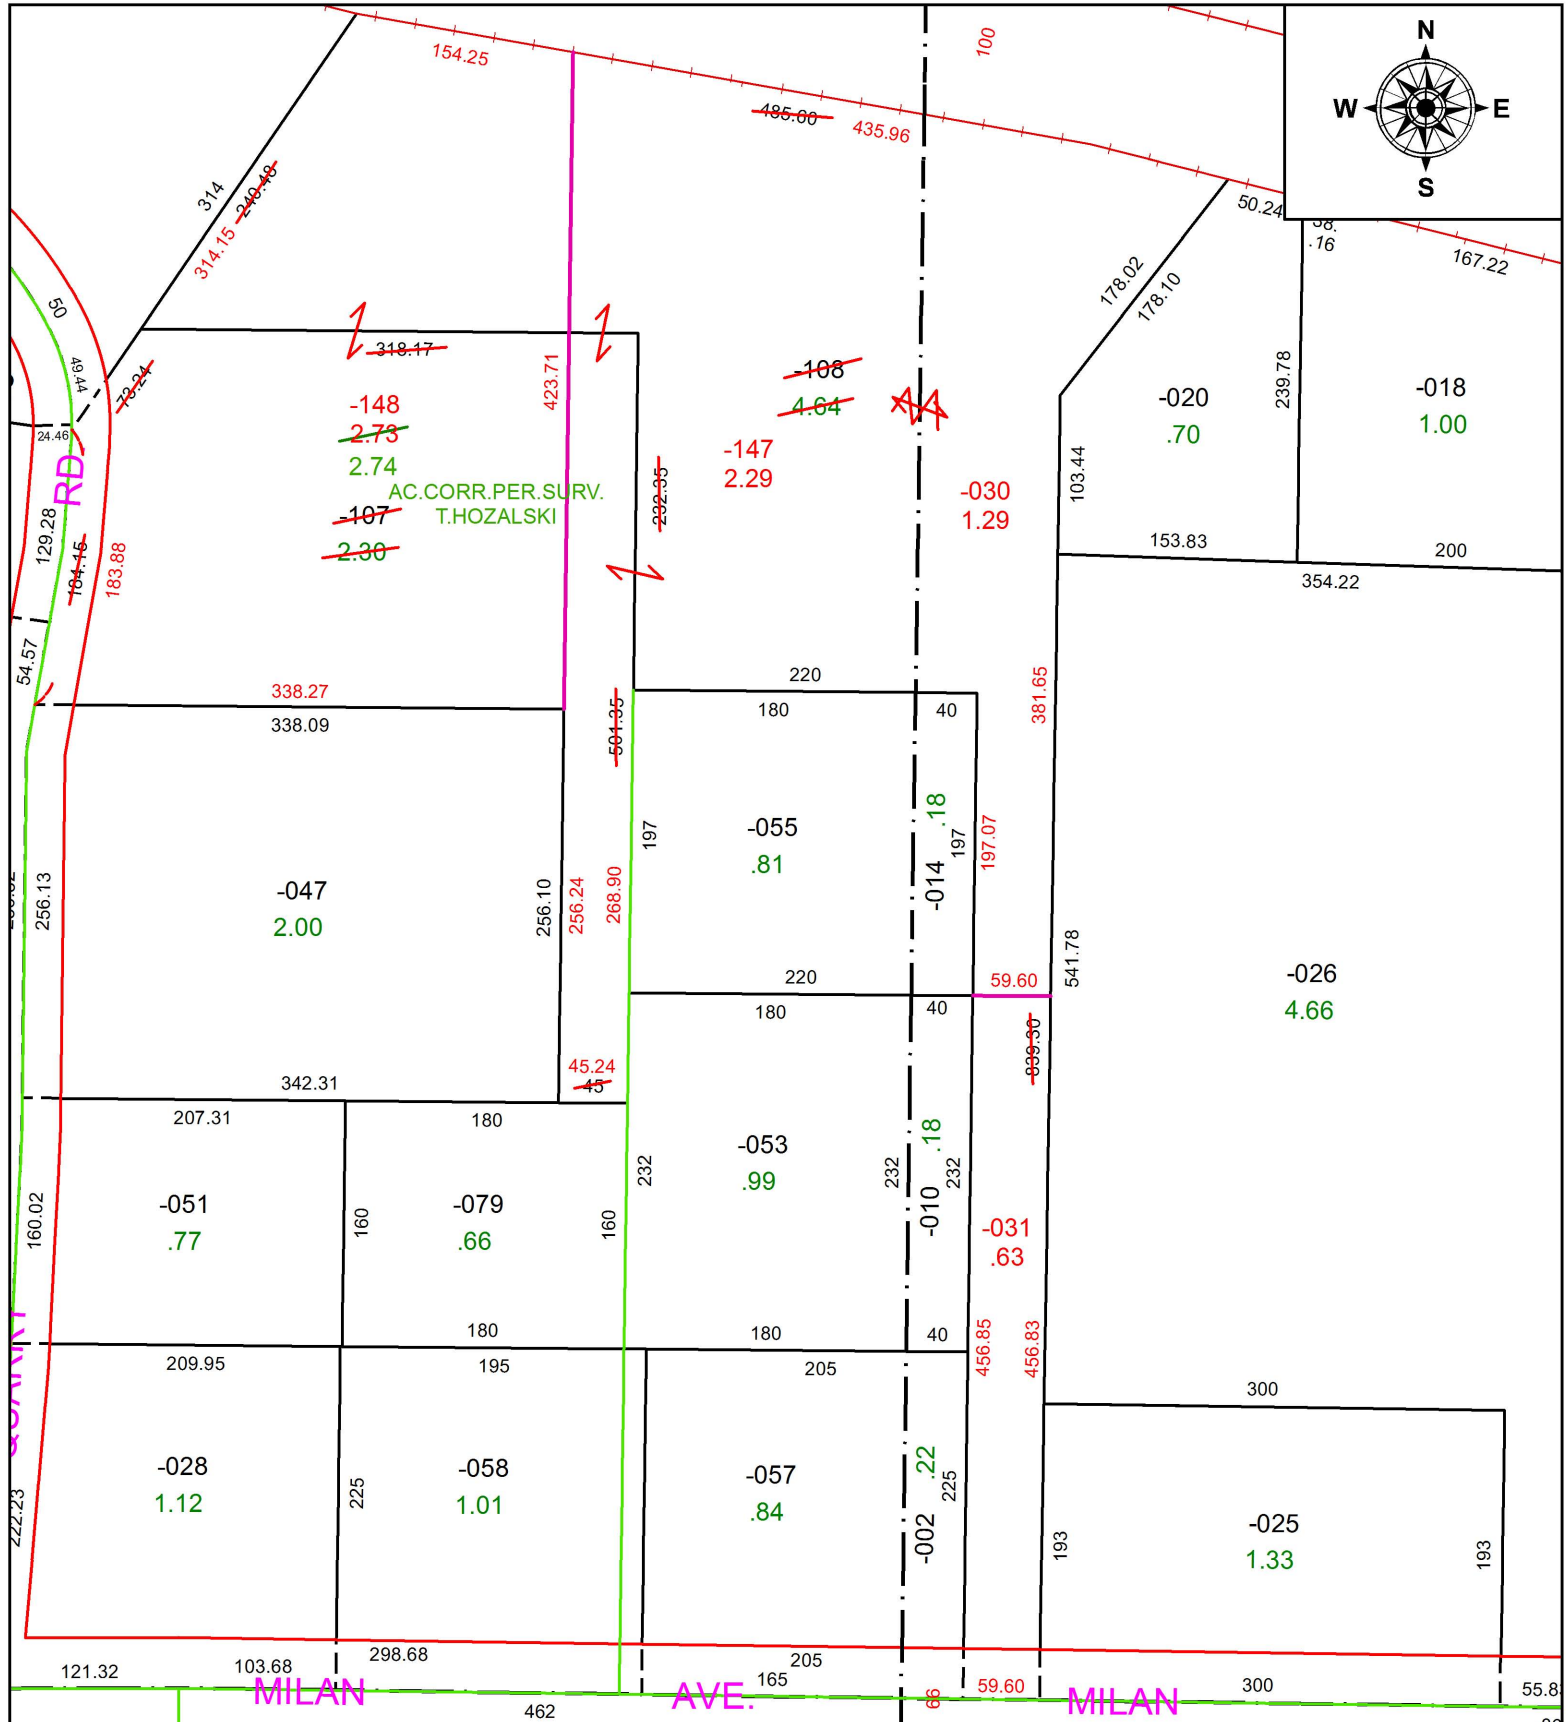

SPLITS/DEEDS PROCESSED
 LORAIN COUNTY TAX MAP DEPARTMENT
 226 MIDDLE AVE. ELYRIA, OH

SURVEYED BY: TIMOHTY D. HOZALSKI
 CLOSURE: 1: 142,741
 MAP PAGE(S): 5-00-098
 APPROVED BY: RRM DATE: 11-13-18
 SCALE: 1" = 125 PRIOR INSTRUMENT: 20020807327