

PARENT PARCEL: 07-00-029-900-006


CHILD PARCEL: CERTIFICATE OF CORRECTION PV. 105 PG. 7-13

STARTING POINT: XXXXXX

18-03907-C

CERTIFICATE OF CORRECTION

~~YALE COURT DRIVE~~
YALE COURT
PV. 105 PG. 7-13

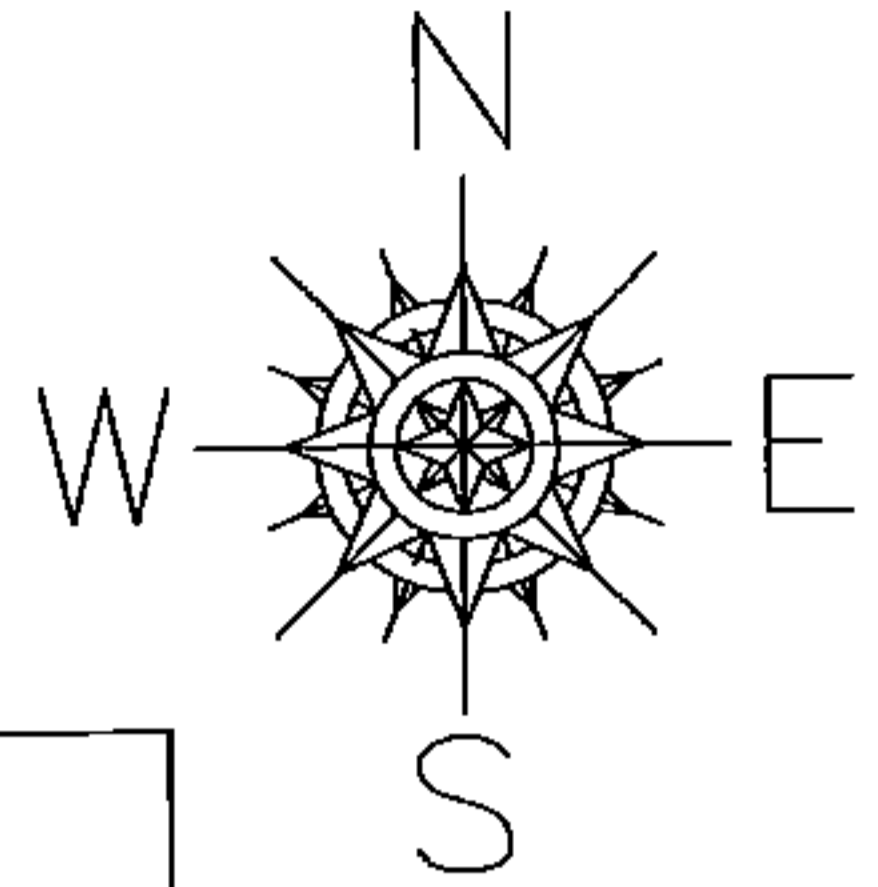

CERTIFICATE OF CORRECTION

This is to certify that subsequent to recording of Hampton Place Subdivision No. 4 as recorded in Volume 105, Pages 7-13 of Lorain County Plat Records, the street name shown as "Yale Court Drive" dedicated by this plat has been changed to "Yale Court".

Ehtesham M. Suhail, PS
Registered Surveyor No. 7806
Suhail & Suhail, Inc.
18405 May Court
Chagrin Falls, OH 44023
440-223-9142



STATE OF OHIO SS
CUYAHOGA COUNTY

Before me, a Notary Public in and for said County and State, did personally appear the above named Ehtesham M. Suhail, who acknowledged that he did sign the foregoing instrument and that the same is his free act and deed.

IN TESTIMONY THEREOF, I have hereunto set my hand and official seal at Westlake, Ohio, this 7th day of June, 2018.

This instrument prepared by:
EHTESHAM M. SUHAIL



Maria Cecilia Olsou
Notary Public, State of Ohio
My Commission Expires March 7, 2021

SPLITS/DEEDS PROCESSED

LORAIN COUNTY TAX MAP DEPARTMENT
226 MIDDLE AVE. ELYRIA, OHIO

SURVEYED BY: E. SUHAIL

CLOSURE: NA

MAP PAGE(S): 07-00-029

APPROVED BY: TJS DATE: 6/14/18

SCALE: 1"=100 PRIOR INST.: DV XXXX/XXX