
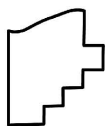


PARENT PARCEL: 15-00-056-103-022

CHILD PARCEL: **ACREAGE CORRECTION 64 X 93.72 IRR. TO 0.13 A.**

STARTING POINT: DRILL HOLE CL OF SR. 303 (MAIN ST.) & CL OF SR. 301 (CENTER ST.)

18-03913-D

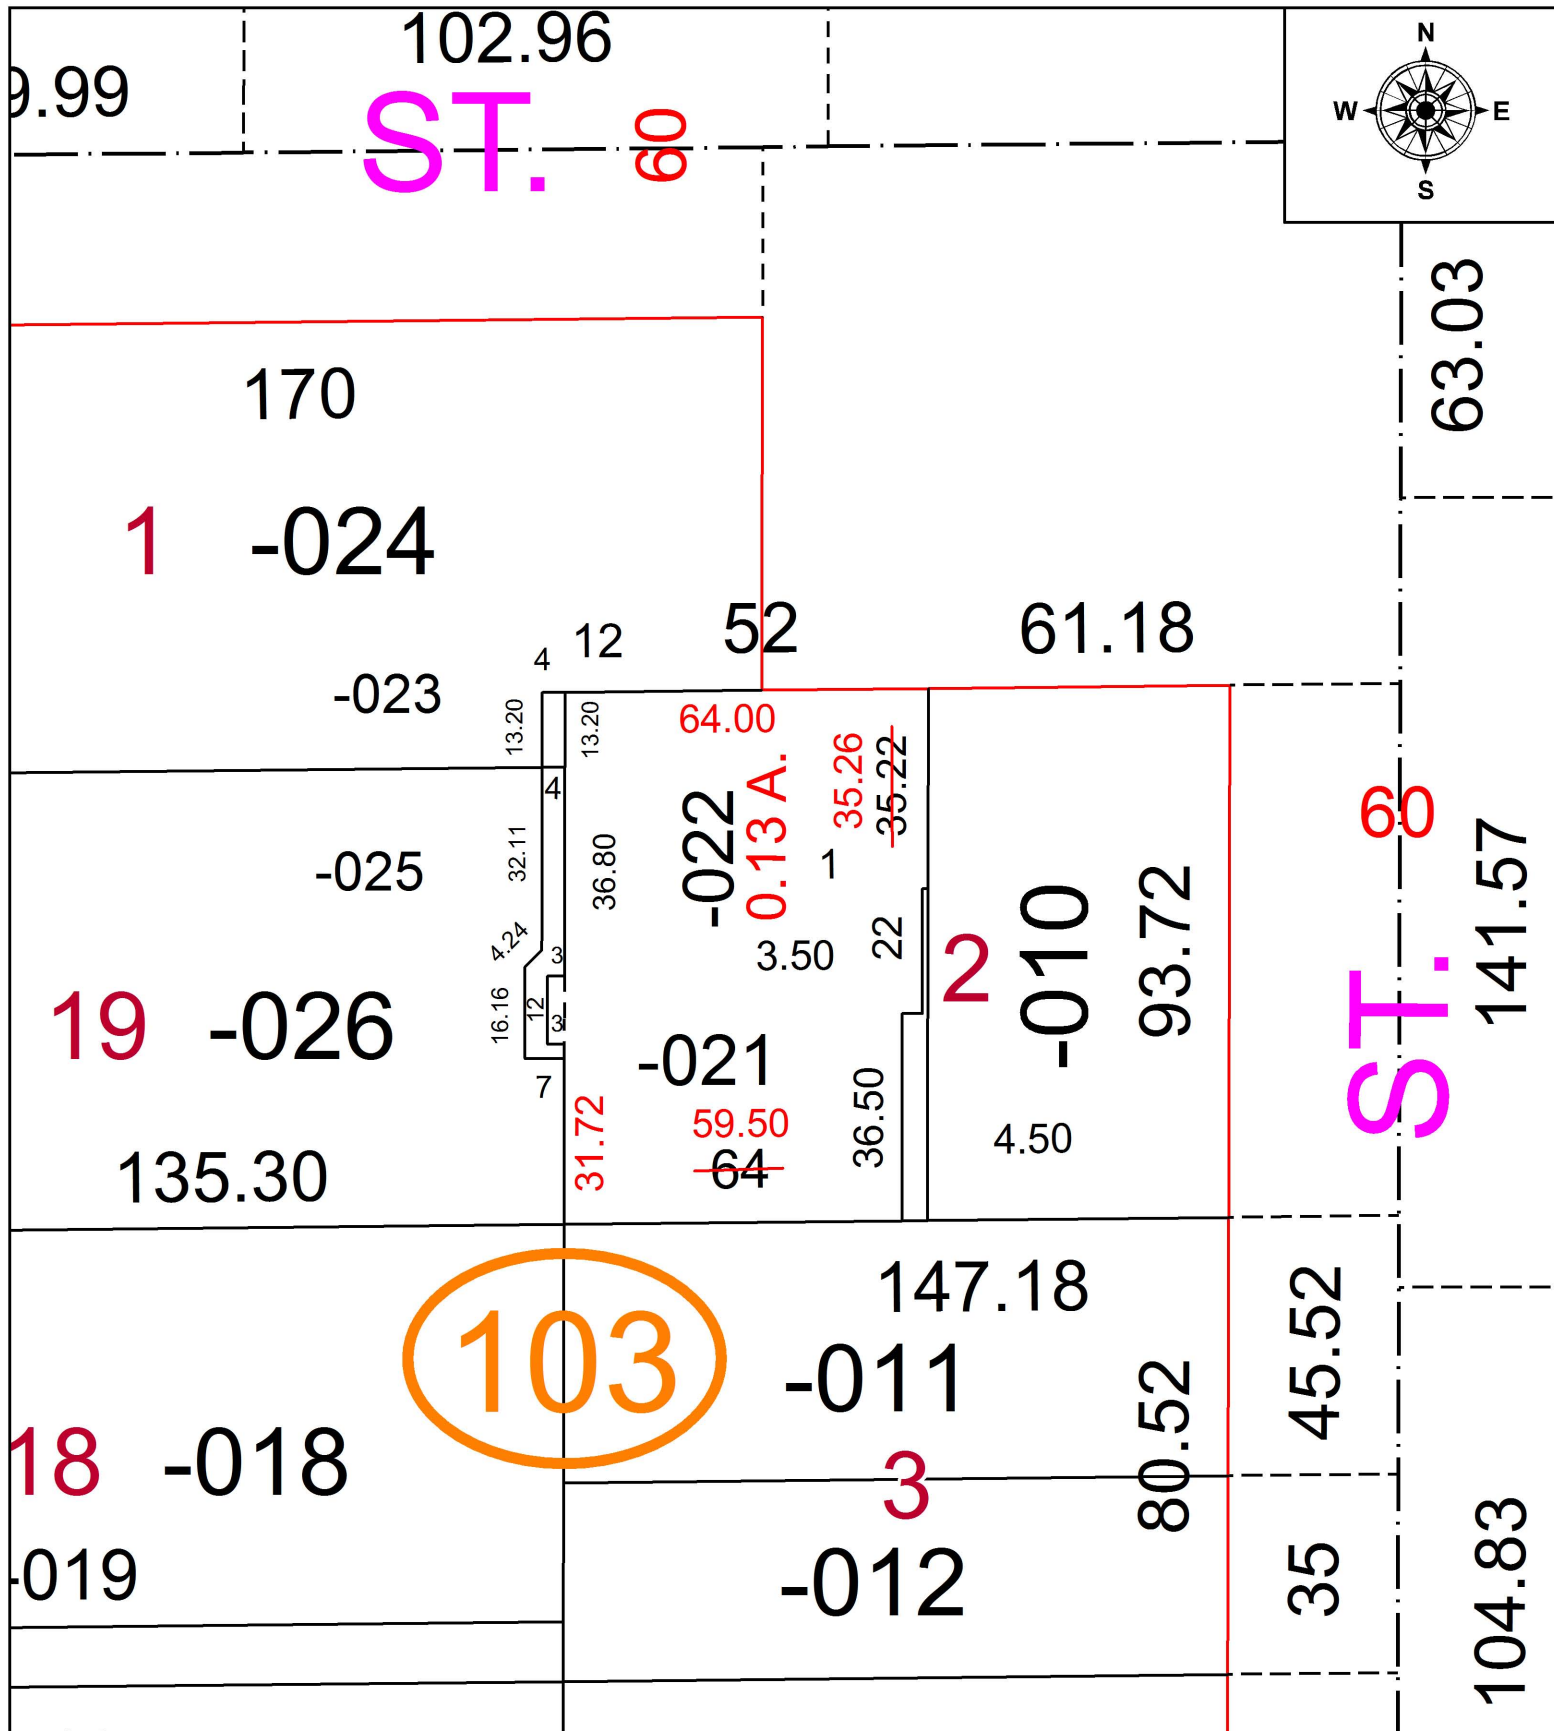

SPLITS/DEEDS PROCESSED
LORAIN COUNTY TAX MAP DEPARTMENT
226 MIDDLE AVE. ELYRIA, OH

SURVEYED BY:	AMY KELLY
CLOSURE:	1: 33,000
MAP PAGE(S):	15-00-056
APPROVED BY:	TJS DATE: 6/26/18
SCALE:	1" = 20' PRIOR INSTRUMENT: 1997-0470690