
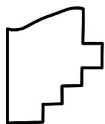
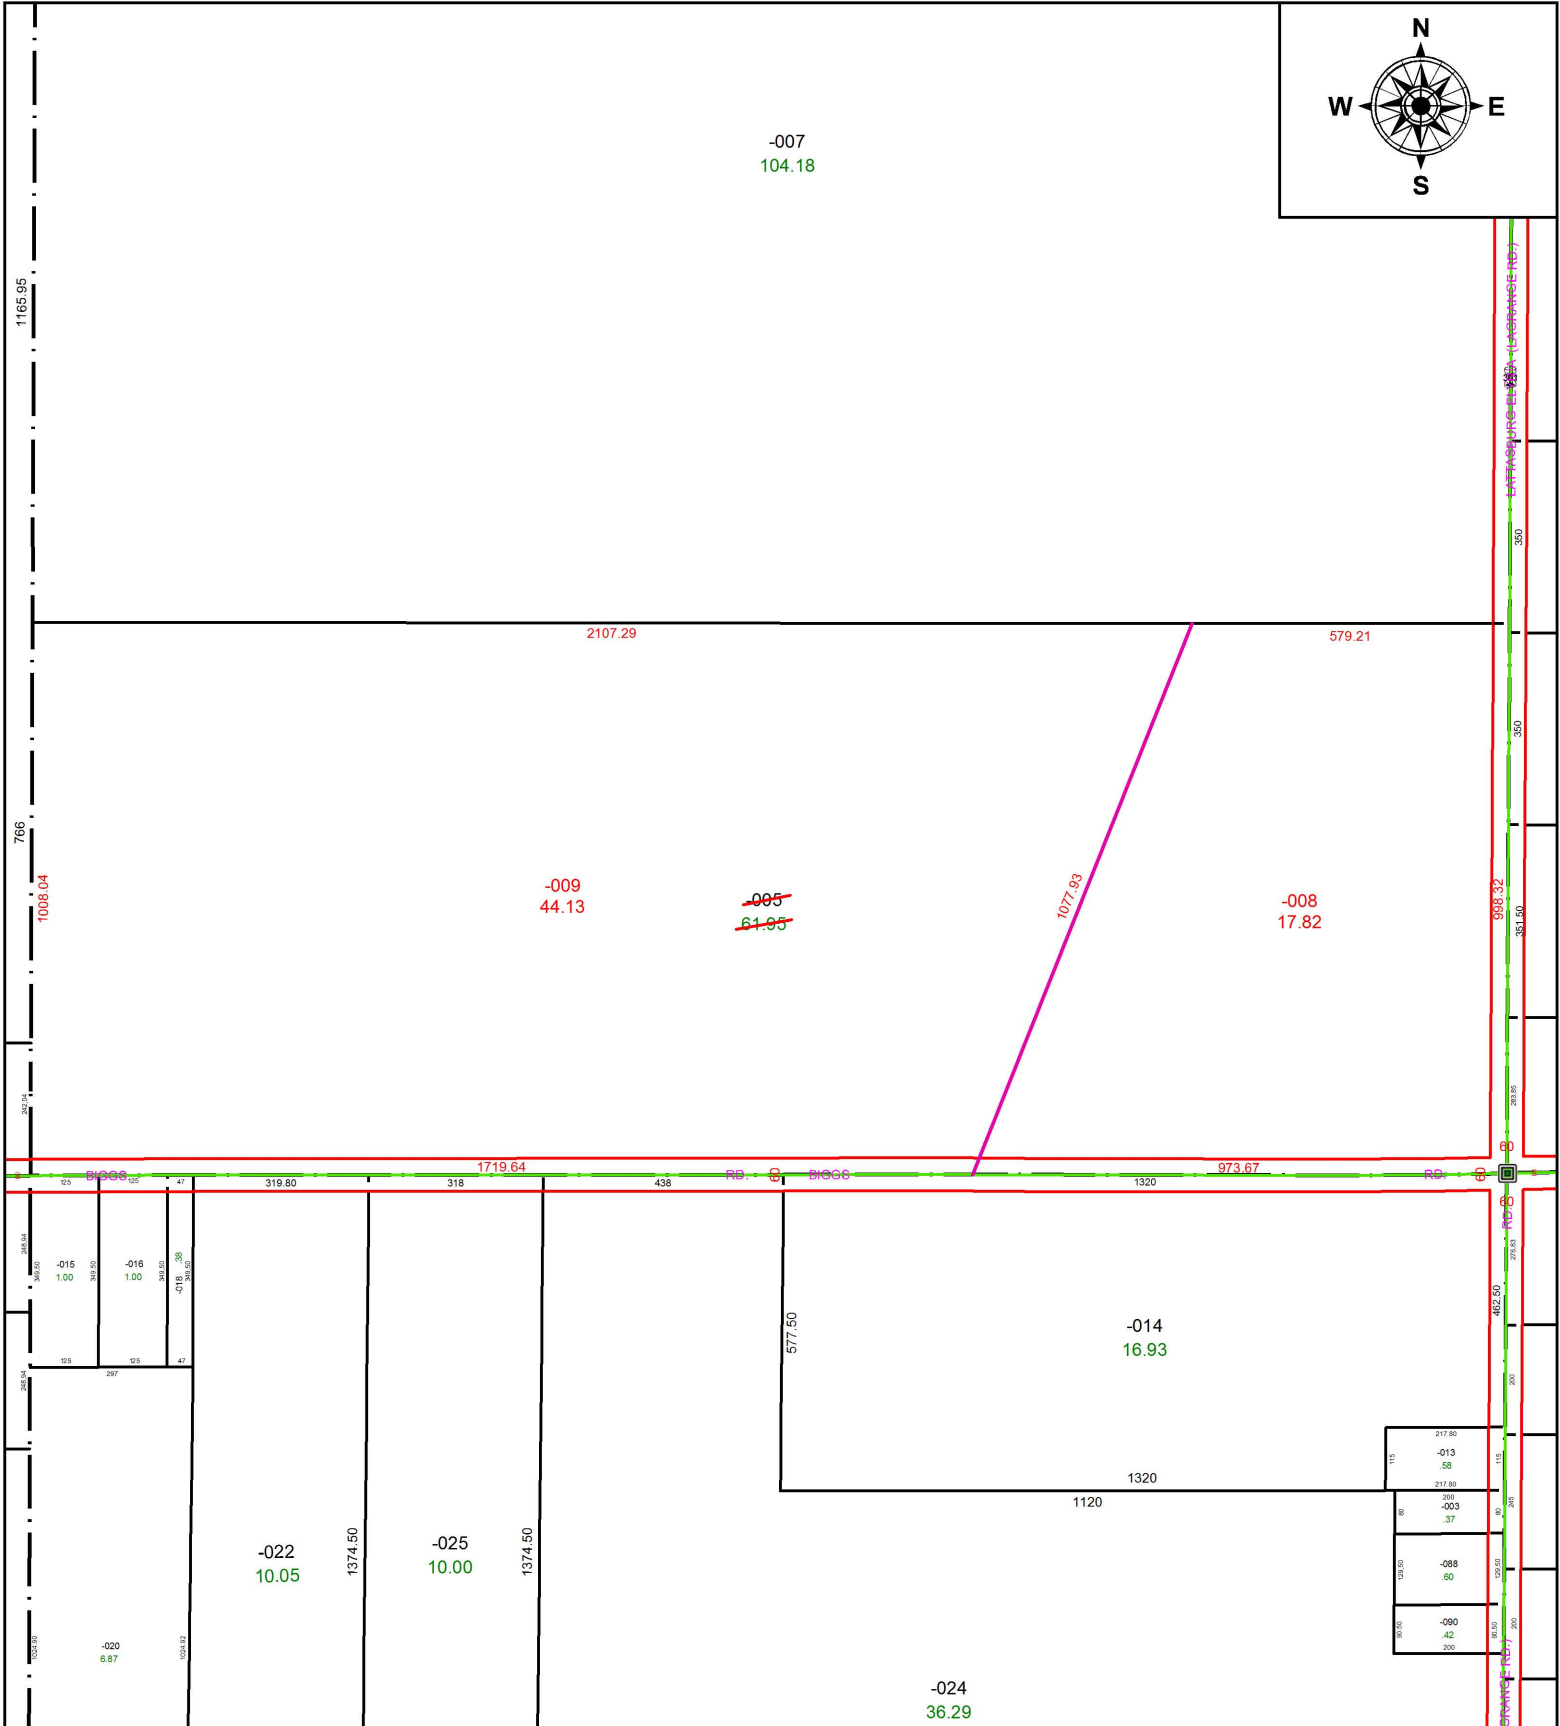


PARENT PARCEL: 15-00-025-000-005

CHILD PARCEL: 15-00-025-000-008, -009

STARTING POINT: INTERSECTION OF C/L OF BIGGS RD. AND C/L OF S.R.301

18-03914

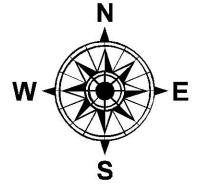

SPLITS/DEEDS PROCESSED
LORAIN COUNTY TAX MAP DEPARTMENT
226 MIDDLE AVE. ELYRIA, OH

SURVEYED BY: LOUISE A. VEVERKA

CLOSURE: 1: 4,487,669

MAP PAGE(S): 15-00-025

APPROVED BY: RRM DATE: 12-17-18

SCALE: 1" = 350 PRIOR INSTRUMENT: 20040021188