
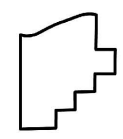
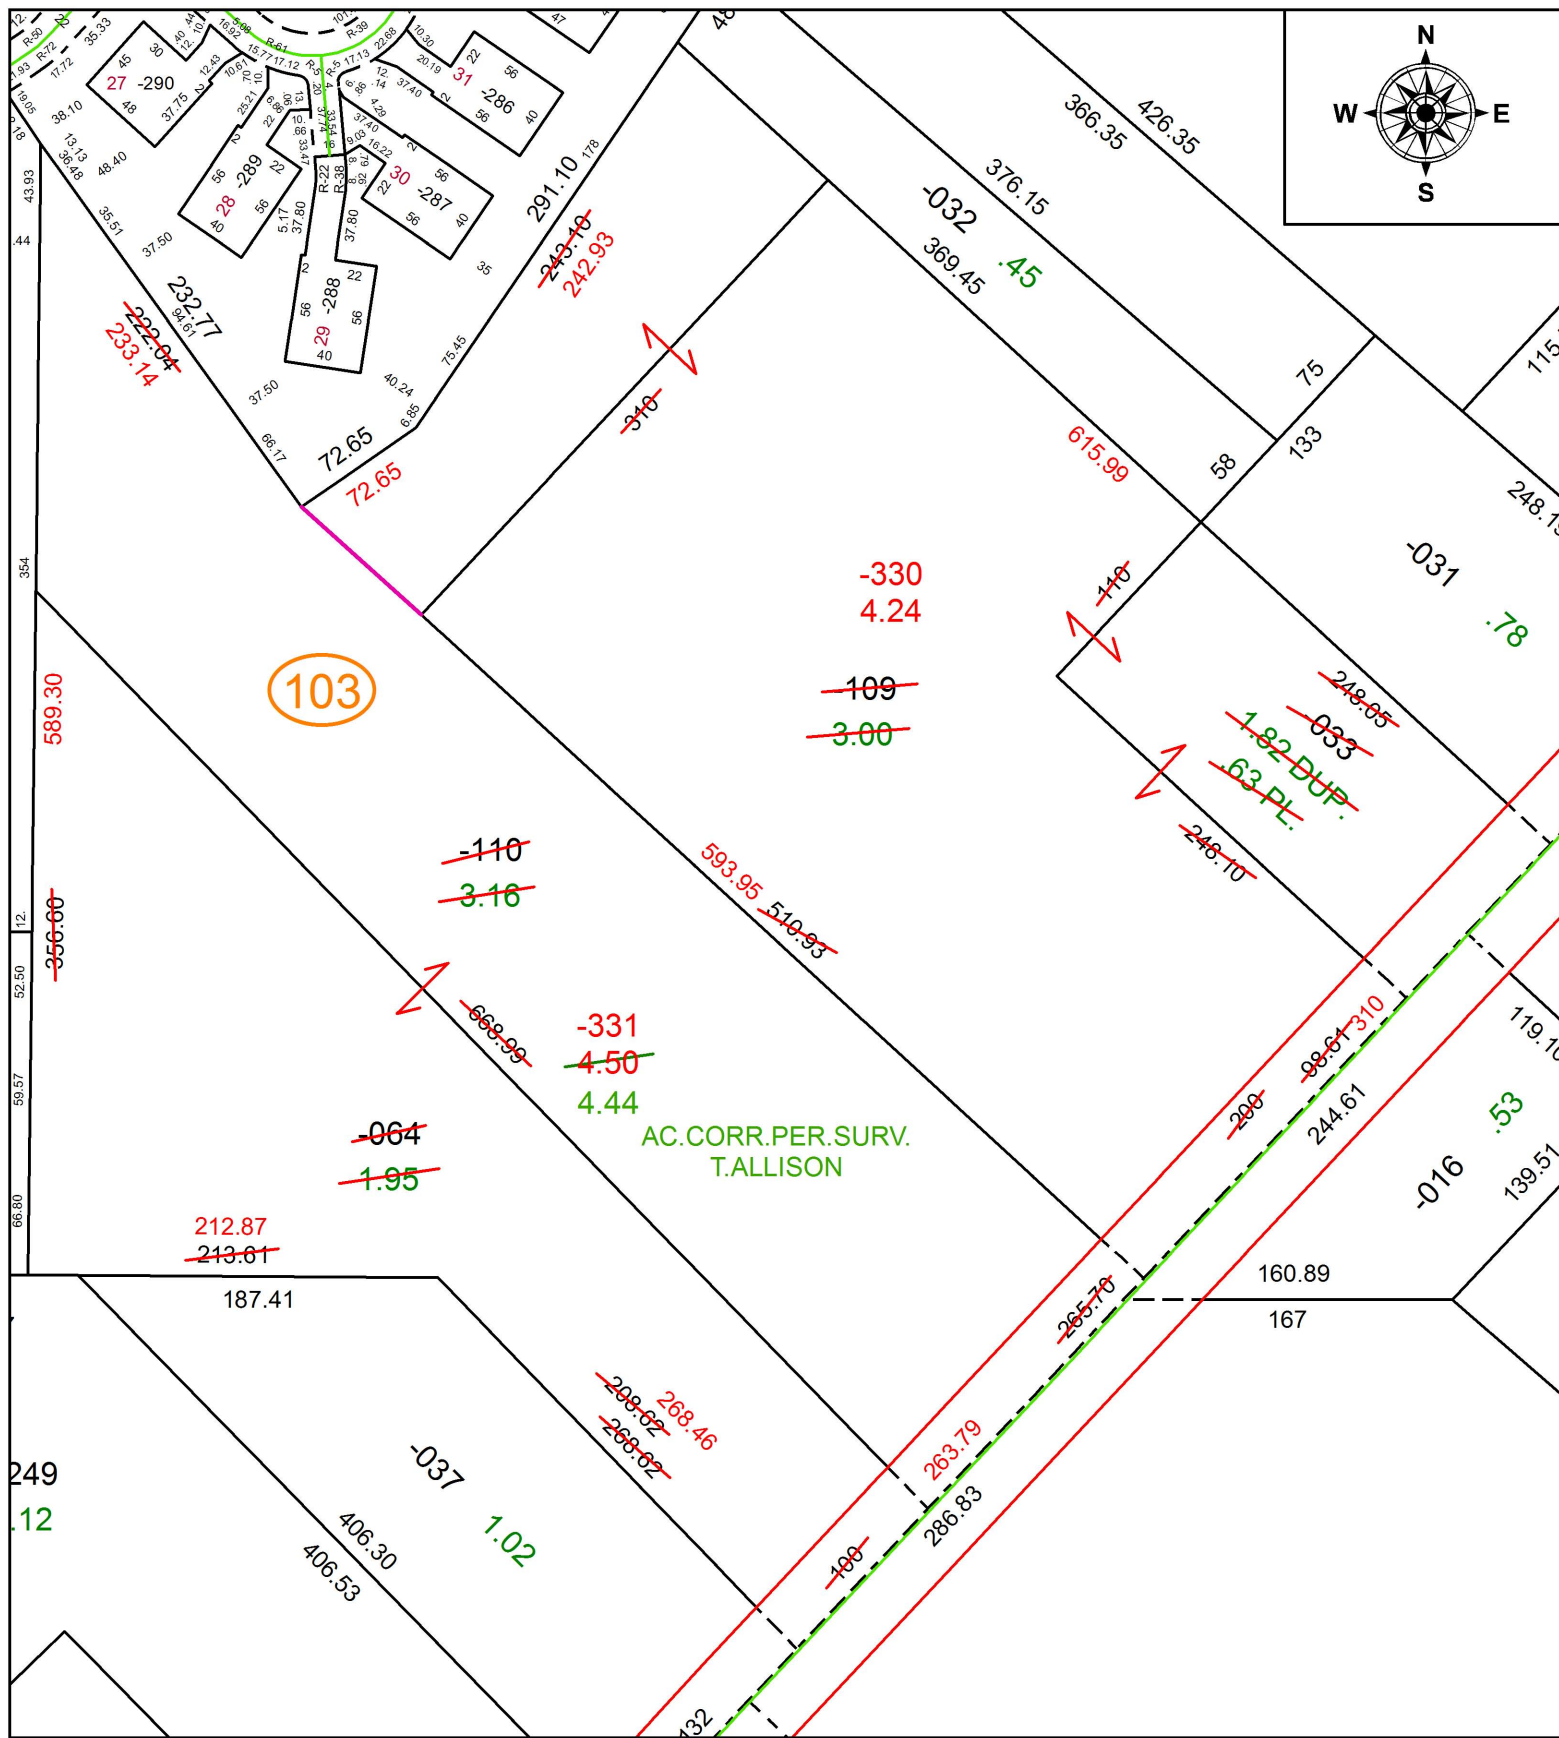


PARENT PARCEL: 07-00-014-103-033, -064, -109, -110

CHILD PARCEL: 07-00-014-103-330, -331

STARTING POINT: SOUTHEAST CORNER OF DEERFIELD MEADOWS PH.4

18-03918

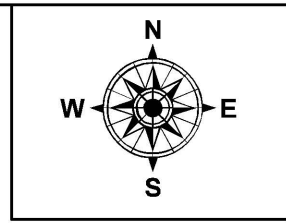

SPLITS/DEEDS PROCESSED
LORAIN COUNTY TAX MAP DEPARTMENT
226 MIDDLE AVE. ELYRIA, OH

SURVEYED BY: TERRENCE R. ALLISON
CLOSURE: 1: 141,068
MAP PAGE(S): 7-00-014
APPROVED BY: RRM DATE: 12-19-18
SCALE: 1" = 100 PRIOR INSTRUMENT: 20040011491