
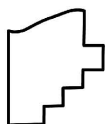


PARENT PARCEL: ADD TO DUPLICATE

CHILD PARCEL: 10-00-005-600-002

STARTING POINT: COLUMBIA GAS CO.

18-03920-A

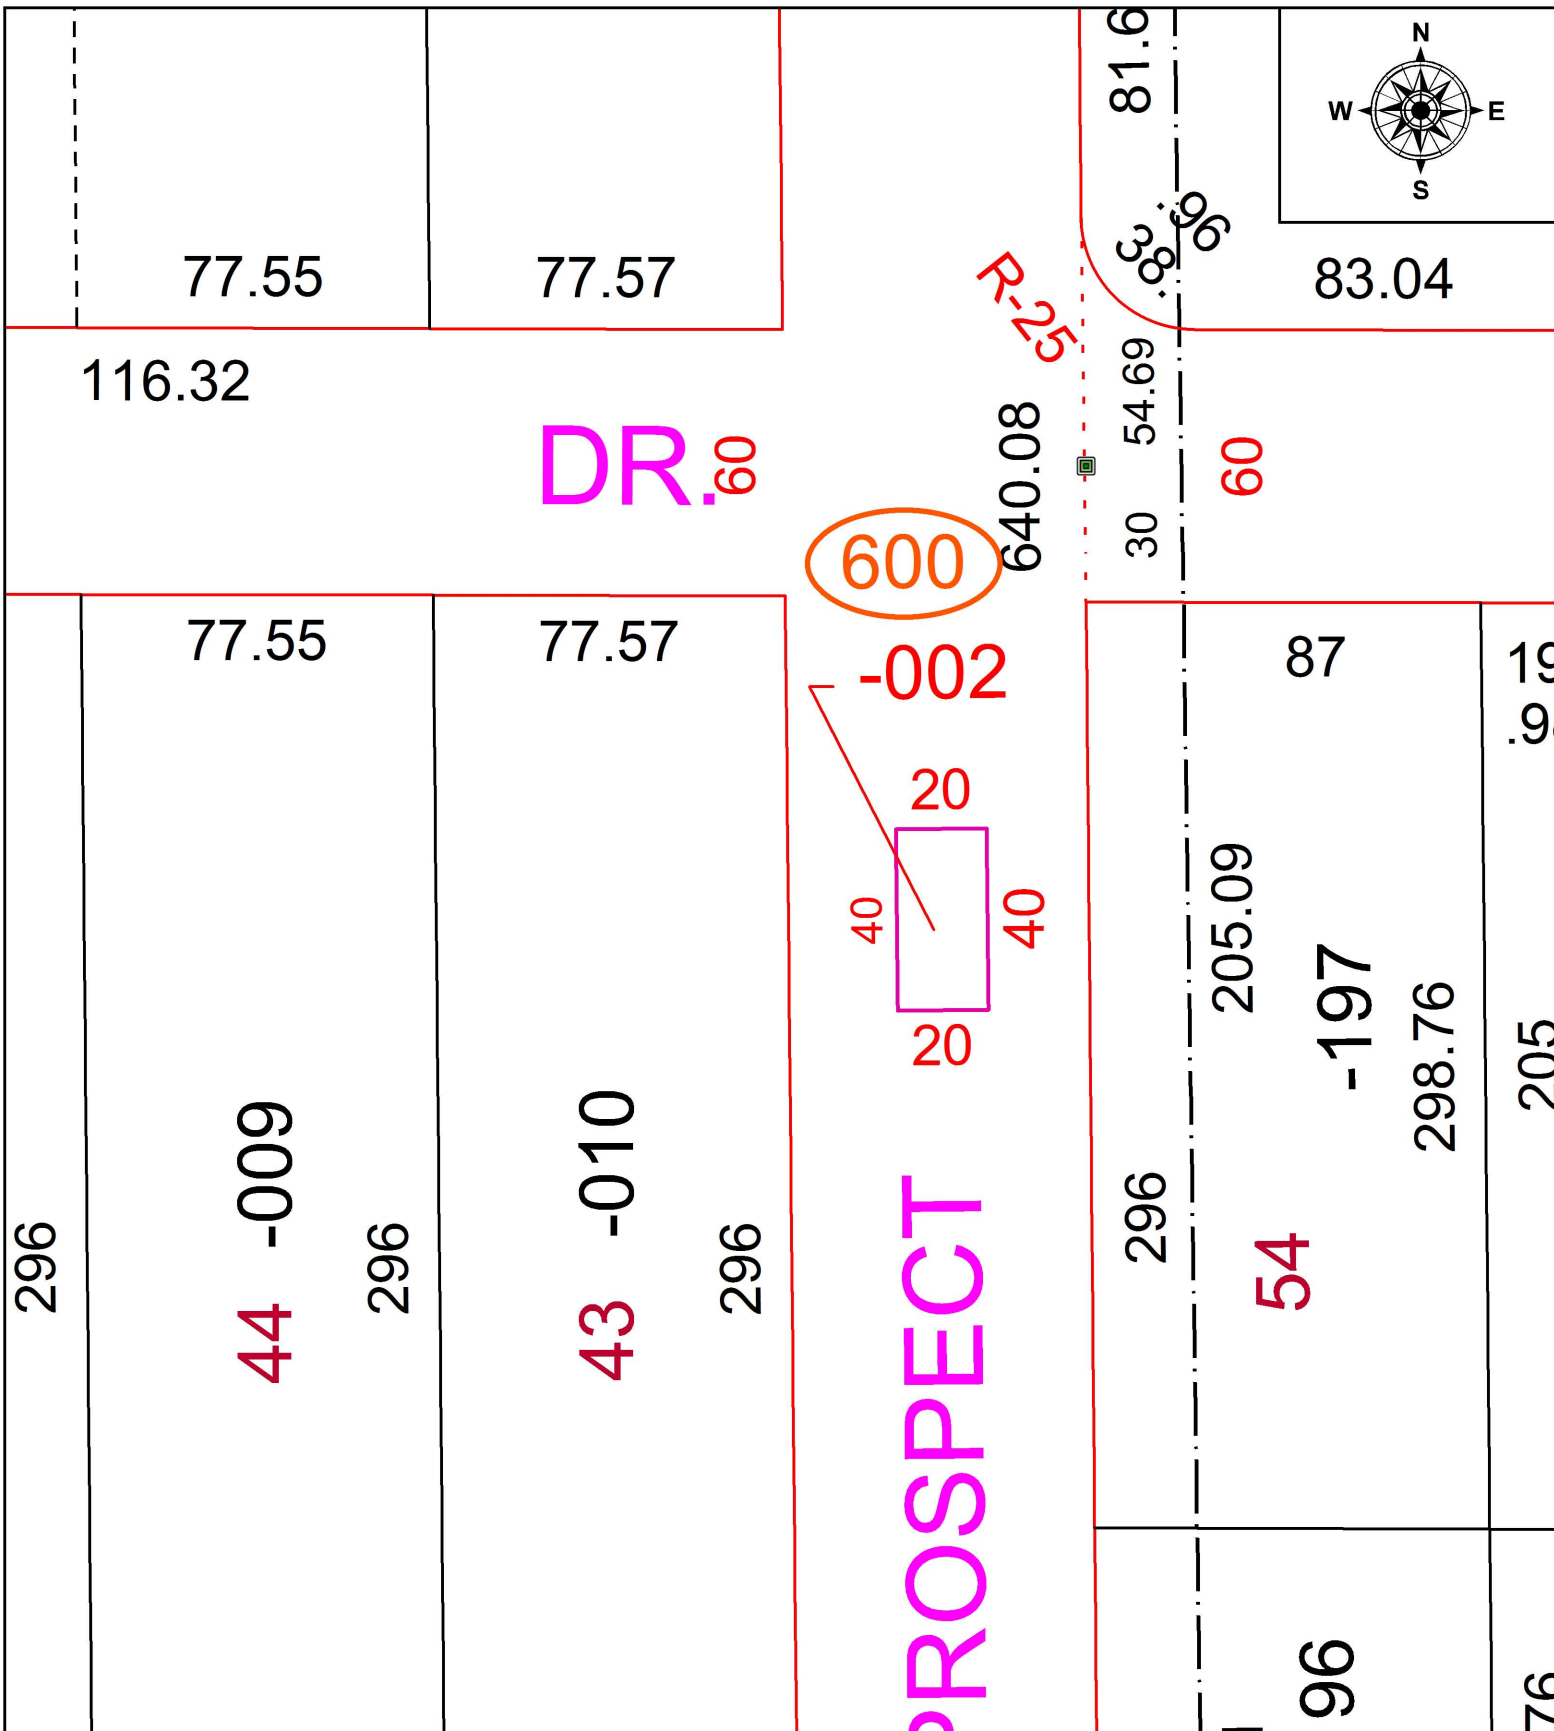

SPLITS/DEEDS PROCESSED
LORAIN COUNTY TAX MAP DEPARTMENT
226 MIDDLE AVE. ELYRIA, OH

SURVEYED BY:	NA
CLOSURE:	NA
MAP PAGE(S):	10-00-005
APPROVED BY:	TJS DATE: 6/22/18
SCALE:	1" = 25' PRIOR INSTRUMENT: NA