
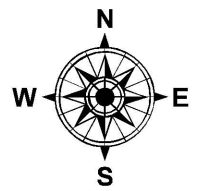


PARENT PARCEL: 15-00-098-108-175, -292


CHILD PARCEL: 15-00-098-108-175, -293, -294

STARTING POINT: SOUTHWEST CORNER OF S/L 475 IN PHEASANT RUN VILLAGE SUB. NO. 1

18-03920

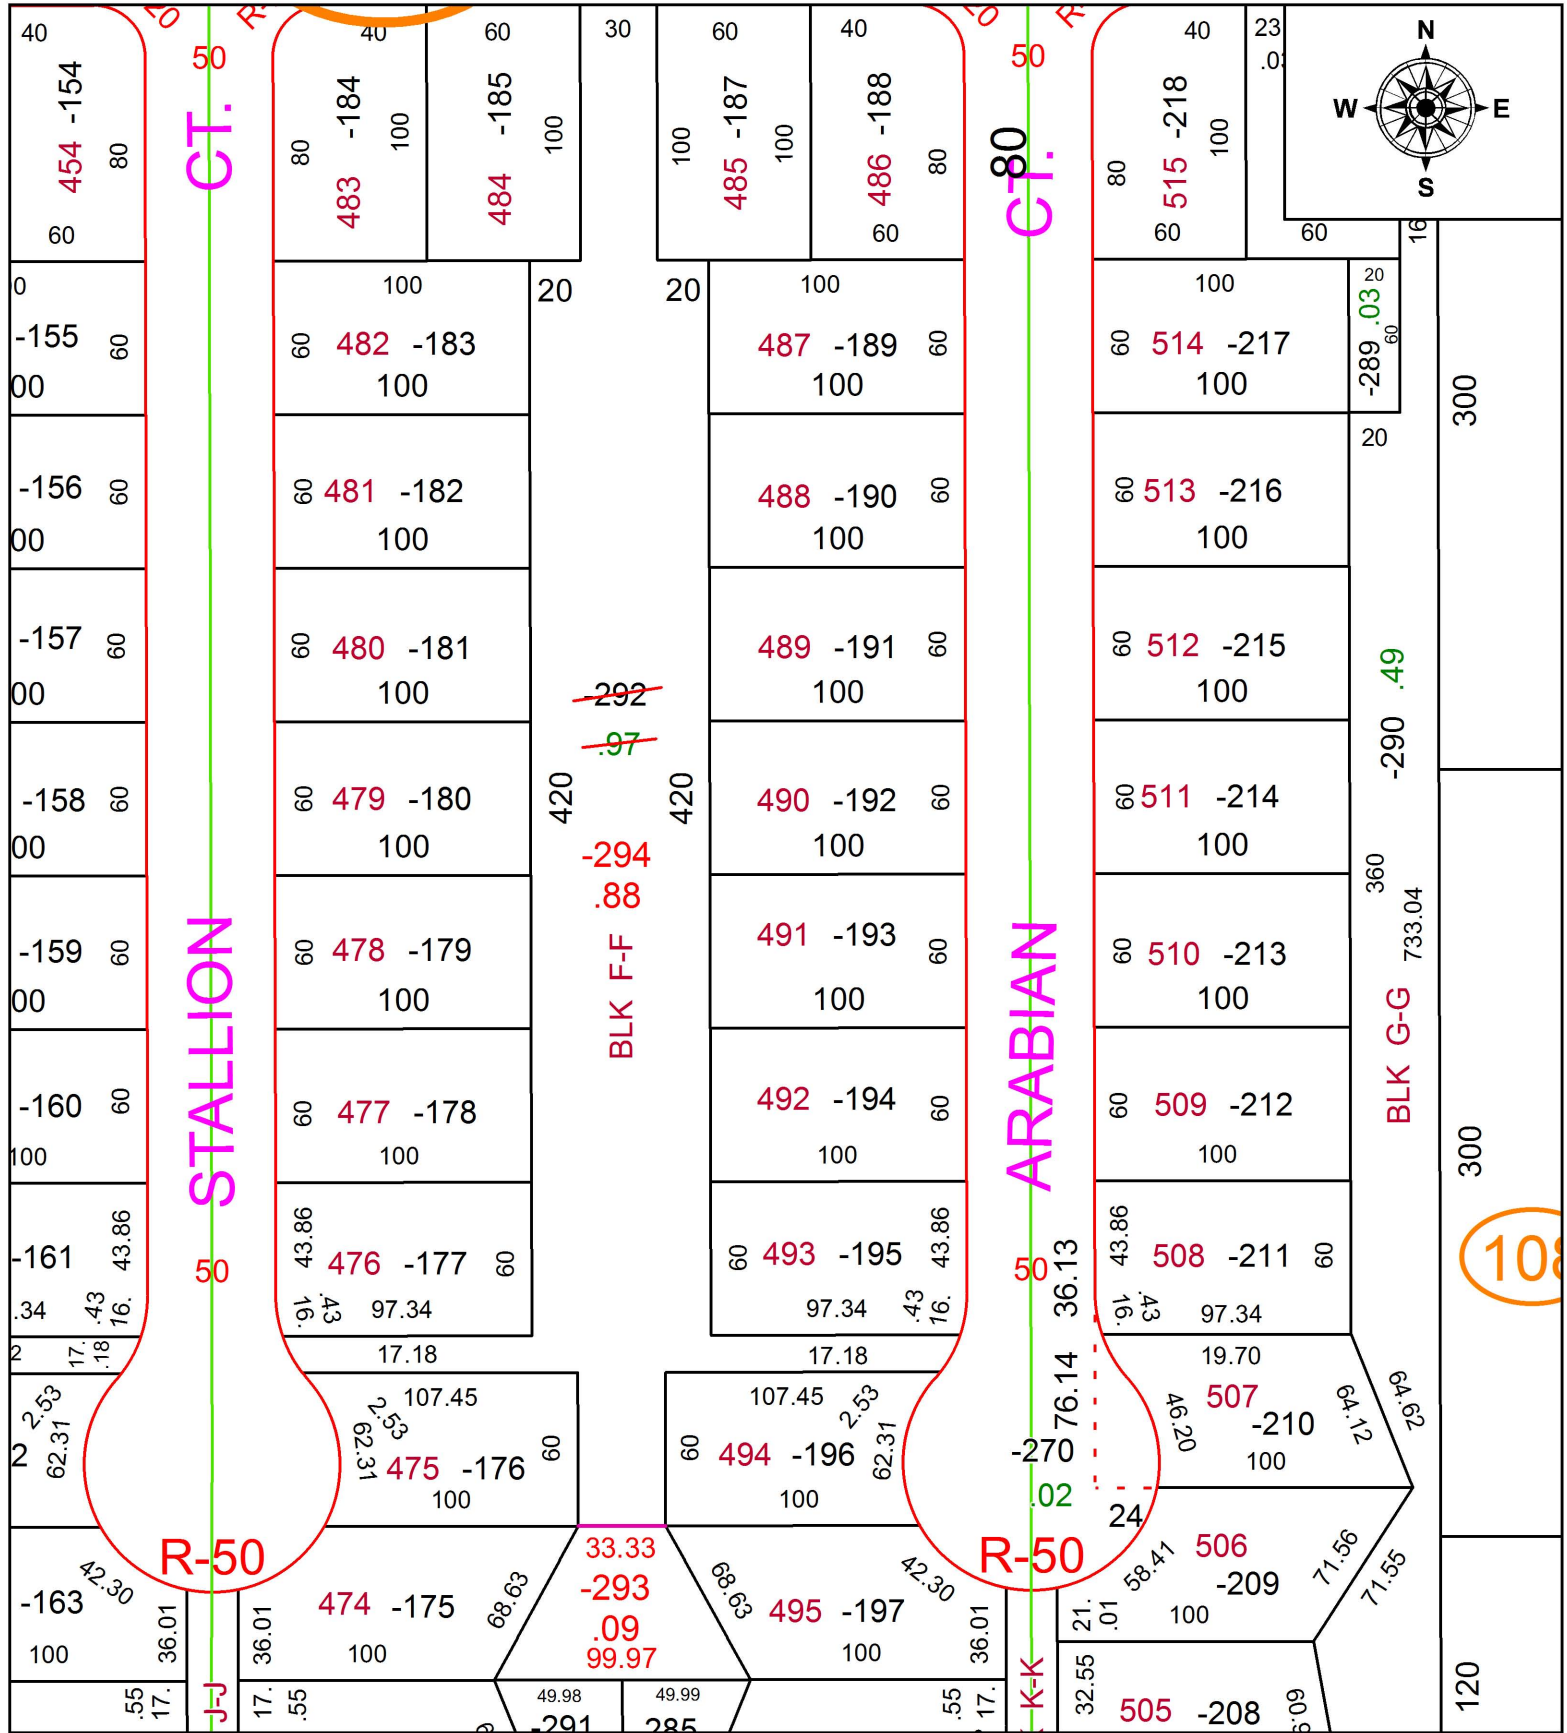

108

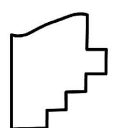

SPLITS/DEEDS PROCESSED
 LORAIN COUNTY TAX MAP DEPARTMENT
 226 MIDDLE AVE. ELYRIA, OH

SURVEYED BY: THOMAS A. SIMON
 CLOSURE: 1: 107,789
 MAP PAGE(S): 15-00-098
 APPROVED BY: RRM DATE: 12-21-18
 SCALE: 1" = 75' PRIOR INSTRUMENT: 20170645518