


PARENT PARCEL: ADD TO DUPLICATE

CHILD PARCEL: 03-00-044-600-001

STARTING POINT: INTERSECTION OF W.DEVONSHIRE AVE. & DILLWOOD AVE.

18-03921-A

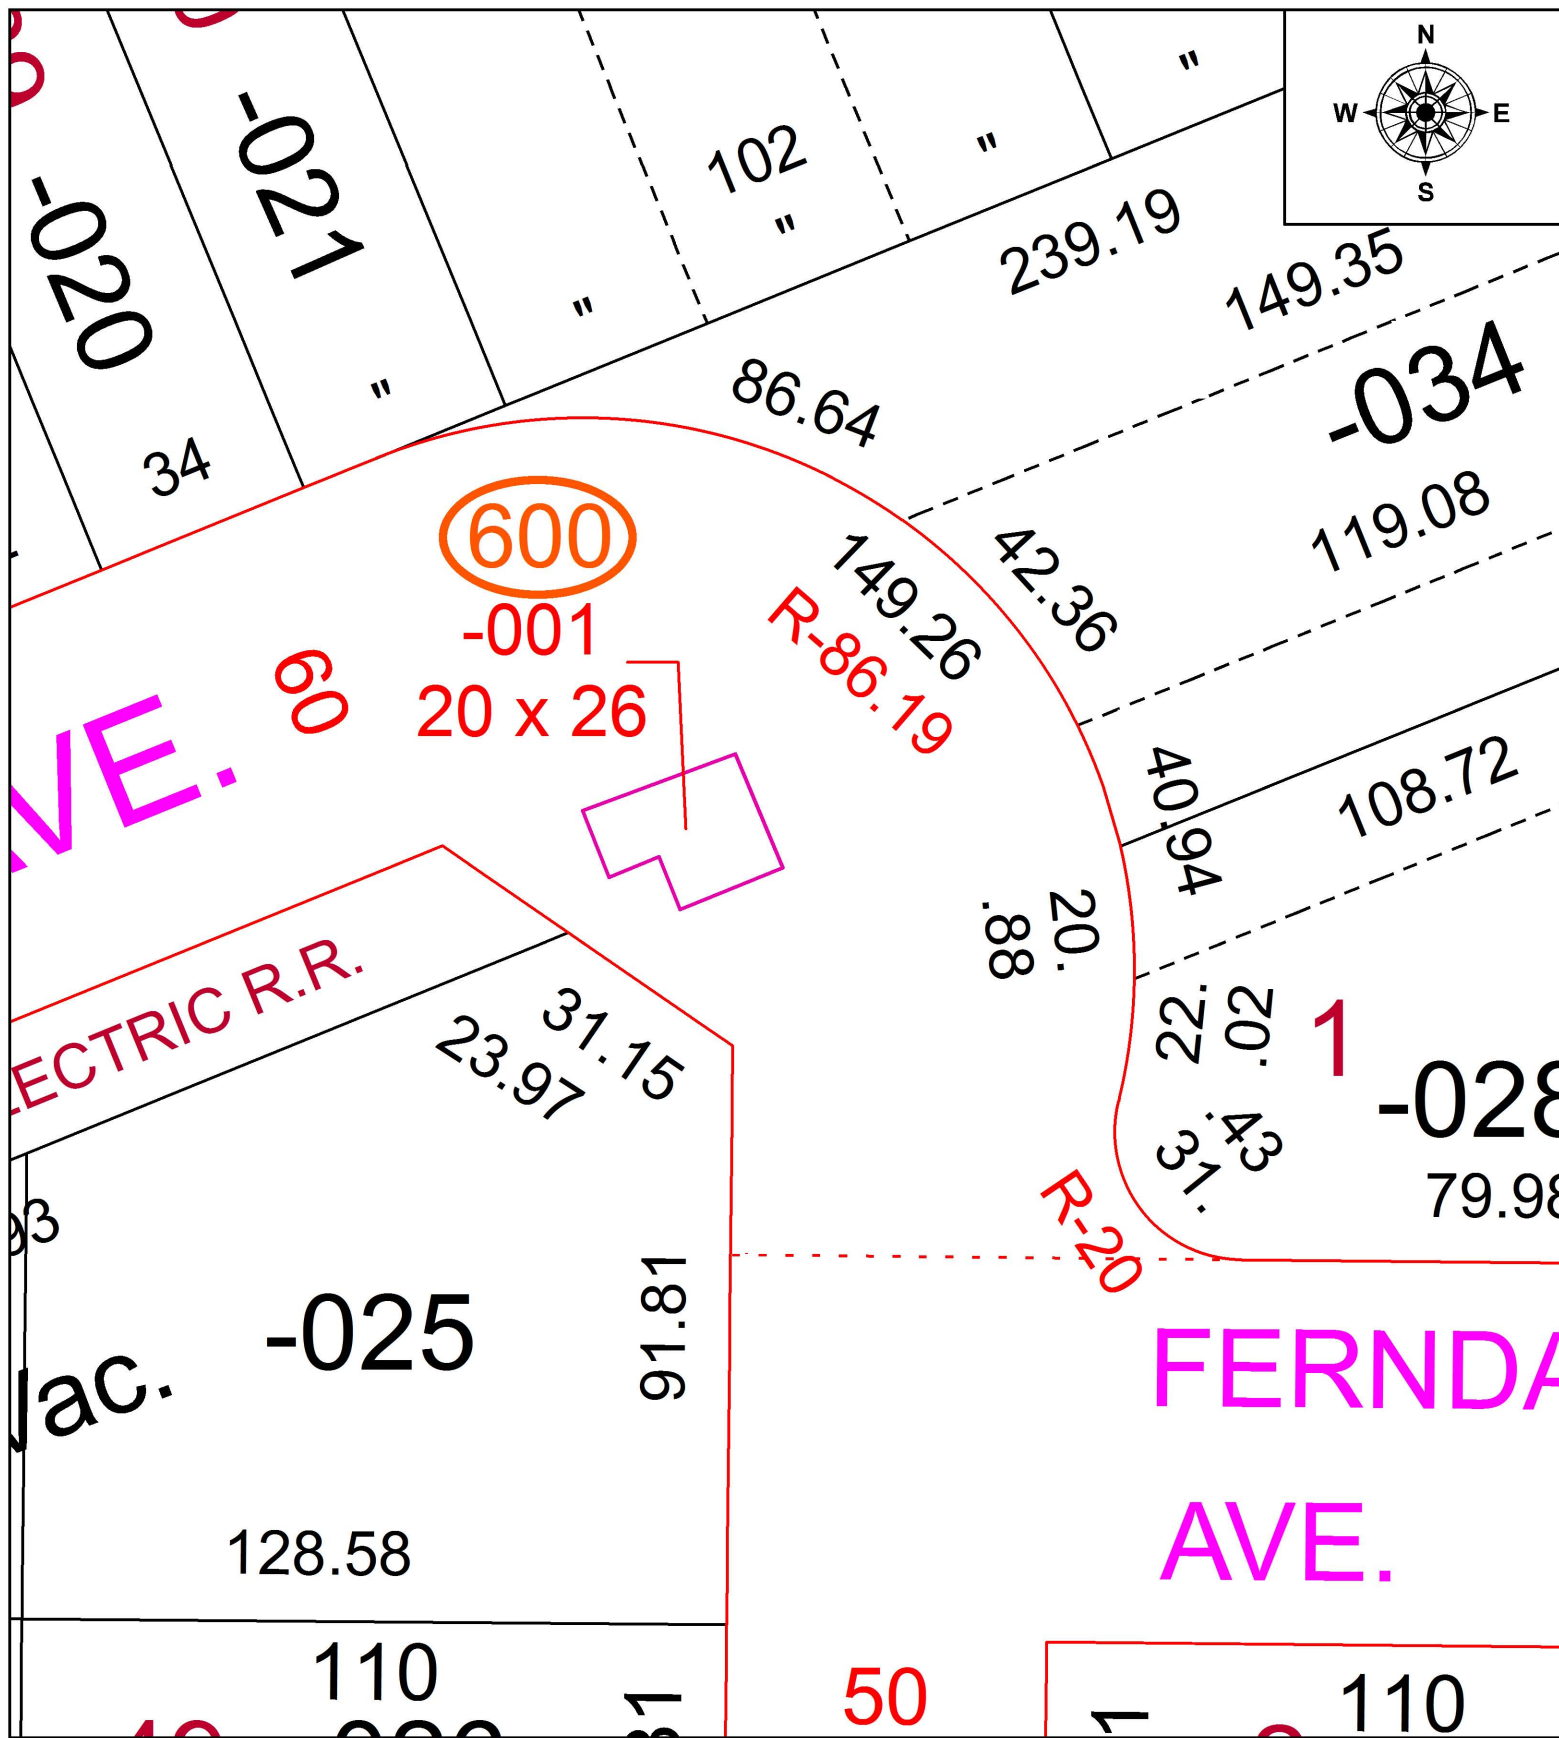

SPLITS/DEEDS PROCESSED

LORAIN COUNTY TAX MAP DEPARTMENT
226 MIDDLE AVE. ELYRIA, OH

SURVEYED BY: NA

CLOSURE: NA

MAP PAGE(S): 03-00-044

APPROVED BY: TJS DATE: 6/28/18

SCALE: 1" = 30' PRIOR INSTRUMENT: NA