


PARENT PARCEL: 15-00-098-108-176, -294

CHILD PARCEL: 15-00-098-108-176, -295, -296

STARTING POINT: SOUTHWEST CORNER OF S/L 476 IN PHEASANT RUN VILLAGE SUB. NO. 1

18-03921

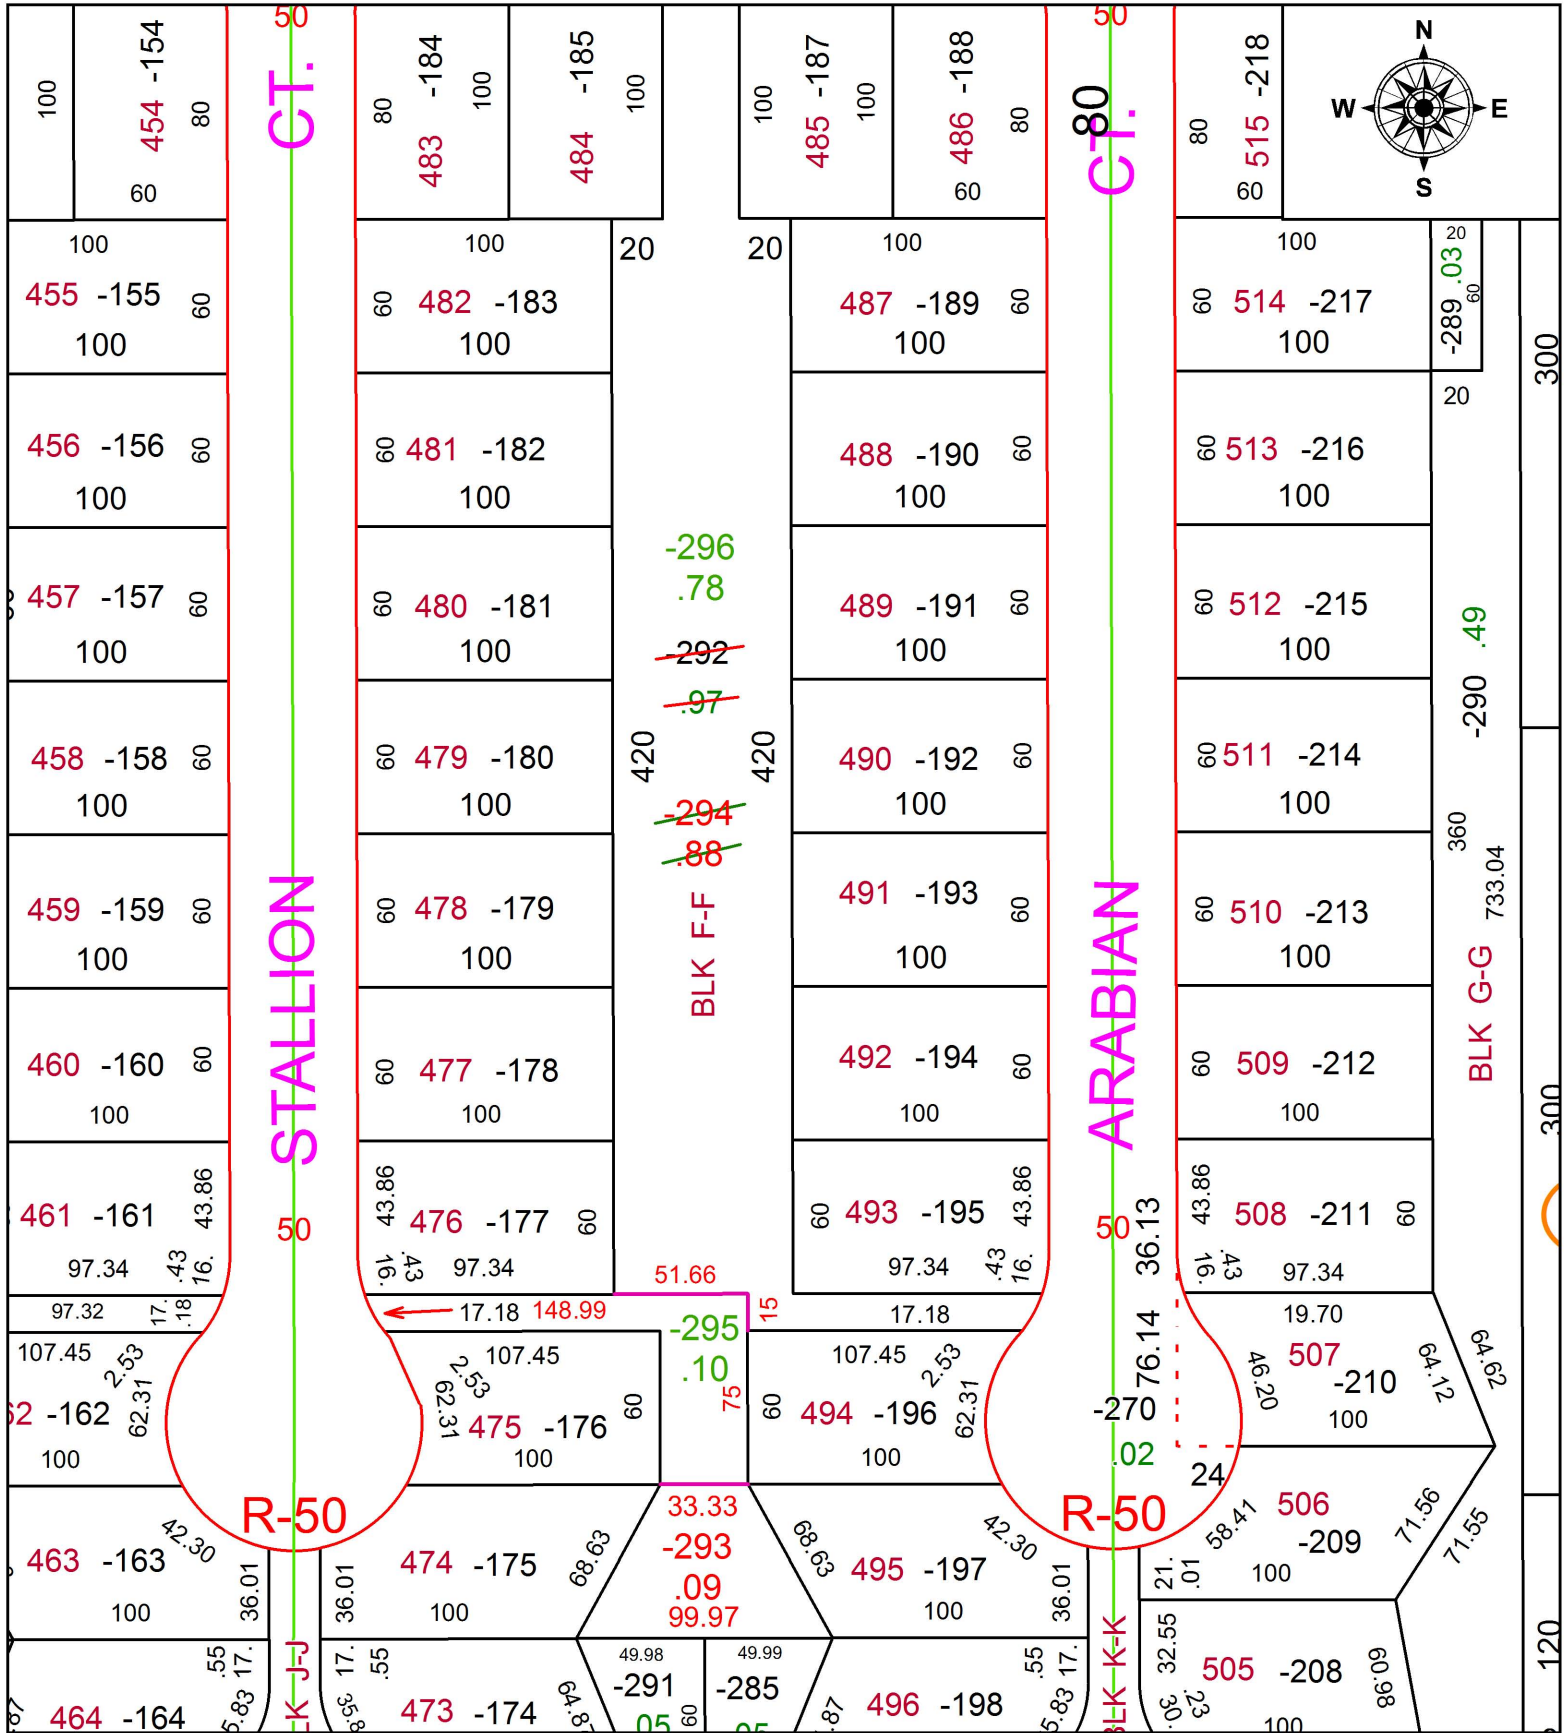

**SPLITS/DEEDS PROCESSED**

LORAIN COUNTY TAX MAP DEPARTMENT  
226 MIDDLE AVE. ELYRIA, OH

SURVEYED BY: THOMAS A. SIMON

CLOSURE: 1: 165,794

MAP PAGE(S): 15-00-098

APPROVED BY: RRM DATE: 12-21-18

SCALE: 1" = 75 PRIOR INSTRUMENT: 20170645518