
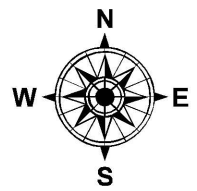


PARENT PARCEL: 03-00-004-000-082, -083, 03-00-005-000-062


CHILD PARCEL: 03-00-004-000-084 THRU -087, 03-00-005-000-062

STARTING POINT: INTERSECTION OF C/L OF FRENCH CREEK RD. AND EAST LINE OF O.L.5

19-03927

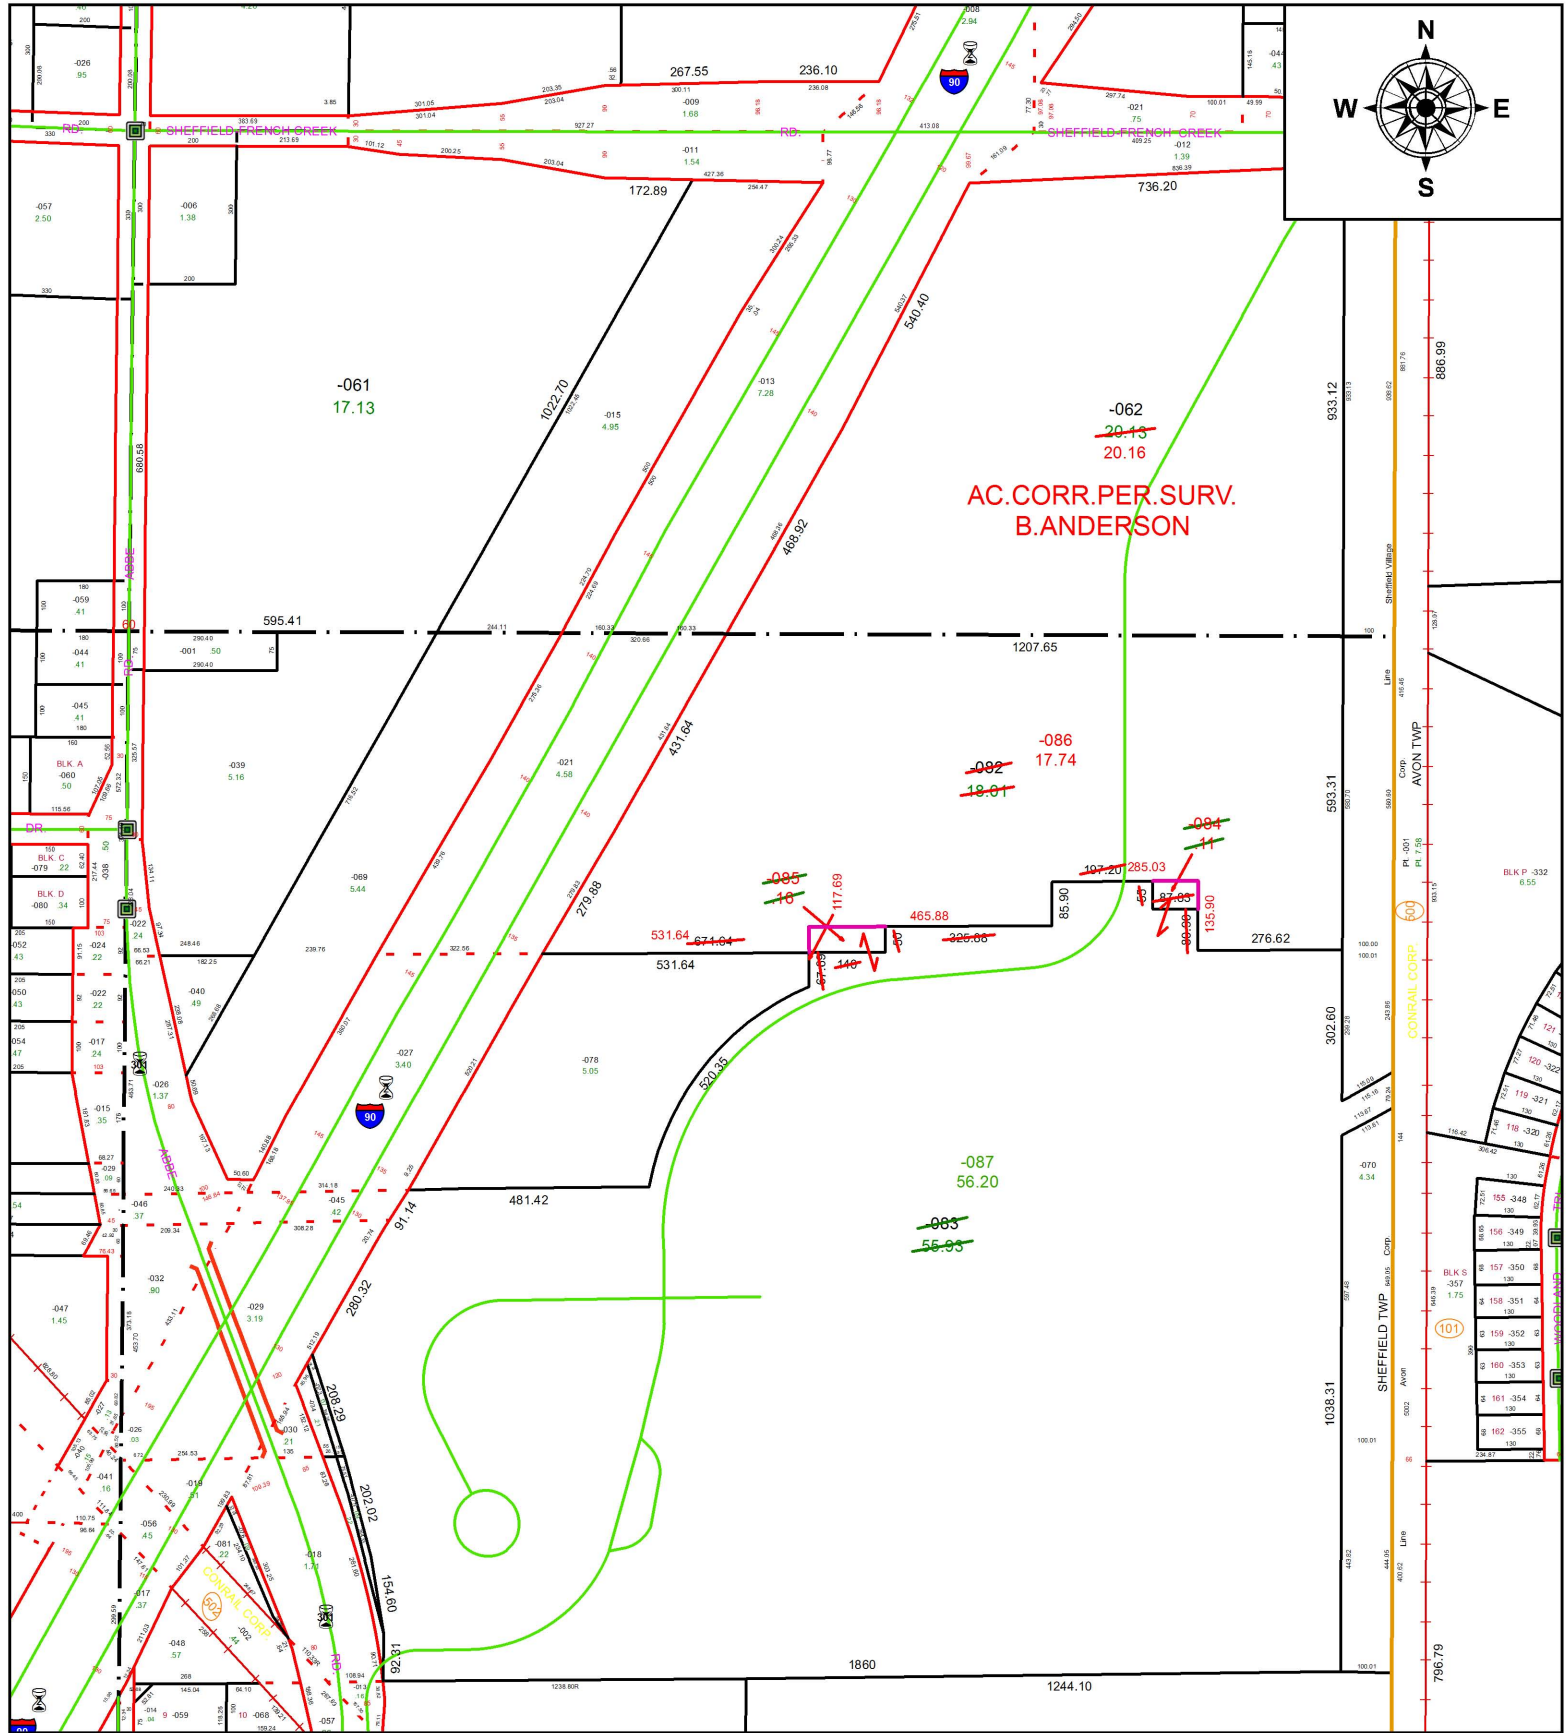

AC. CORR. PER. SURV.
B. ANDERSON

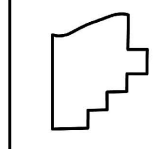

SPLITS/DEEDS PROCESSED
LORAIN COUNTY TAX MAP DEPARTMENT
226 MIDDLE AVE. ELYRIA, OH

SURVEYED BY: BRENT D. ANDERSON
 CLOSURE: 1:2147435758
 MAP PAGE(S): 3-00-004
 APPROVED BY: RRM DATE: 1-23-19
 SCALE: 1" = 375 PRIOR INSTRUMENT: 20170649699