


PARENT PARCEL: 02-01-001-108-012, -013, -014, -018, -019, -020, 02-01-003-116-169

CHILD PARCEL: 02-01-001-108-021 THRU -026, 02-01-003-116-170

STARTING POINT: INTERSECTION OF C/L OF ARIZONA AVE. AND C/L OF BASCULE DR.

19-03933

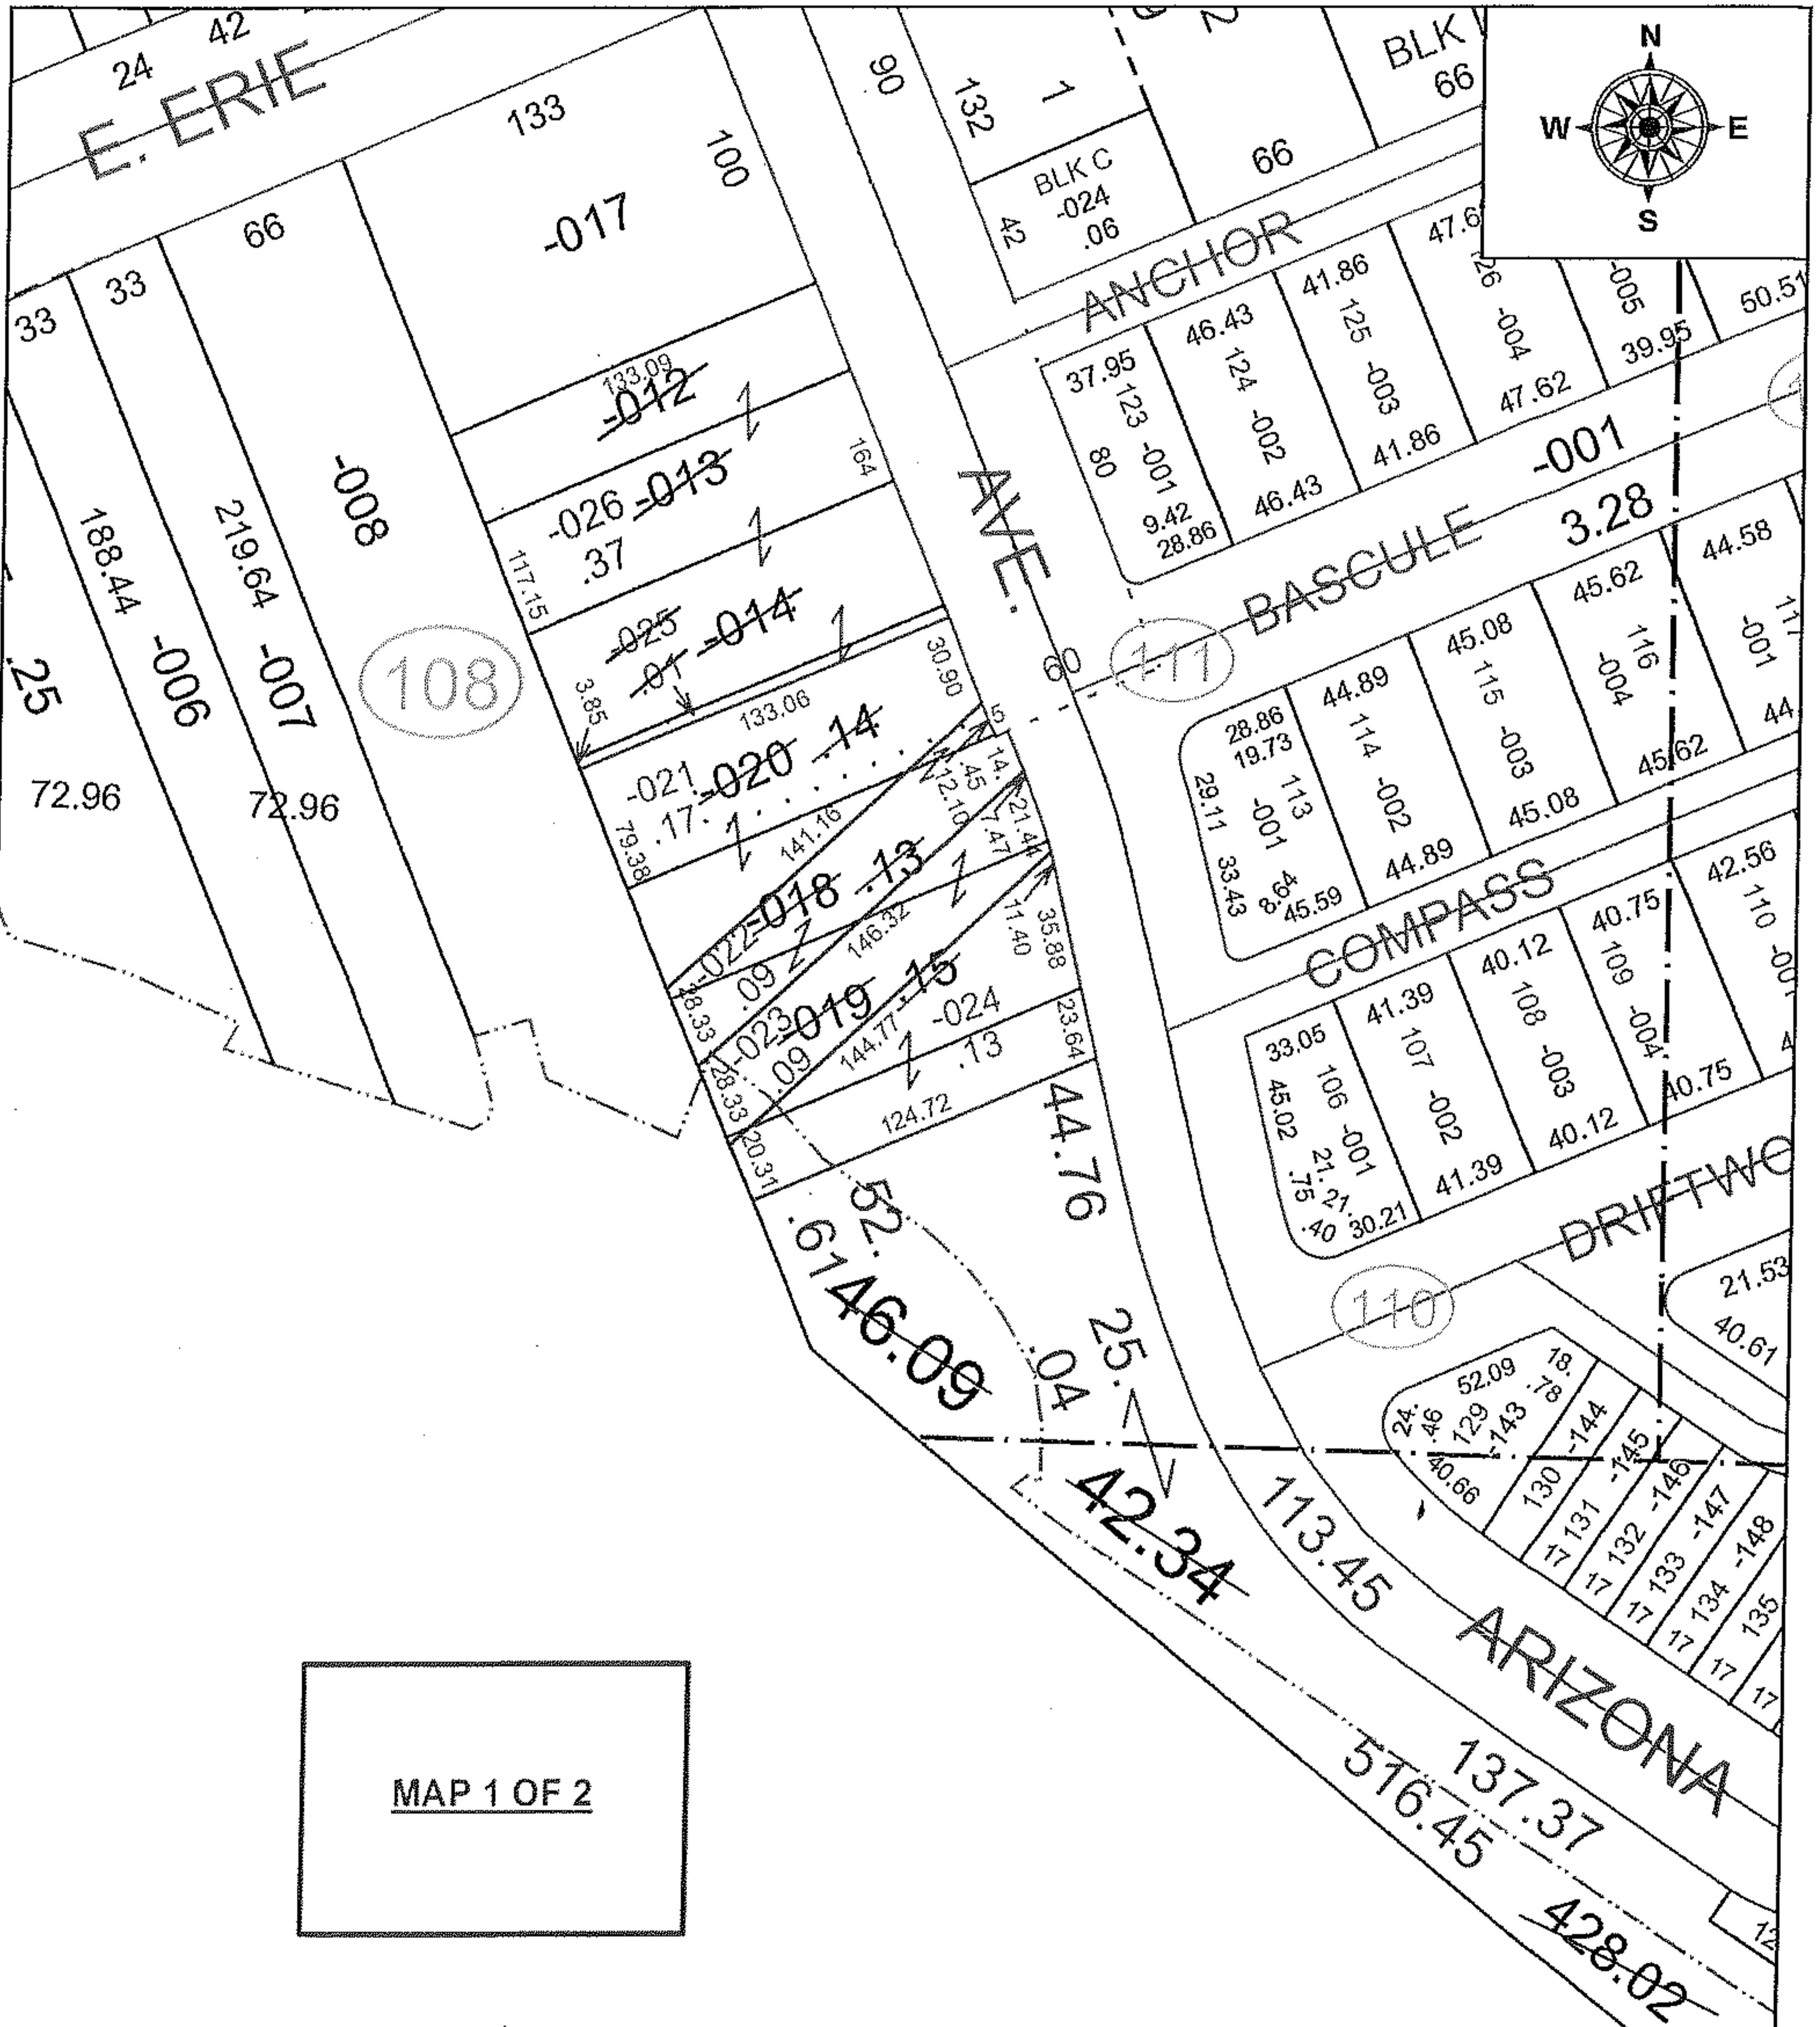

MAP 1 OF 2

SPLITS/DEEDS PROCESSED

LORAIN COUNTY TAX MAP DEPARTMENT
226 MIDDLE AVE. ELYRIA, OH

SURVEYED BY:	AMY M. KELLY
CLOSURE:	1:53,380
MAP PAGE(S):	2-01-001
APPROVED BY:	RRM DATE: 2-8-19
SCALE:	1" = 75' PRIOR INSTRUMENT: 20100326643