
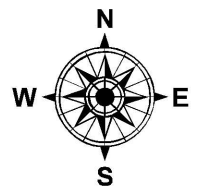


PARENT PARCEL: 02-01-001-108-012, -013, -014, -018, -019, -020, 02-01-003-116-169

CHILD PARCEL: 02-01-001-108-021 THRU -026, 02-01-003-116-170

STARTING POINT: INTERSECTION OF C/L OF ARIZONA AVE. AND C/L OF BASCULE DR.

19-03933

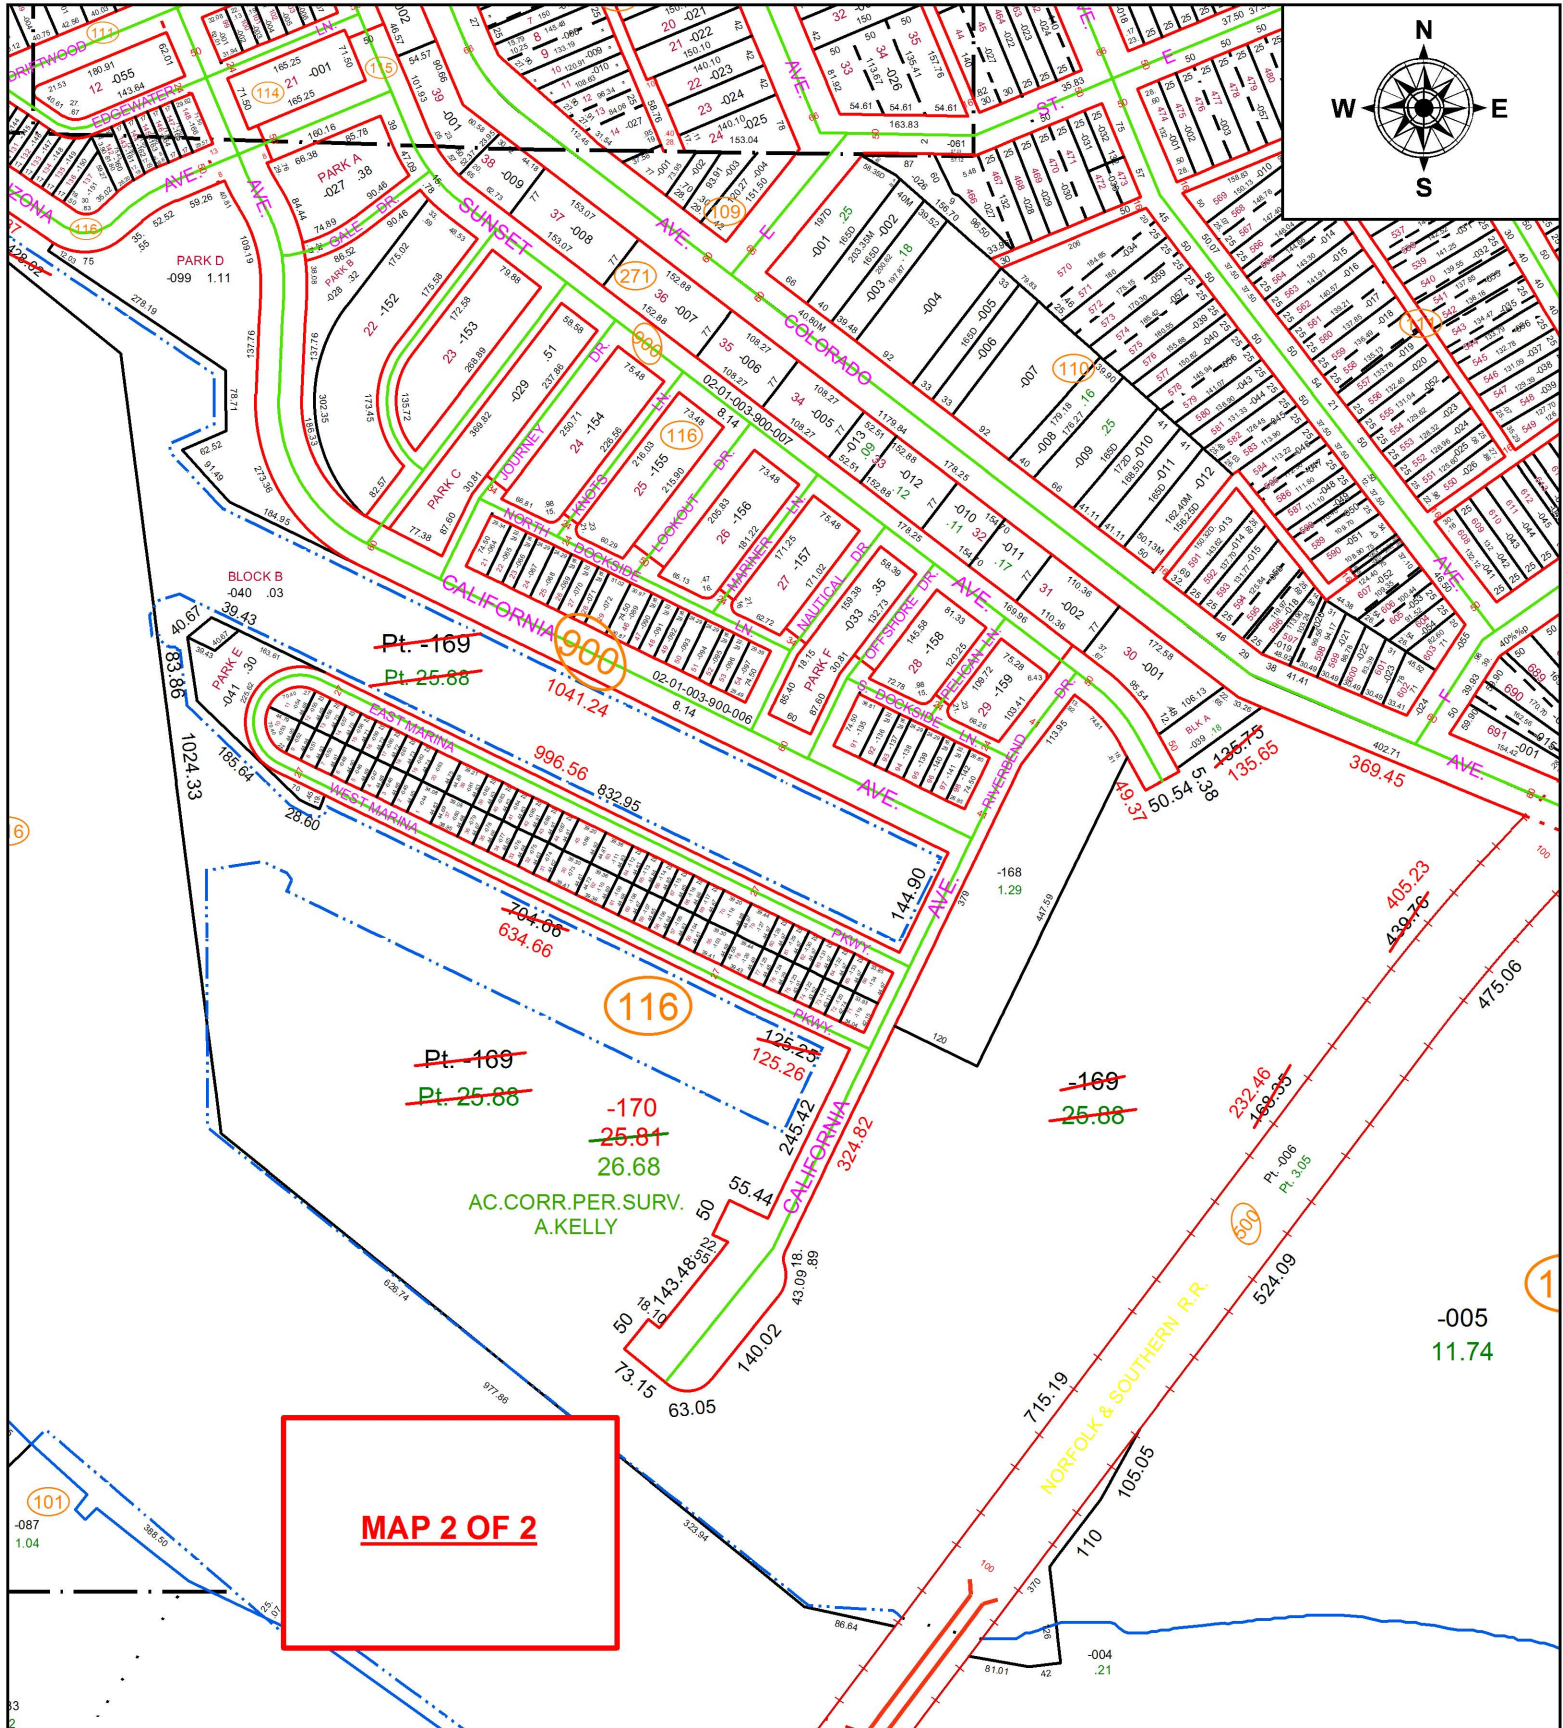

MAP 2 OF 2

~~Pt. 169~~
~~Pt. 25.88~~

116

~~-170~~
~~25.81~~
26.68

AC.CORR.PER.SURV.
A.KELLY


~~169~~
~~25.88~~

~~232.46~~
~~168.35~~

Pt. 008
Pt. 305

500

-005
11.74

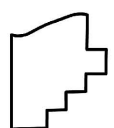

SPLITS/DEEDS PROCESSED
LORAIN COUNTY TAX MAP DEPARTMENT
226 MIDDLE AVE. ELYRIA, OH

SURVEYED BY: AMY M. KELLY
CLOSURE: 1:53,380
MAP PAGE(S): 2-01-001
APPROVED BY: RRM DATE: 2-8-19
SCALE: 1" = 250 PRIOR INSTRUMENT: 20100326643