
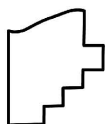


PARENT PARCEL: 04-00-010-108-029

CHILD PARCEL: 04-00-010-108-033, -034

STARTING POINT: INTERSECTION OF EAST LINE OF EATON DR. AND SOUTH LINE OF LAKE DR.

18-03933-D

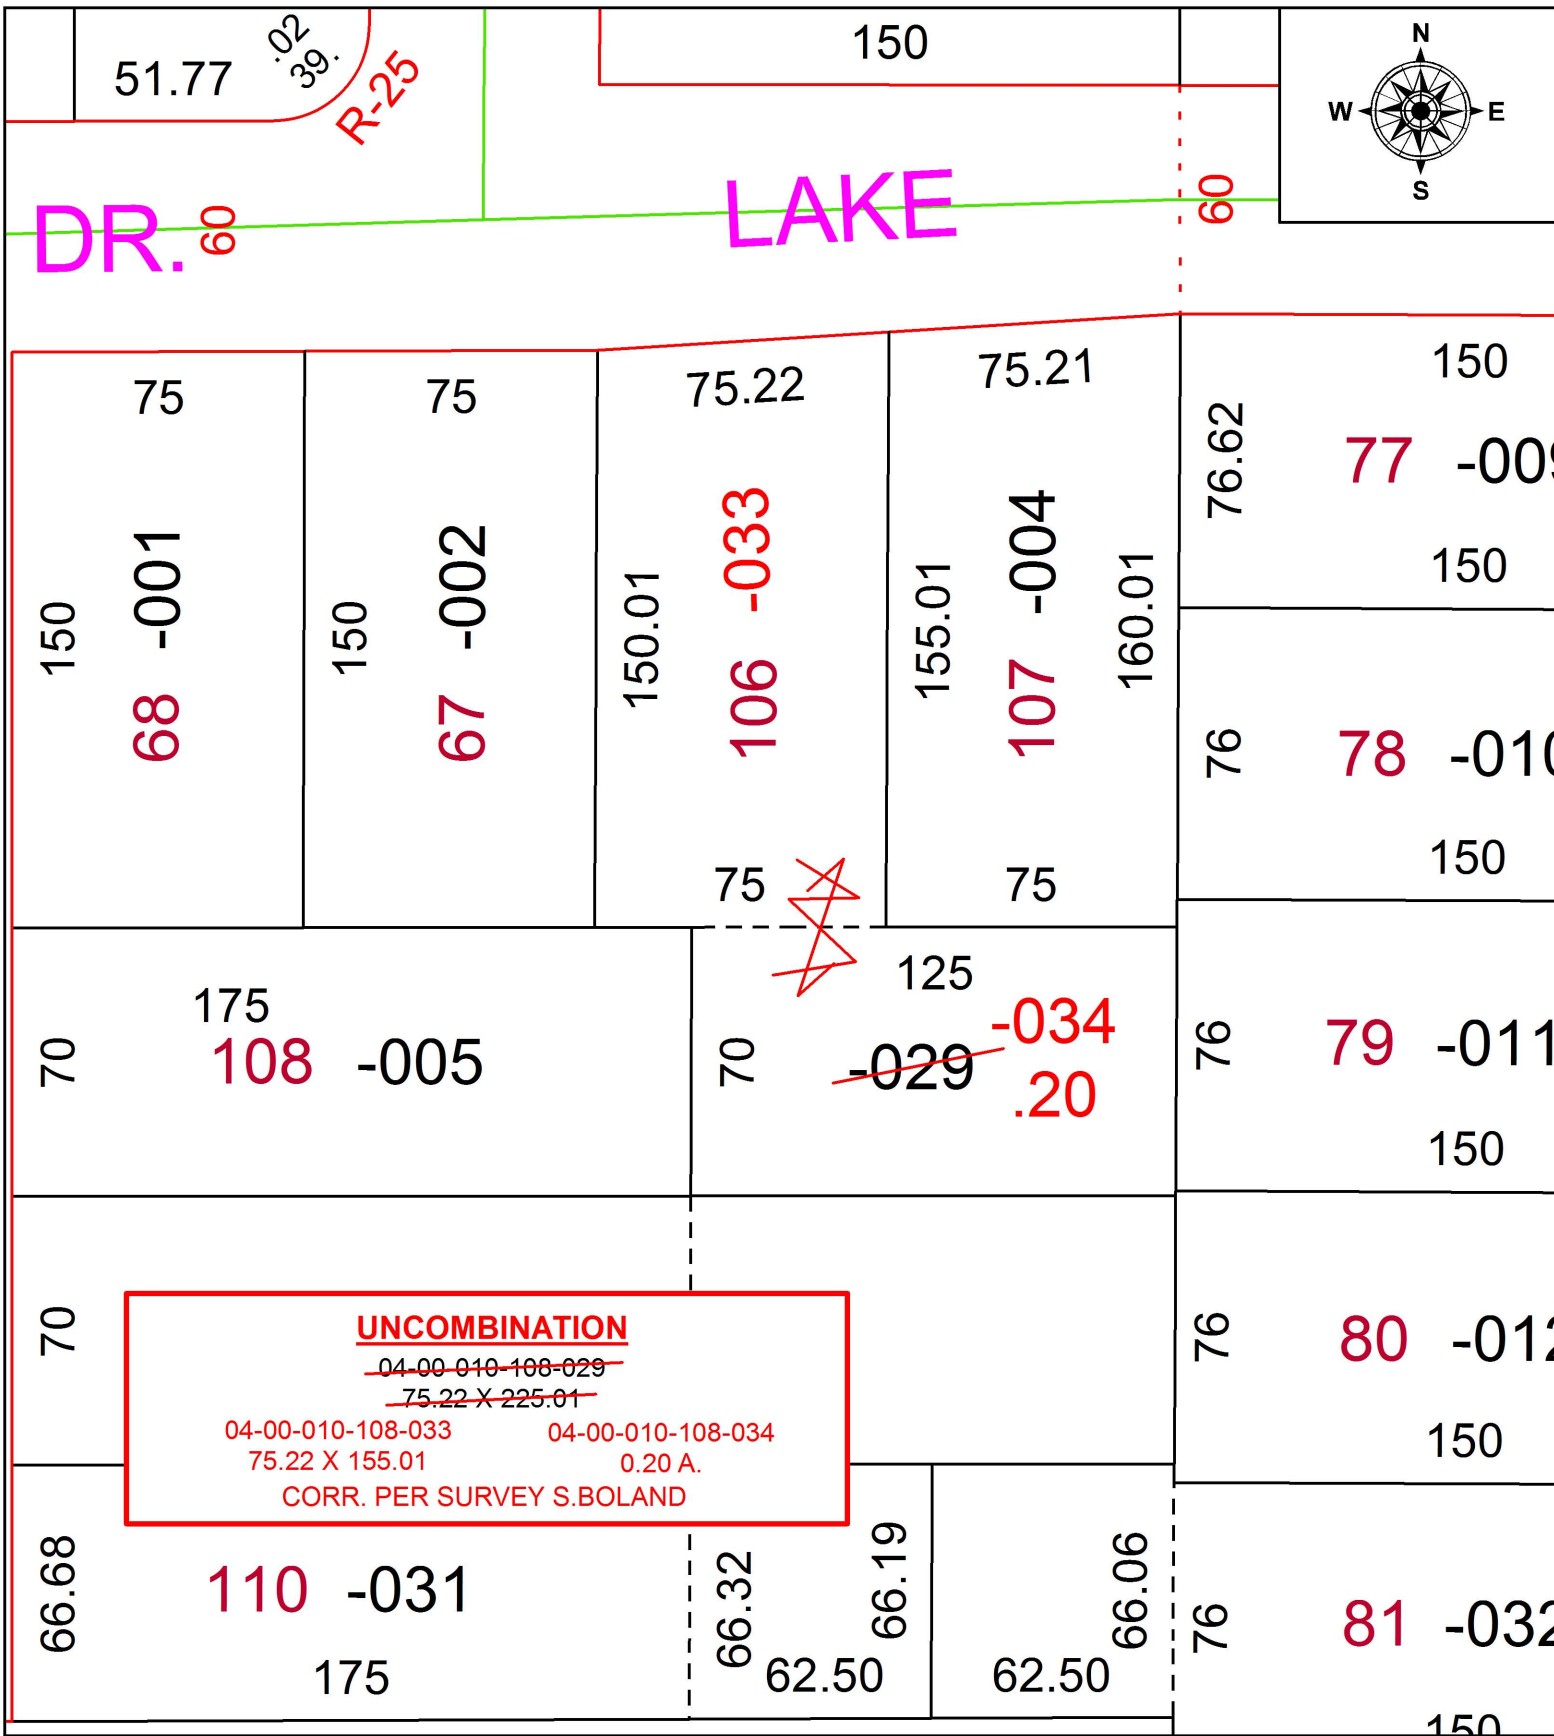

SPLITS/DEEDS PROCESSED
LORAIN COUNTY TAX MAP DEPARTMENT
226 MIDDLE AVE. ELYRIA, OH

SURVEYED BY: SEAN A. BOLAND
CLOSURE: 1: 177,012
MAP PAGE(S): 4-00-010
APPROVED BY: RRM DATE: 7-30-18
SCALE: 1" = 50' PRIOR INSTRUMENT: 20060154019