


PARENT PARCEL: 02-01-001-108-012, -013, -014, -018, -019, -020, 02-01-003-116-169

CHILD PARCEL: 02-01-001-108-021 THRU -026, 02-01-003-116-170

STARTING POINT: INTERSECTION OF C/L OF ARIZONA AVE. AND C/L OF BASCULE DR.

19-03933

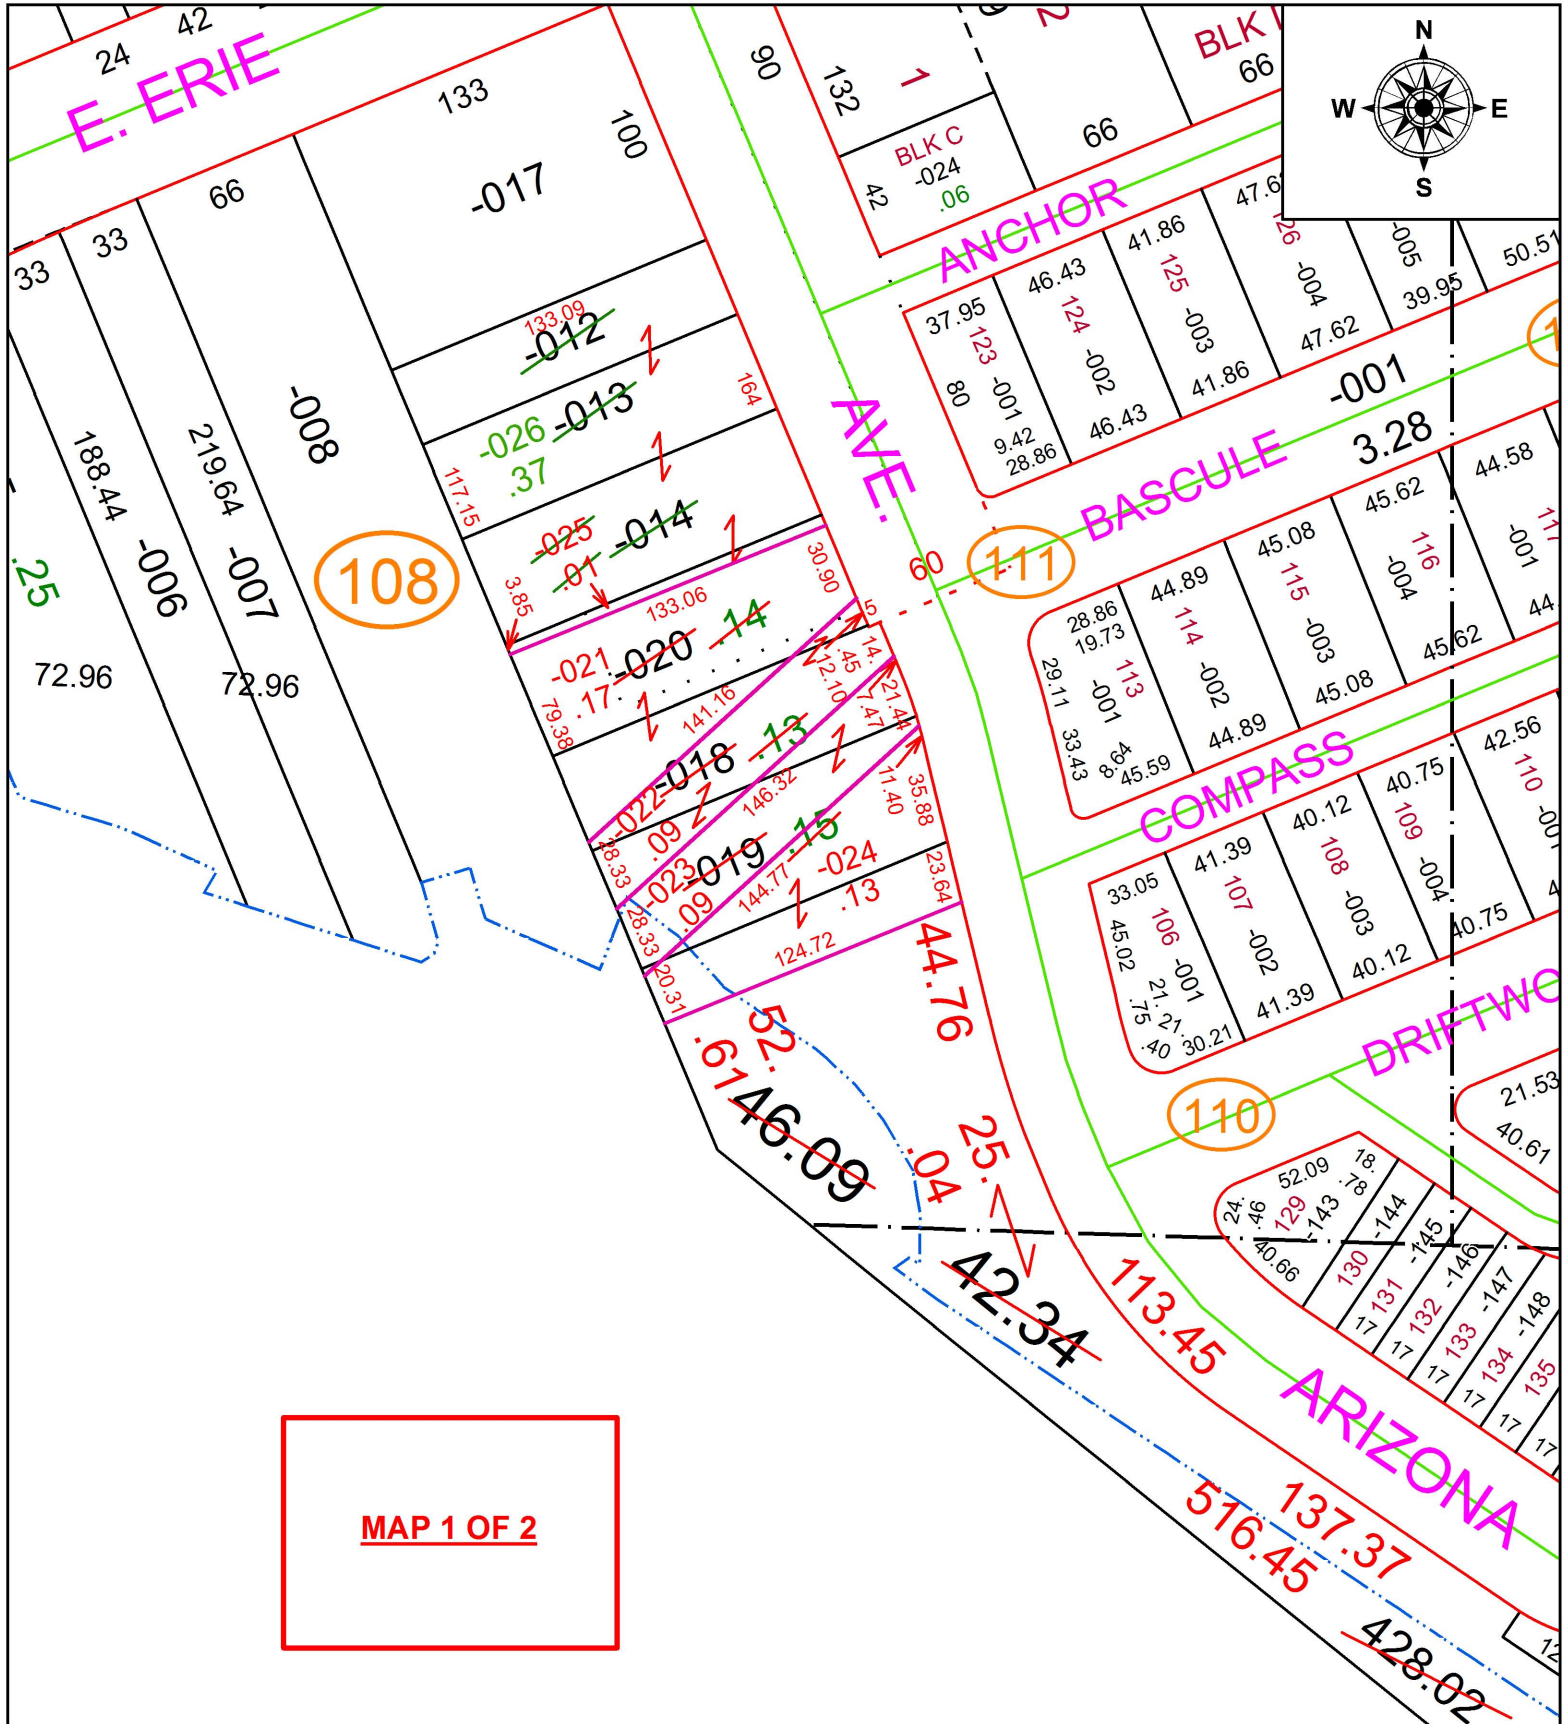

MAP 1 OF 2



SPLITS/DEEDS PROCESSED
 LORAIN COUNTY TAX MAP DEPARTMENT
 226 MIDDLE AVE. ELYRIA, OH

SURVEYED BY: AMY M. KELLY
 CLOSURE: 1:53,380
 MAP PAGE(S): 2-01-001
 APPROVED BY: RRM DATE: 2-8-19
 SCALE: 1" = 75 PRIOR INSTRUMENT: 20100326643