
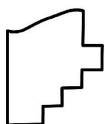


PARENT PARCEL: 11-00-070-000-039, -040

CHILD PARCEL: 11-00-070-000-165

STARTING POINT: INTERSECTION OF C/L OF ACHER RD. AND C/L OF BUTTERNUT RIDGE RD.

19-03951

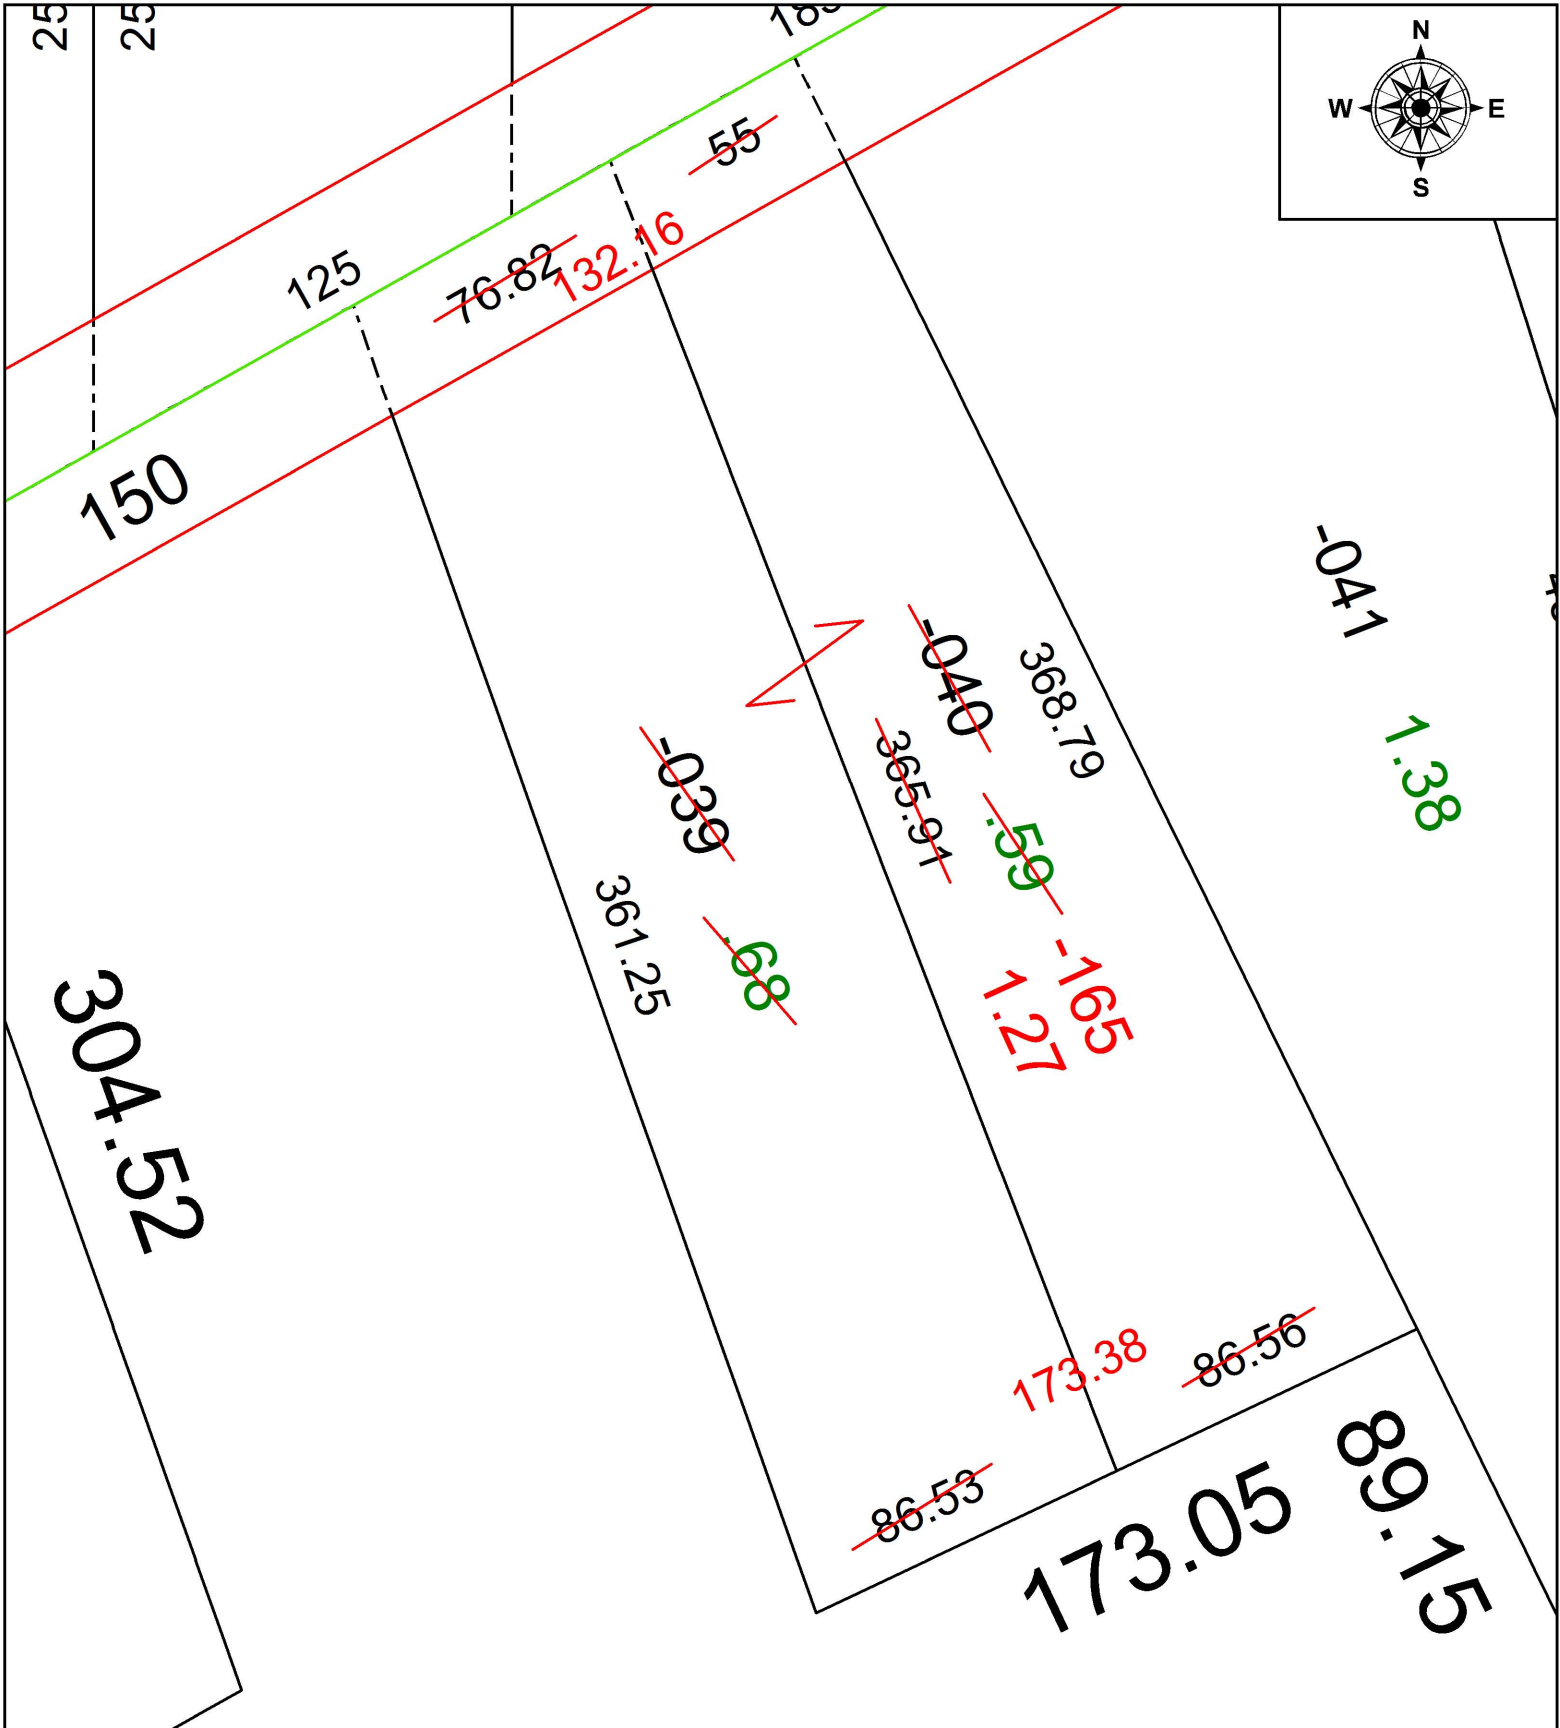

SPLITS/DEEDS PROCESSED
 LORAIN COUNTY TAX MAP DEPARTMENT
 226 MIDDLE AVE. ELYRIA, OH

SURVEYED BY: JOSHUA S. RIEDY
 CLOSURE: 1: 135,881
 MAP PAGE(S): 11-00-070
 APPROVED BY: RRM DATE: 3-26-19
 SCALE: 1" = 50 PRIOR INSTRUMENT: 20180668970