
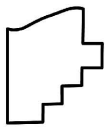


PARENT PARCEL: 04-00-003-103-025, -044

CHILD PARCEL: 04-00-003-103-076 THRU -078

STARTING POINT: INTERSECTION OF C/L OF FRENCH CREEK RD. AND C/L OF N. LONG RD.

19-03954

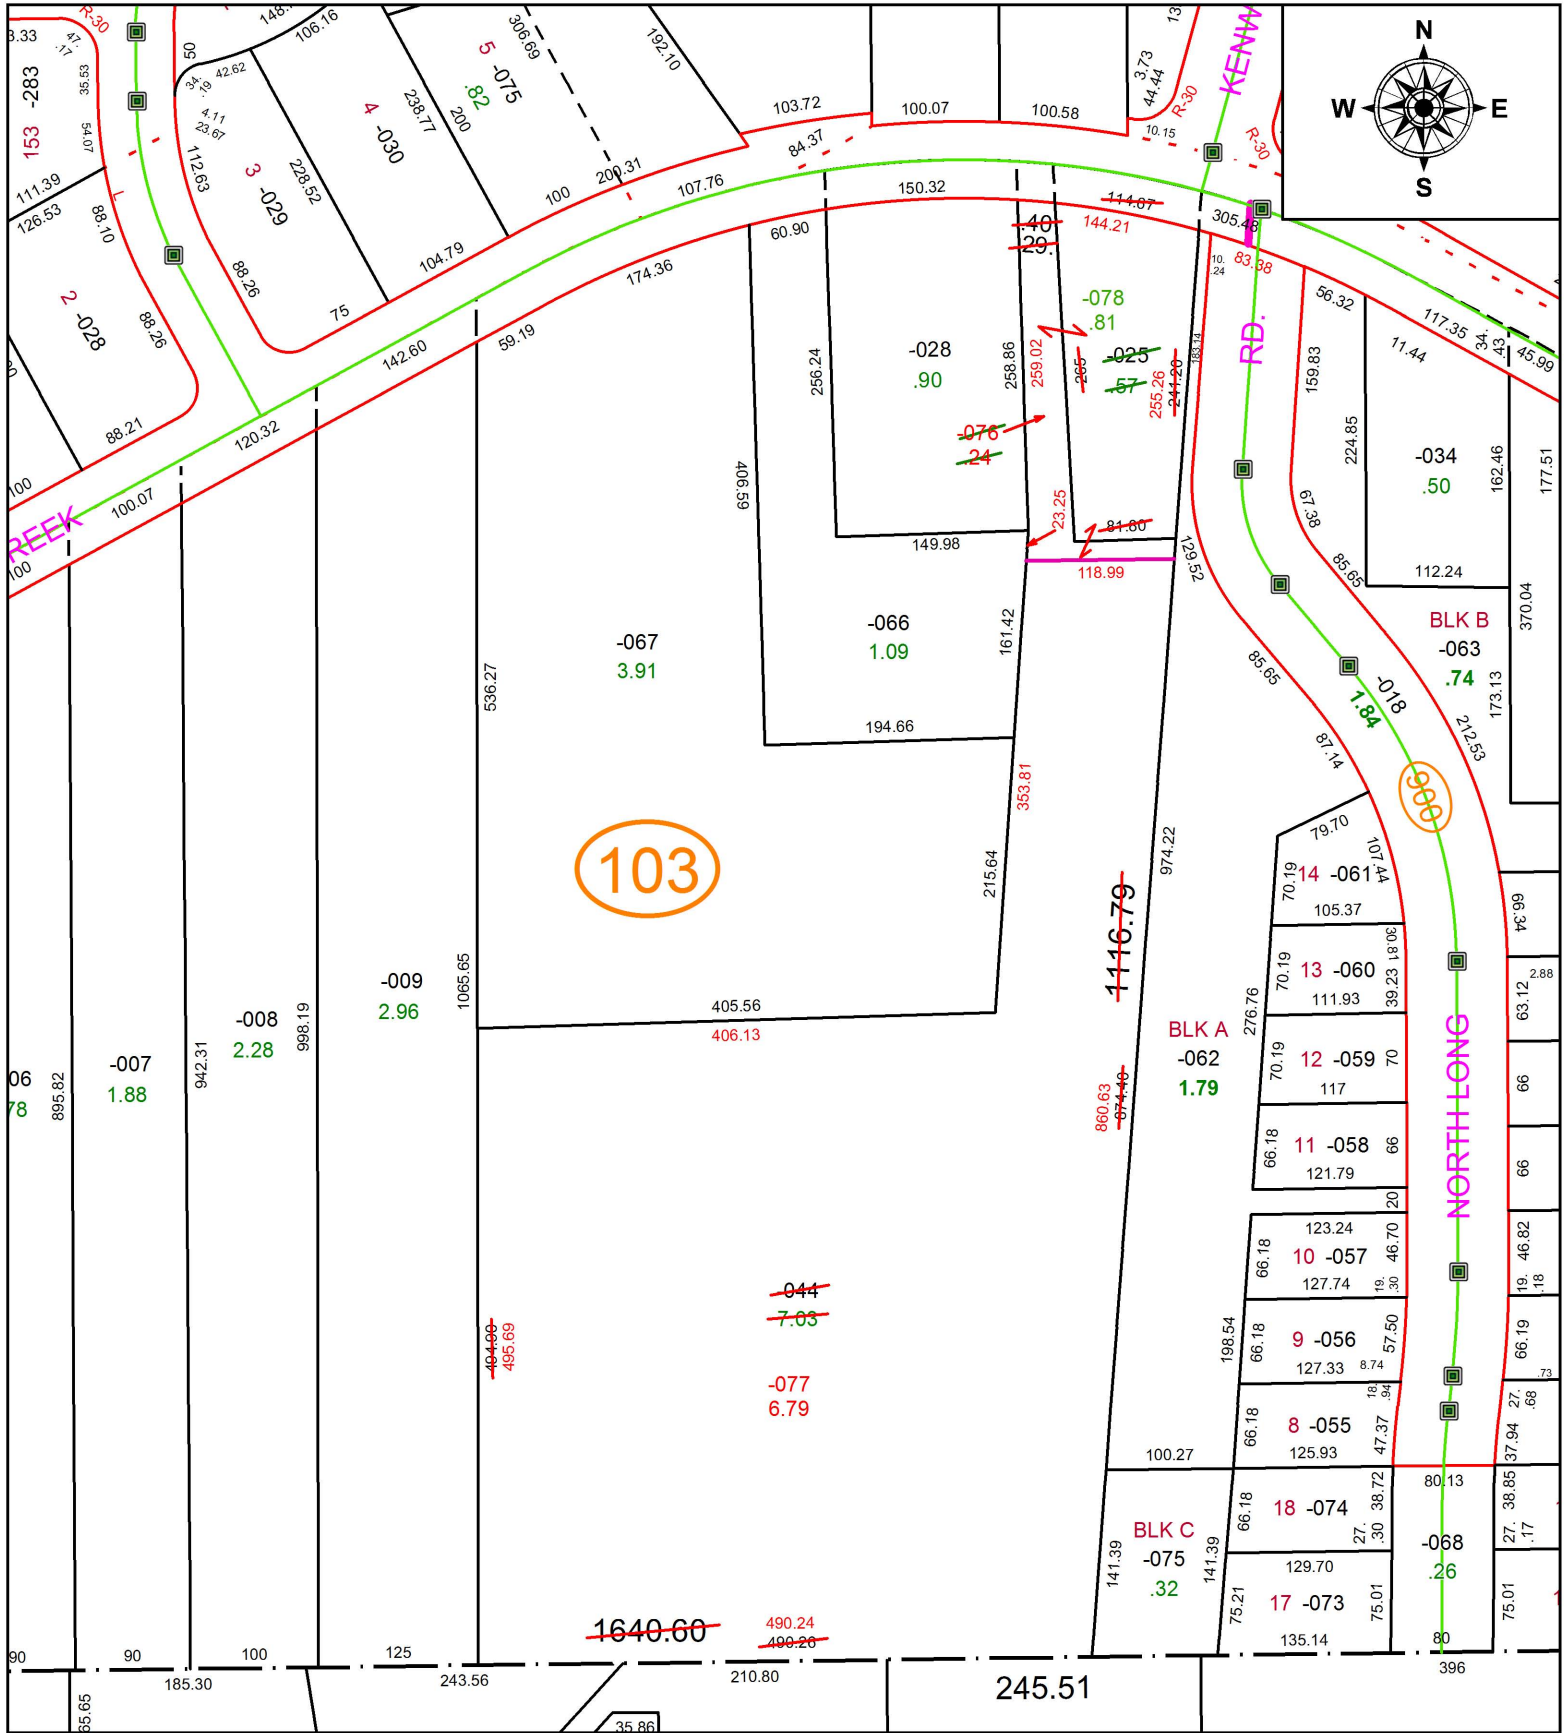

SPLITS/DEEDS PROCESSED
 LORAIN COUNTY TAX MAP DEPARTMENT
 226 MIDDLE AVE. ELYRIA, OH

SURVEYED BY: AMY M. KELLY
 CLOSURE: 1:511,143
 MAP PAGE(S): 4-00-003
 APPROVED BY: RRM DATE: 3-29-19
 SCALE: 1" = 150 PRIOR INSTRUMENT: 20180677236