


PARENT PARCEL: 07-00-033-102-025, 07-00-039-000-084, 07-00-040-000-015, -018

CHILD PARCEL: 07-00-033-102-025, 07-00-039-000-084, 07-00-040-000-151

STARTING POINT: NORTHEAST CORNER OF O.L.40

19-03956

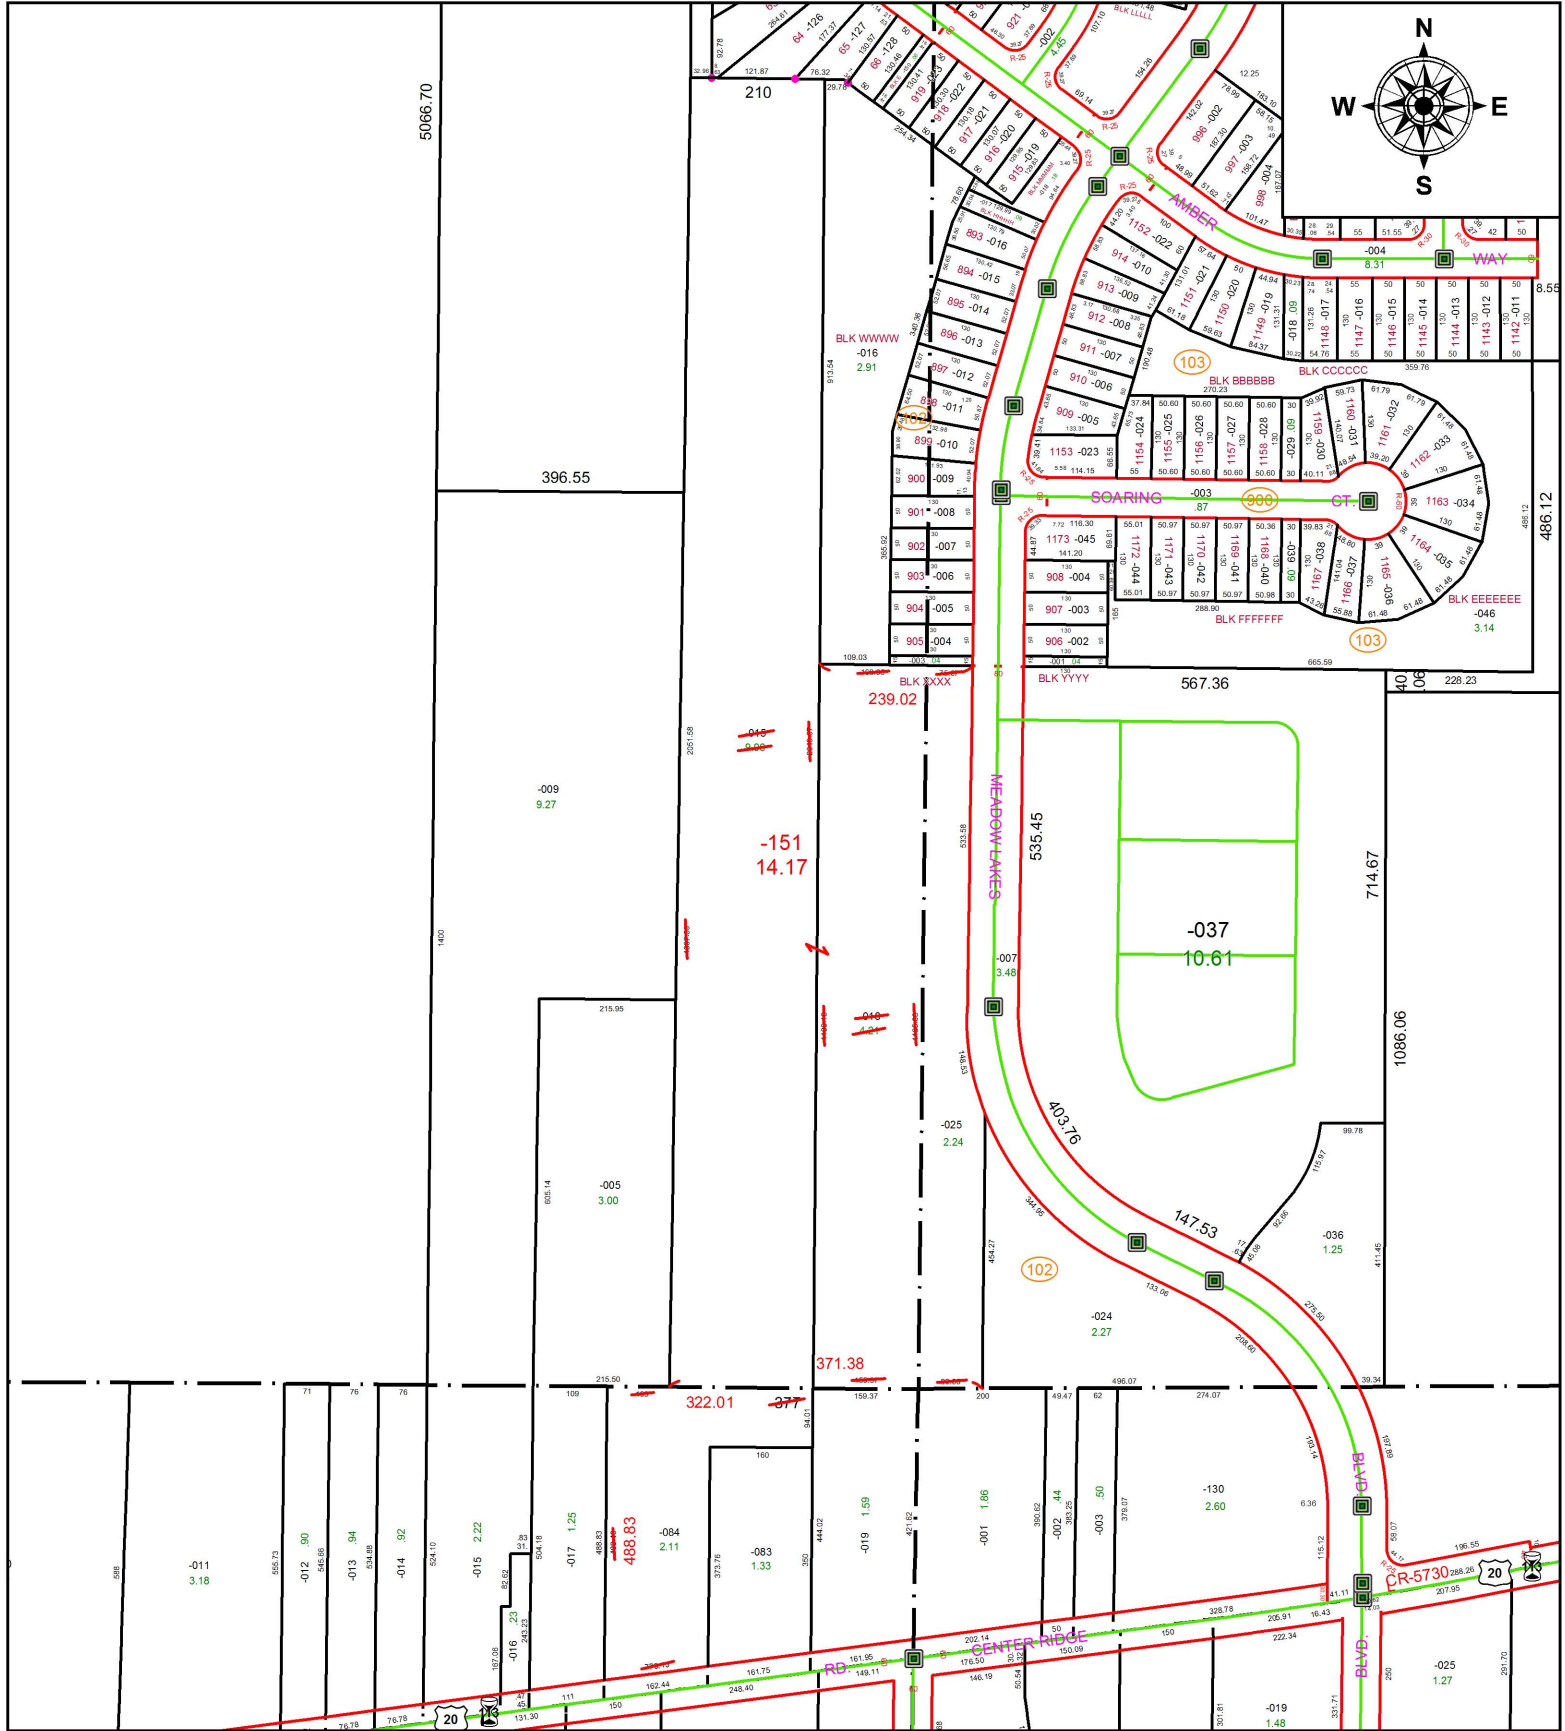

SPLITS/DEEDS PROCESSED
 LORAIN COUNTY TAX MAP DEPARTMENT
 226 MIDDLE AVE. ELYRIA, OH

SURVEYED BY: AMY M. KELLY
 CLOSURE: 1:270,883
 MAP PAGE(S): 7-00-040
 APPROVED BY: RRM DATE: 4-12-19
 SCALE: 1" = 300 PRIOR INSTRUMENT: 20140508347