



PARENT PARCEL: 10-00-006-125-007
CHILD PARCEL: DROP FROM DUP.
STARTING POINT:

18-03960-C

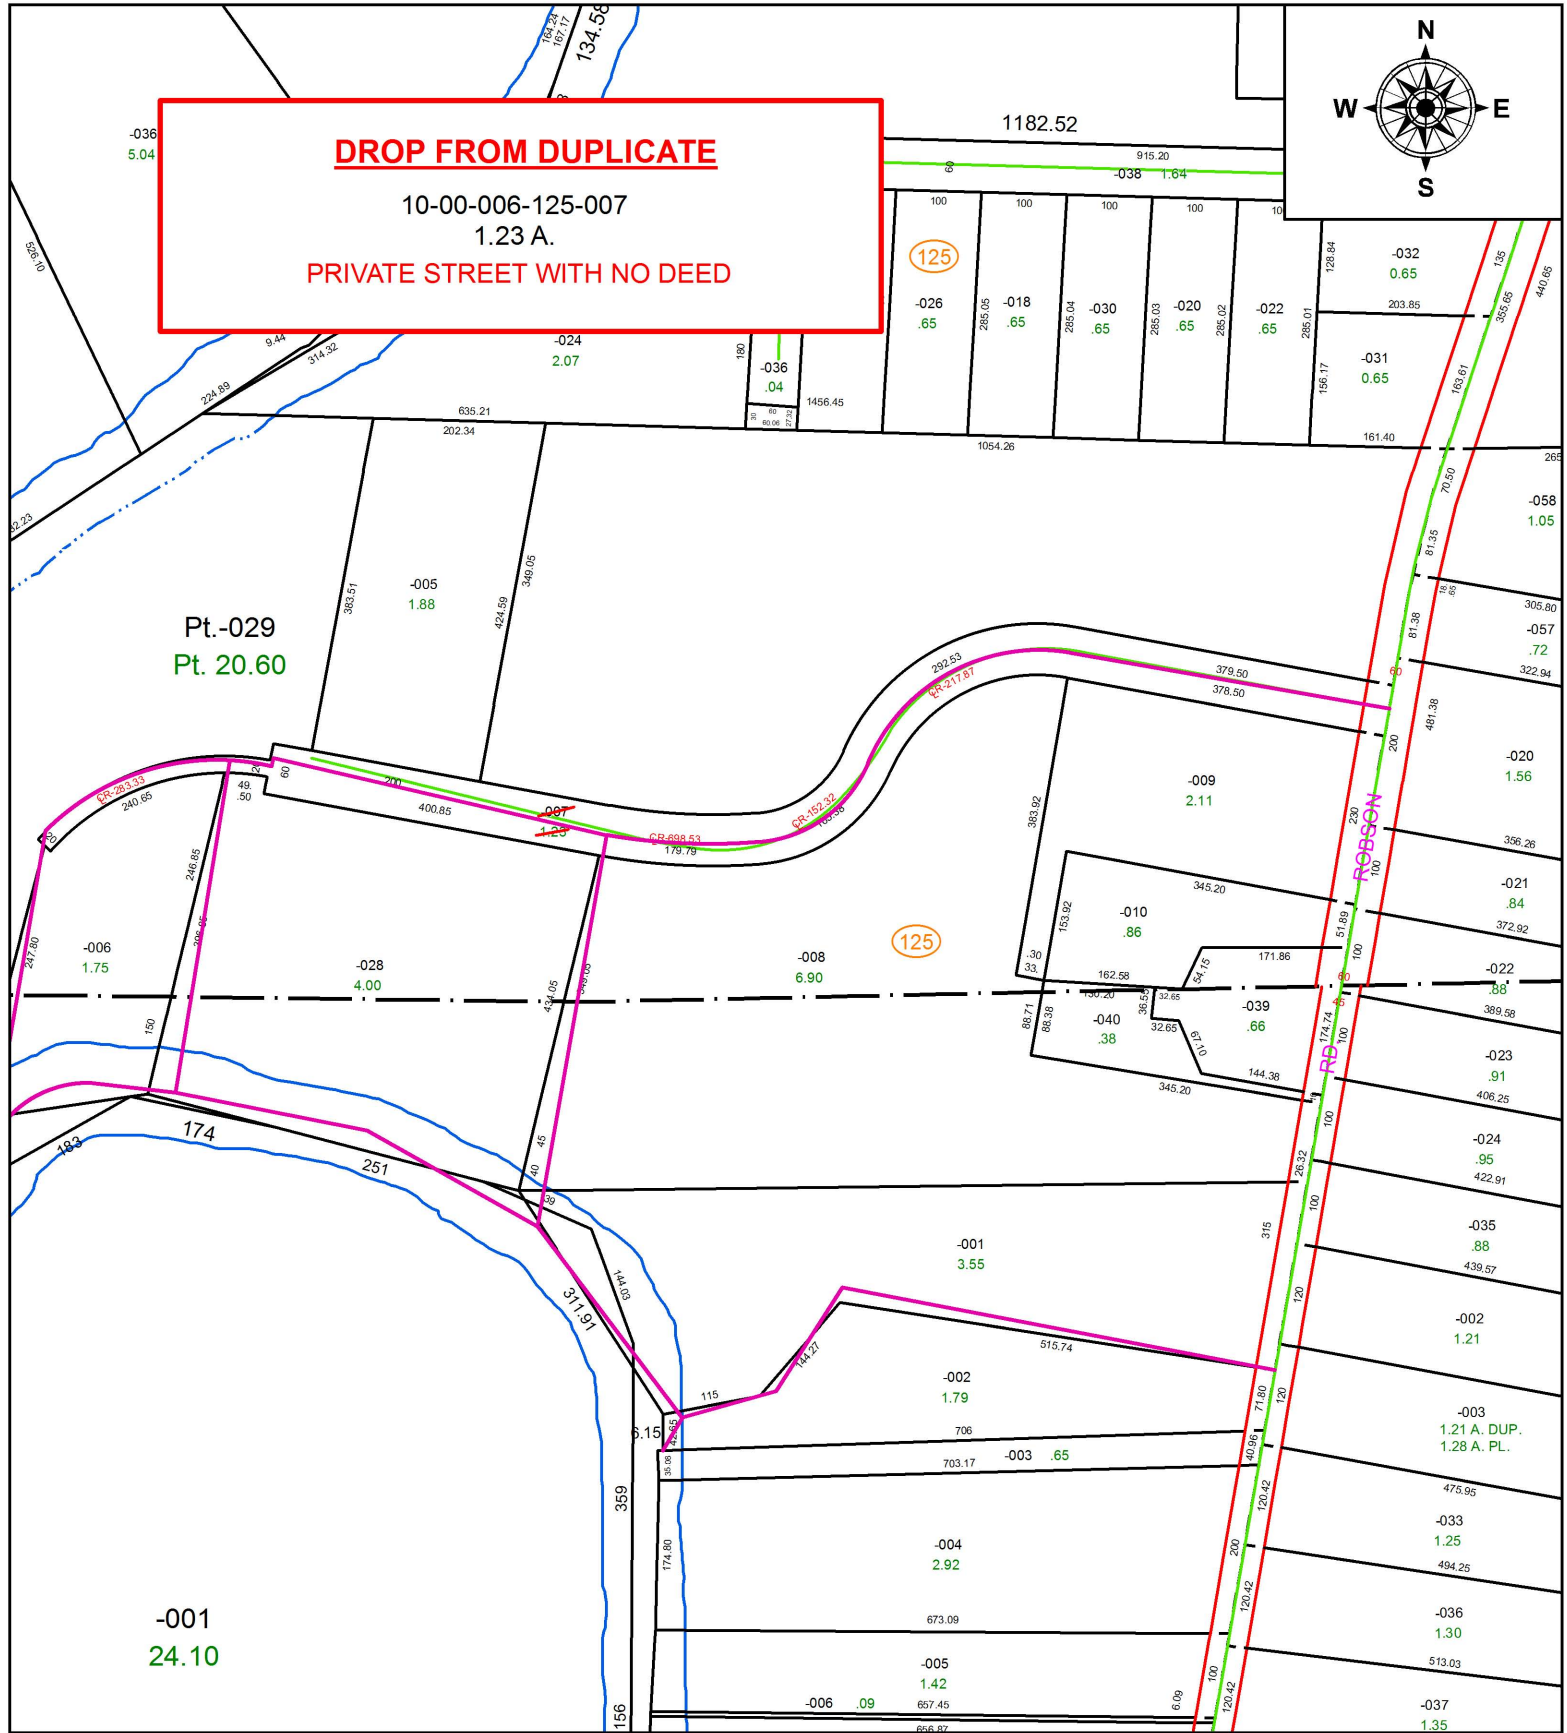


DROP FROM DUPLICATE
10-00-006-125-007
1.23 A.
PRIVATE STREET WITH NO DEED

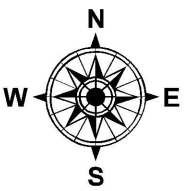

Pt.-029
Pt. 20.60

-001
24.10

-003
1.21 A. DUP.
1.28 A. PL.

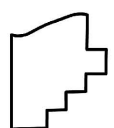

SPLITS/DEEDS PROCESSED
LORAIN COUNTY TAX MAP DEPARTMENT
226 MIDDLE AVE. ELYRIA, OH

SURVEYED BY: _____ N/A
CLOSURE: _____ N/A
MAP PAGE(S): 10-00-006
APPROVED BY: RRM DATE: 9-27-18
SCALE: 1" = 225 PRIOR INSTRUMENT: _____ N/A