
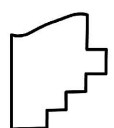
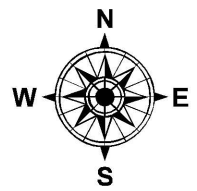


PARENT PARCEL: 04-00-023-105-020

CHILD PARCEL: 04-00-023-105-293 THRU -296

STARTING POINT: INTERSECTION OF C/L OF JAYCOX RD. AND C/L OF SCHWARTZ RD.

19-03960

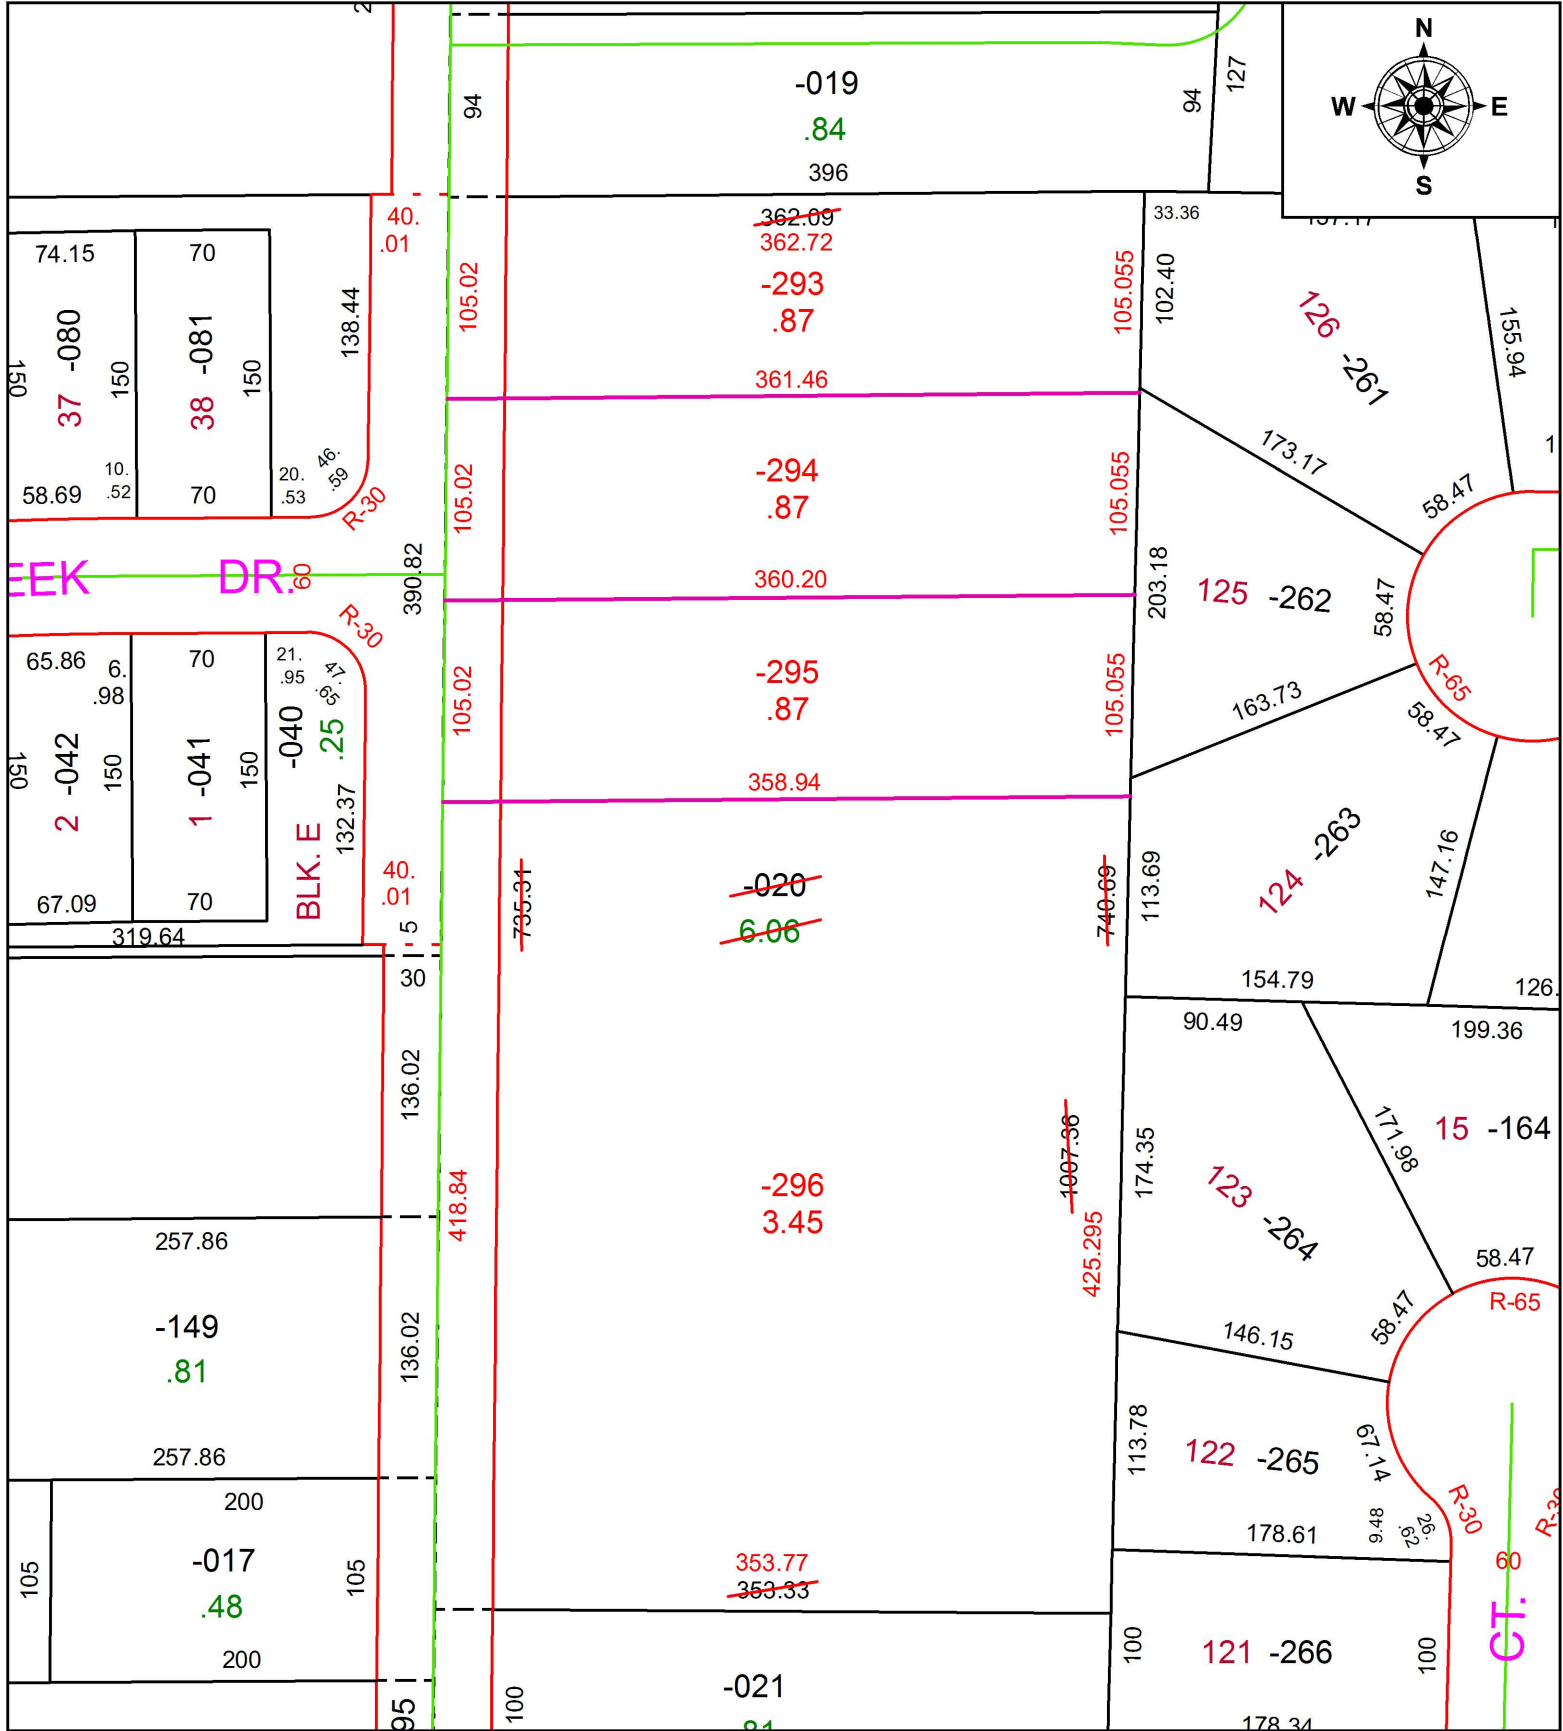

**SPLITS/DEEDS PROCESSED**  
 LORAIN COUNTY TAX MAP DEPARTMENT  
 226 MIDDLE AVE. ELYRIA, OH

SURVEYED BY: MICHAEL P. SPELLACY  
 CLOSURE: 1:141,526  
 MAP PAGE(S): 4-00-023  
 APPROVED BY: RRM DATE: 4-25-19  
 SCALE: 1" = 100 PRIOR INSTRUMENT: 20030972751