
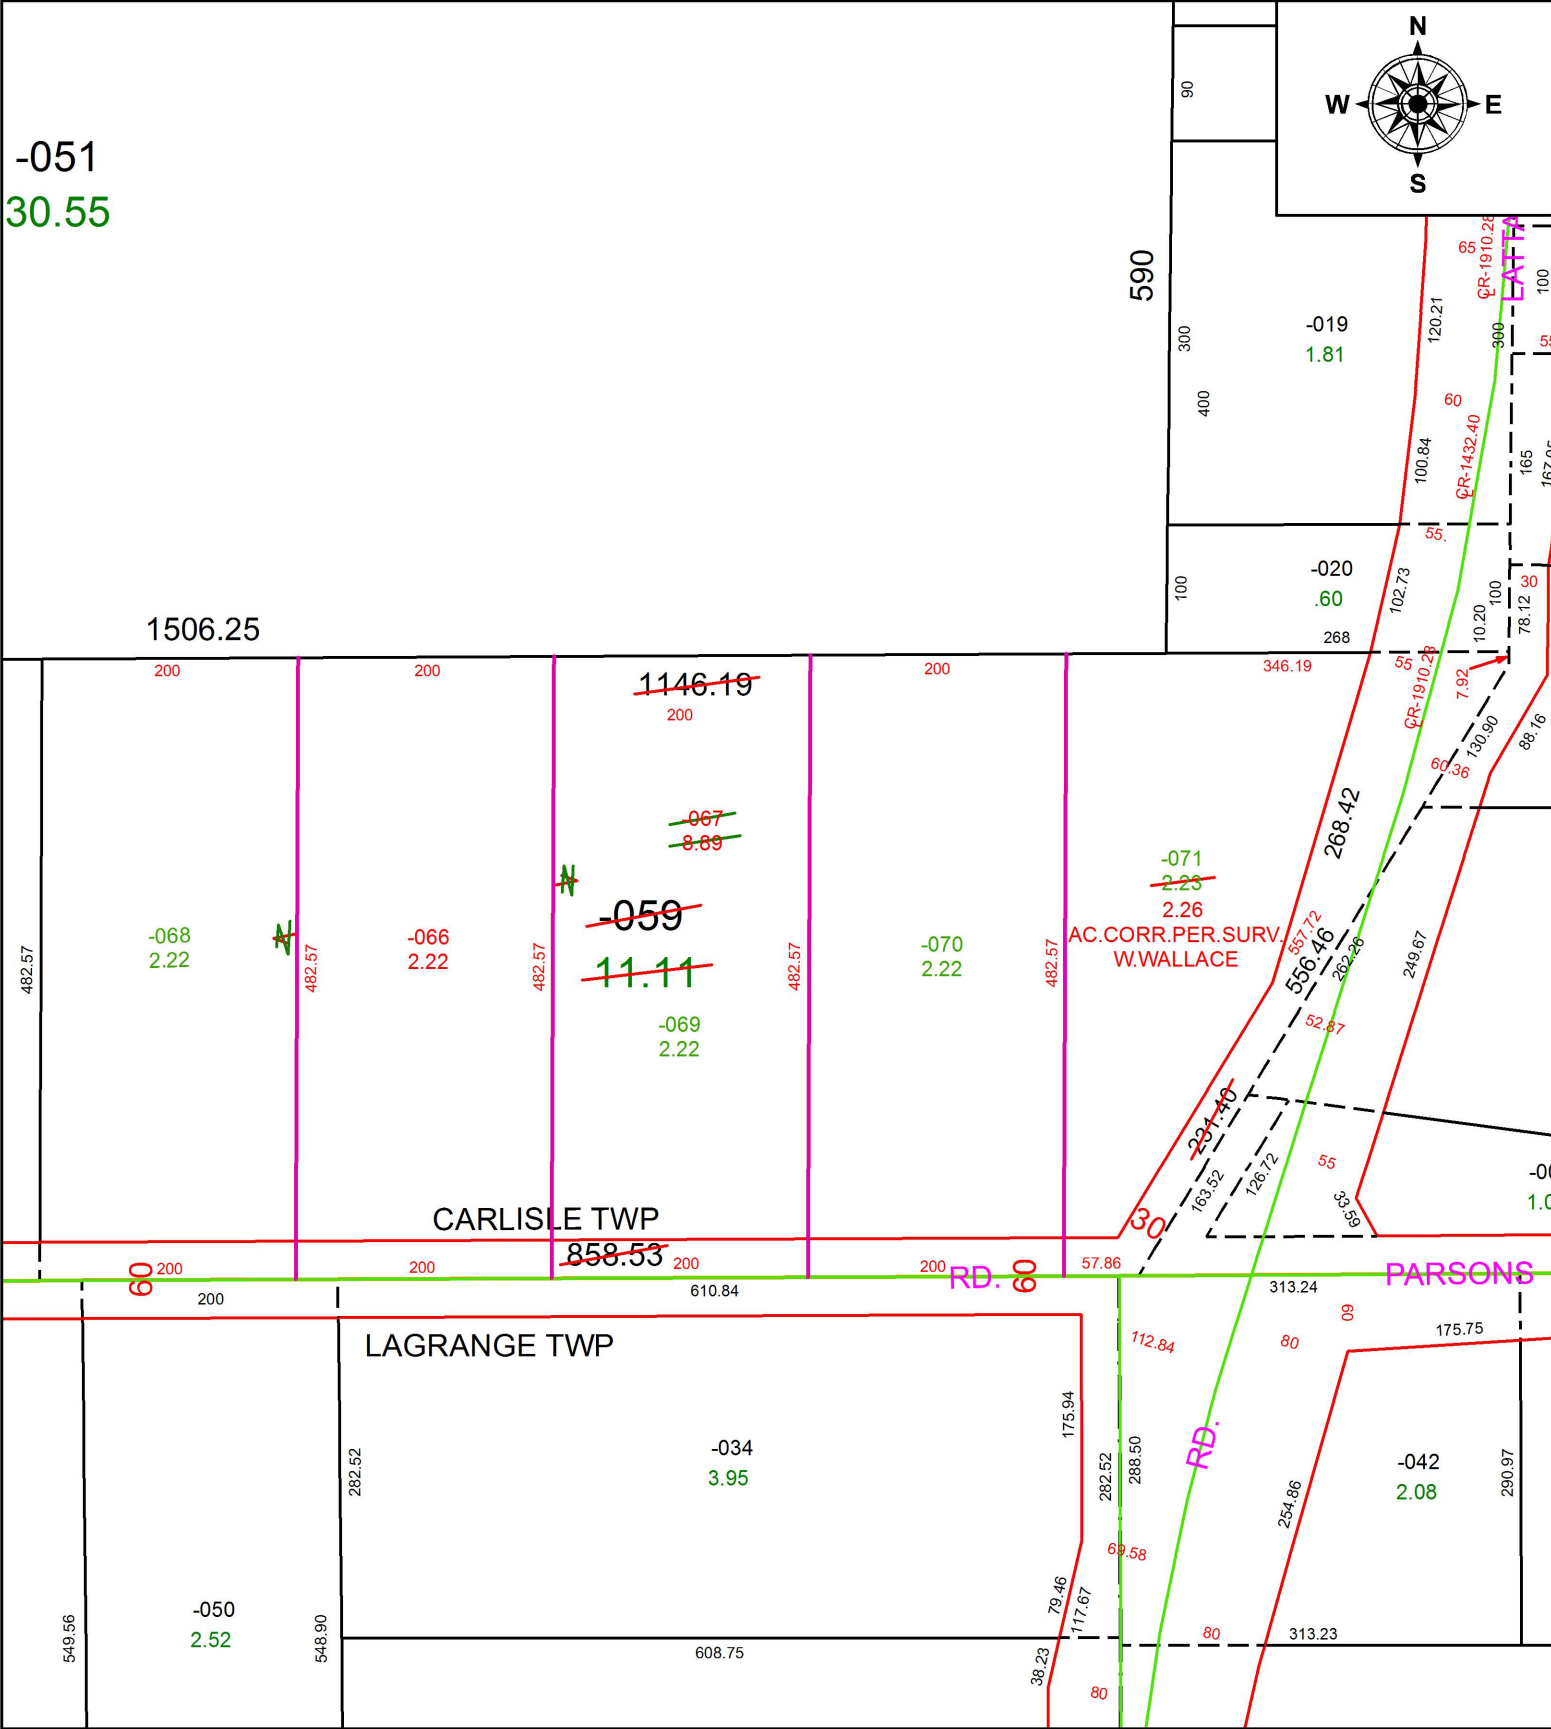


PARENT PARCEL: 10-00-023-101-059
 CHILD PARCEL: 10-00-023-101-066 THRU -071
 STARTING POINT: SOUTHWEST CORNER OF SEC. 23

19-03965

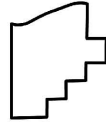

 **SPLITS/DEEDS PROCESSED**
 LORAIN COUNTY TAX MAP DEPARTMENT
 226 MIDDLE AVE. ELYRIA, OH

SURVEYED BY: WILLIAM R. WALLACE
 CLOSURE: 1: 556,068
 MAP PAGE(S): 10-00-023
 APPROVED BY: RRM DATE: 5-7-19
 SCALE: 1" = 150 PRIOR INSTRUMENT: 20160586284