


PARENT PARCEL: 07-00-009-120-211

CHILD PARCEL: 07-00-009-120-234, -235

STARTING POINT: INTERSECTION OF C/L OF BROWNING DR. AND C/L OF MILLER DR.

19-03968

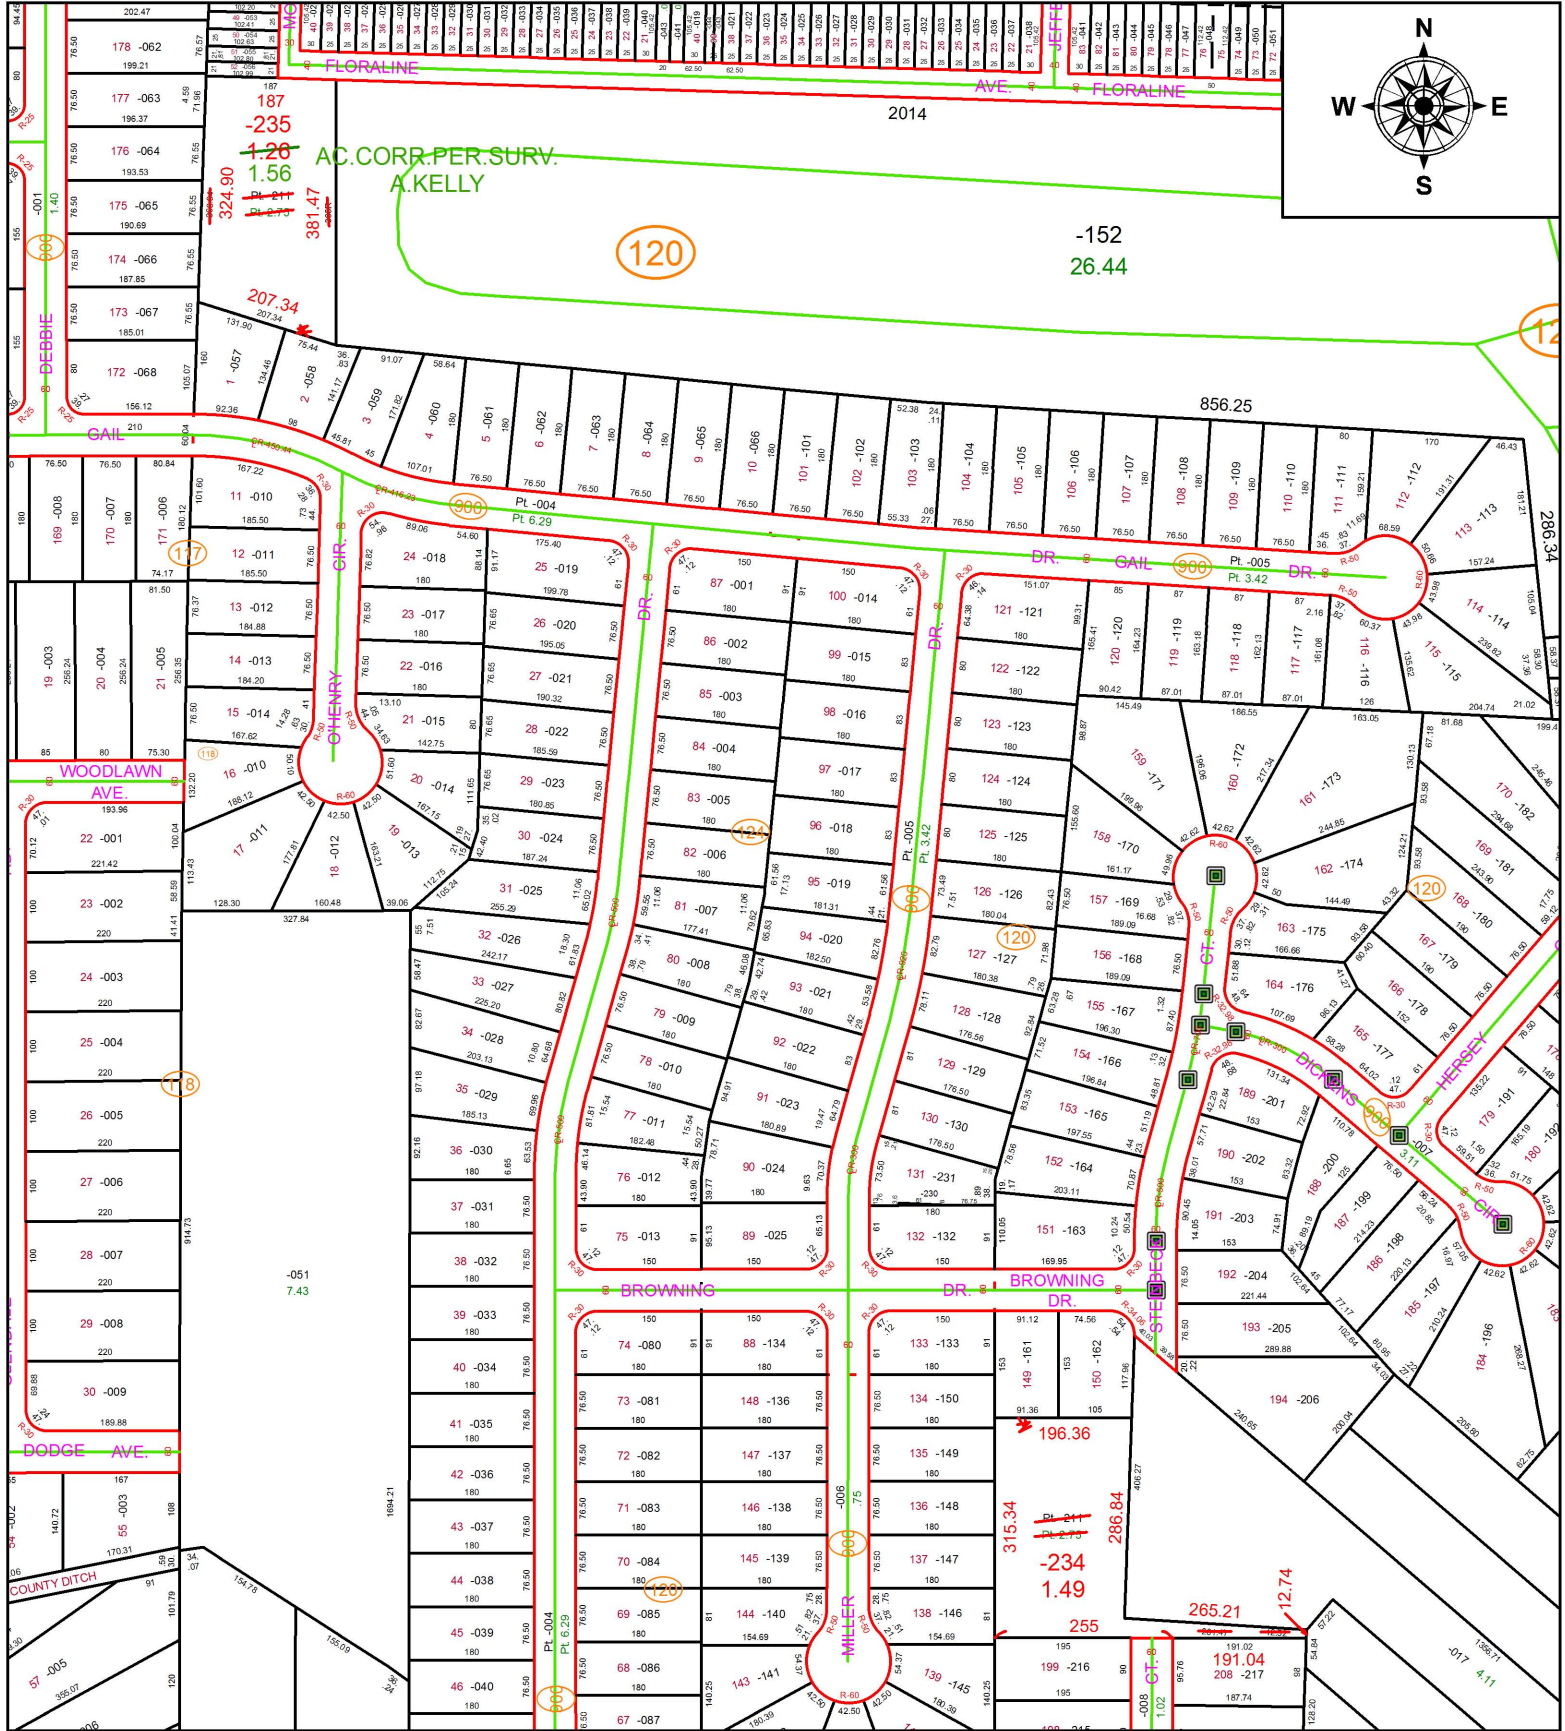

**SPLITS/DEEDS PROCESSED**

LORAIN COUNTY TAX MAP DEPARTMENT  
226 MIDDLE AVE. ELYRIA, OH

SURVEYED BY: AMY M. KELLY

CLOSURE: 1: 213,656

MAP PAGE(S): 7-00-009

APPROVED BY: RRM DATE: 5-8-19

SCALE: 1" = 275 PRIOR INSTRUMENT: OR 827/771