


PARENT PARCEL: 21-04-000-000-046

CHILD PARCEL:

STARTING POINT: INTERSECTION OF C/L OF CLARK RD. AND NORTH LINE OF TRACT 4

18-03969-A

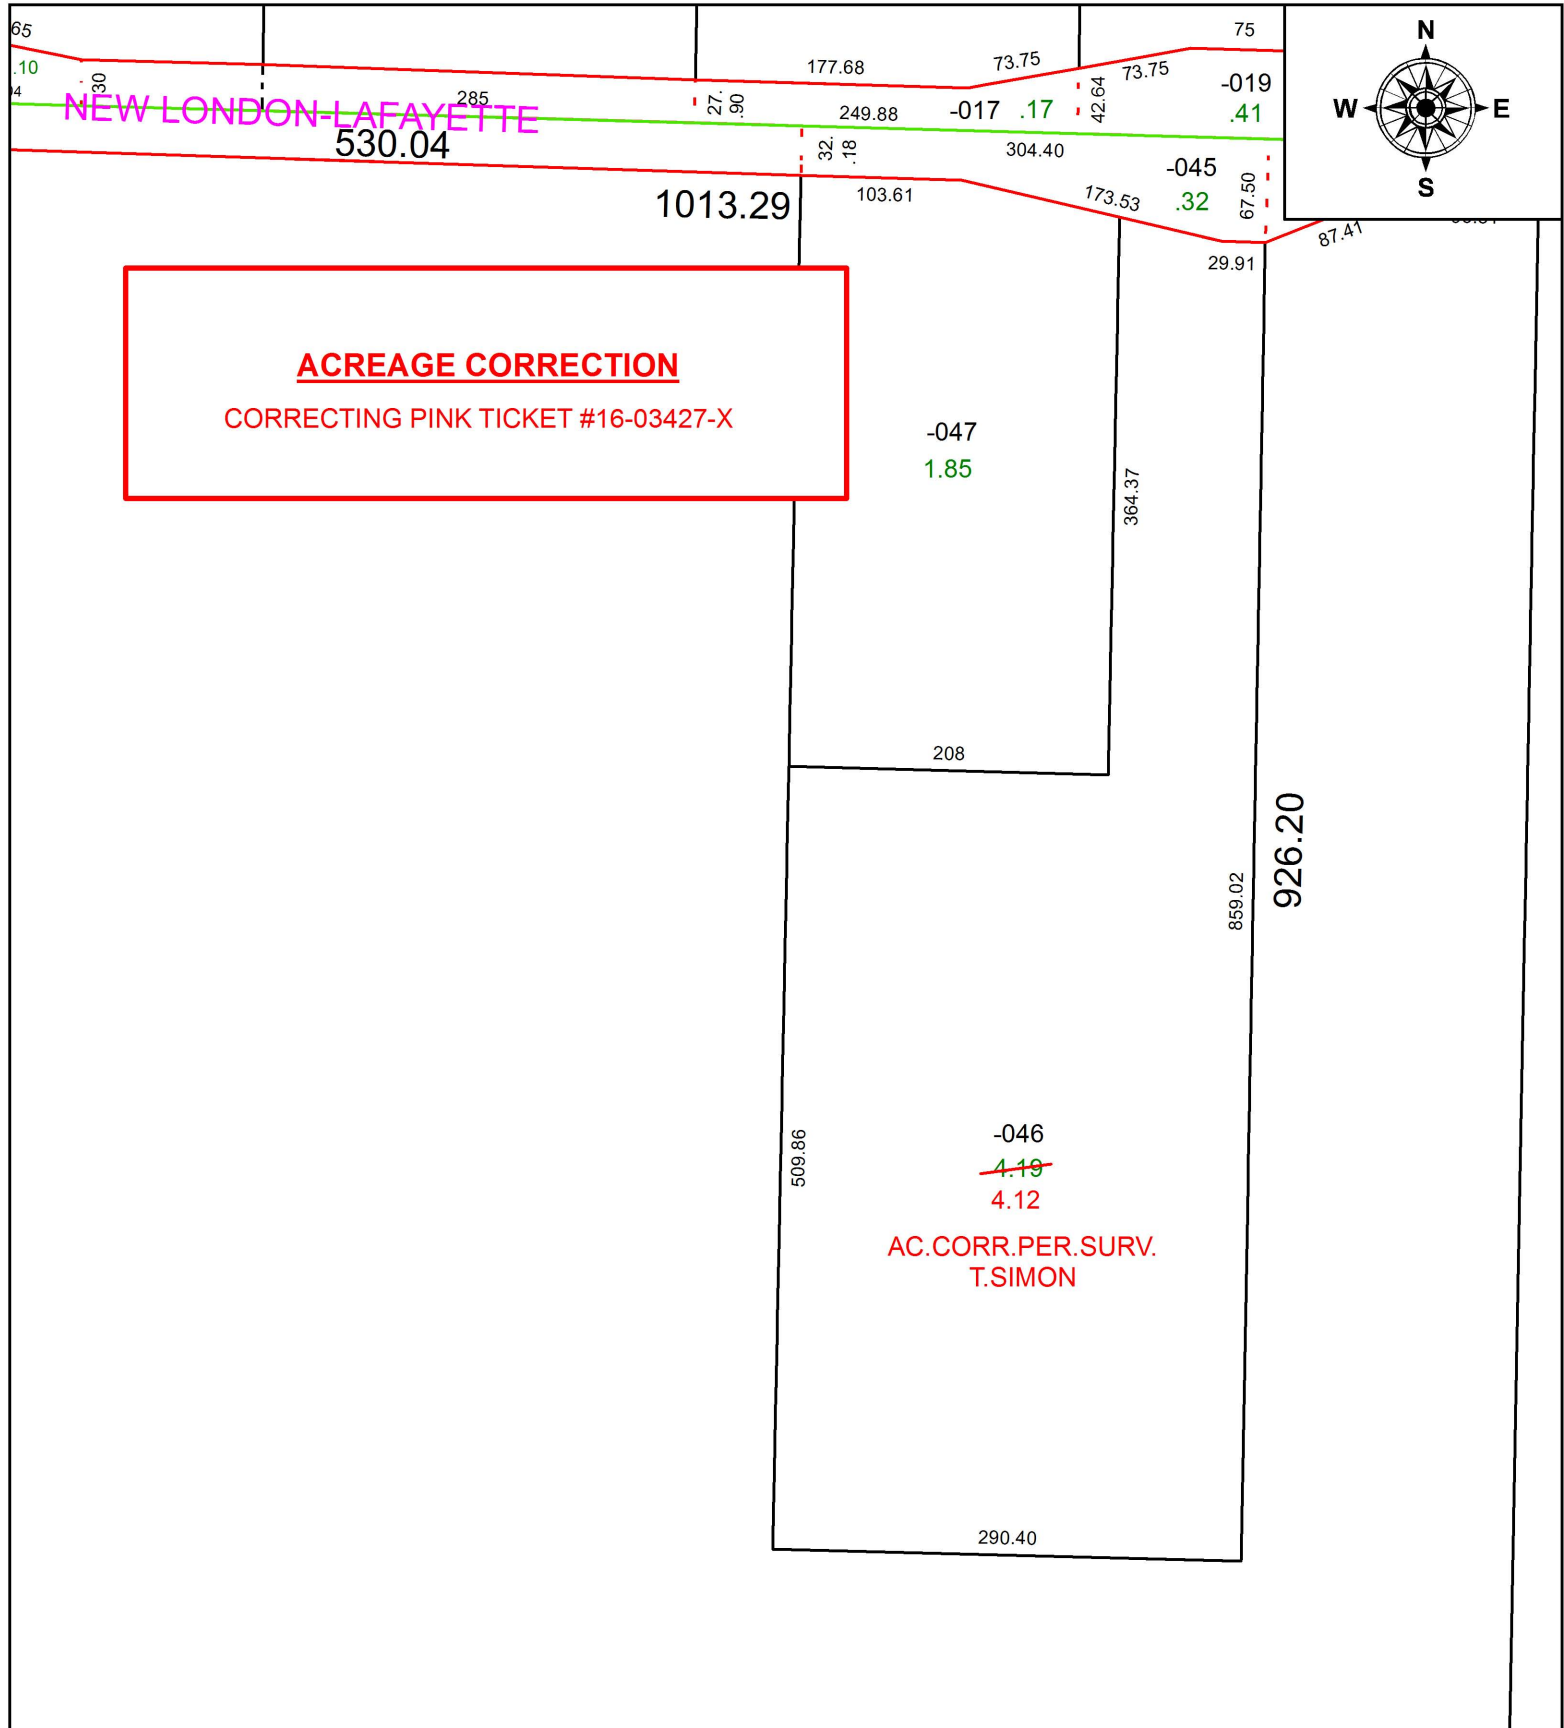

SPLITS/DEEDS PROCESSED
LORAIN COUNTY TAX MAP DEPARTMENT
226 MIDDLE AVE. ELYRIA, OH

SURVEYED BY: THOMAS A. SIMON

CLOSURE: 1: 261,477

MAP PAGE(S): 21-F

APPROVED BY: RRM DATE: 10-17-18

SCALE: 1" = 125 PRIOR INSTRUMENT: 20140508324