
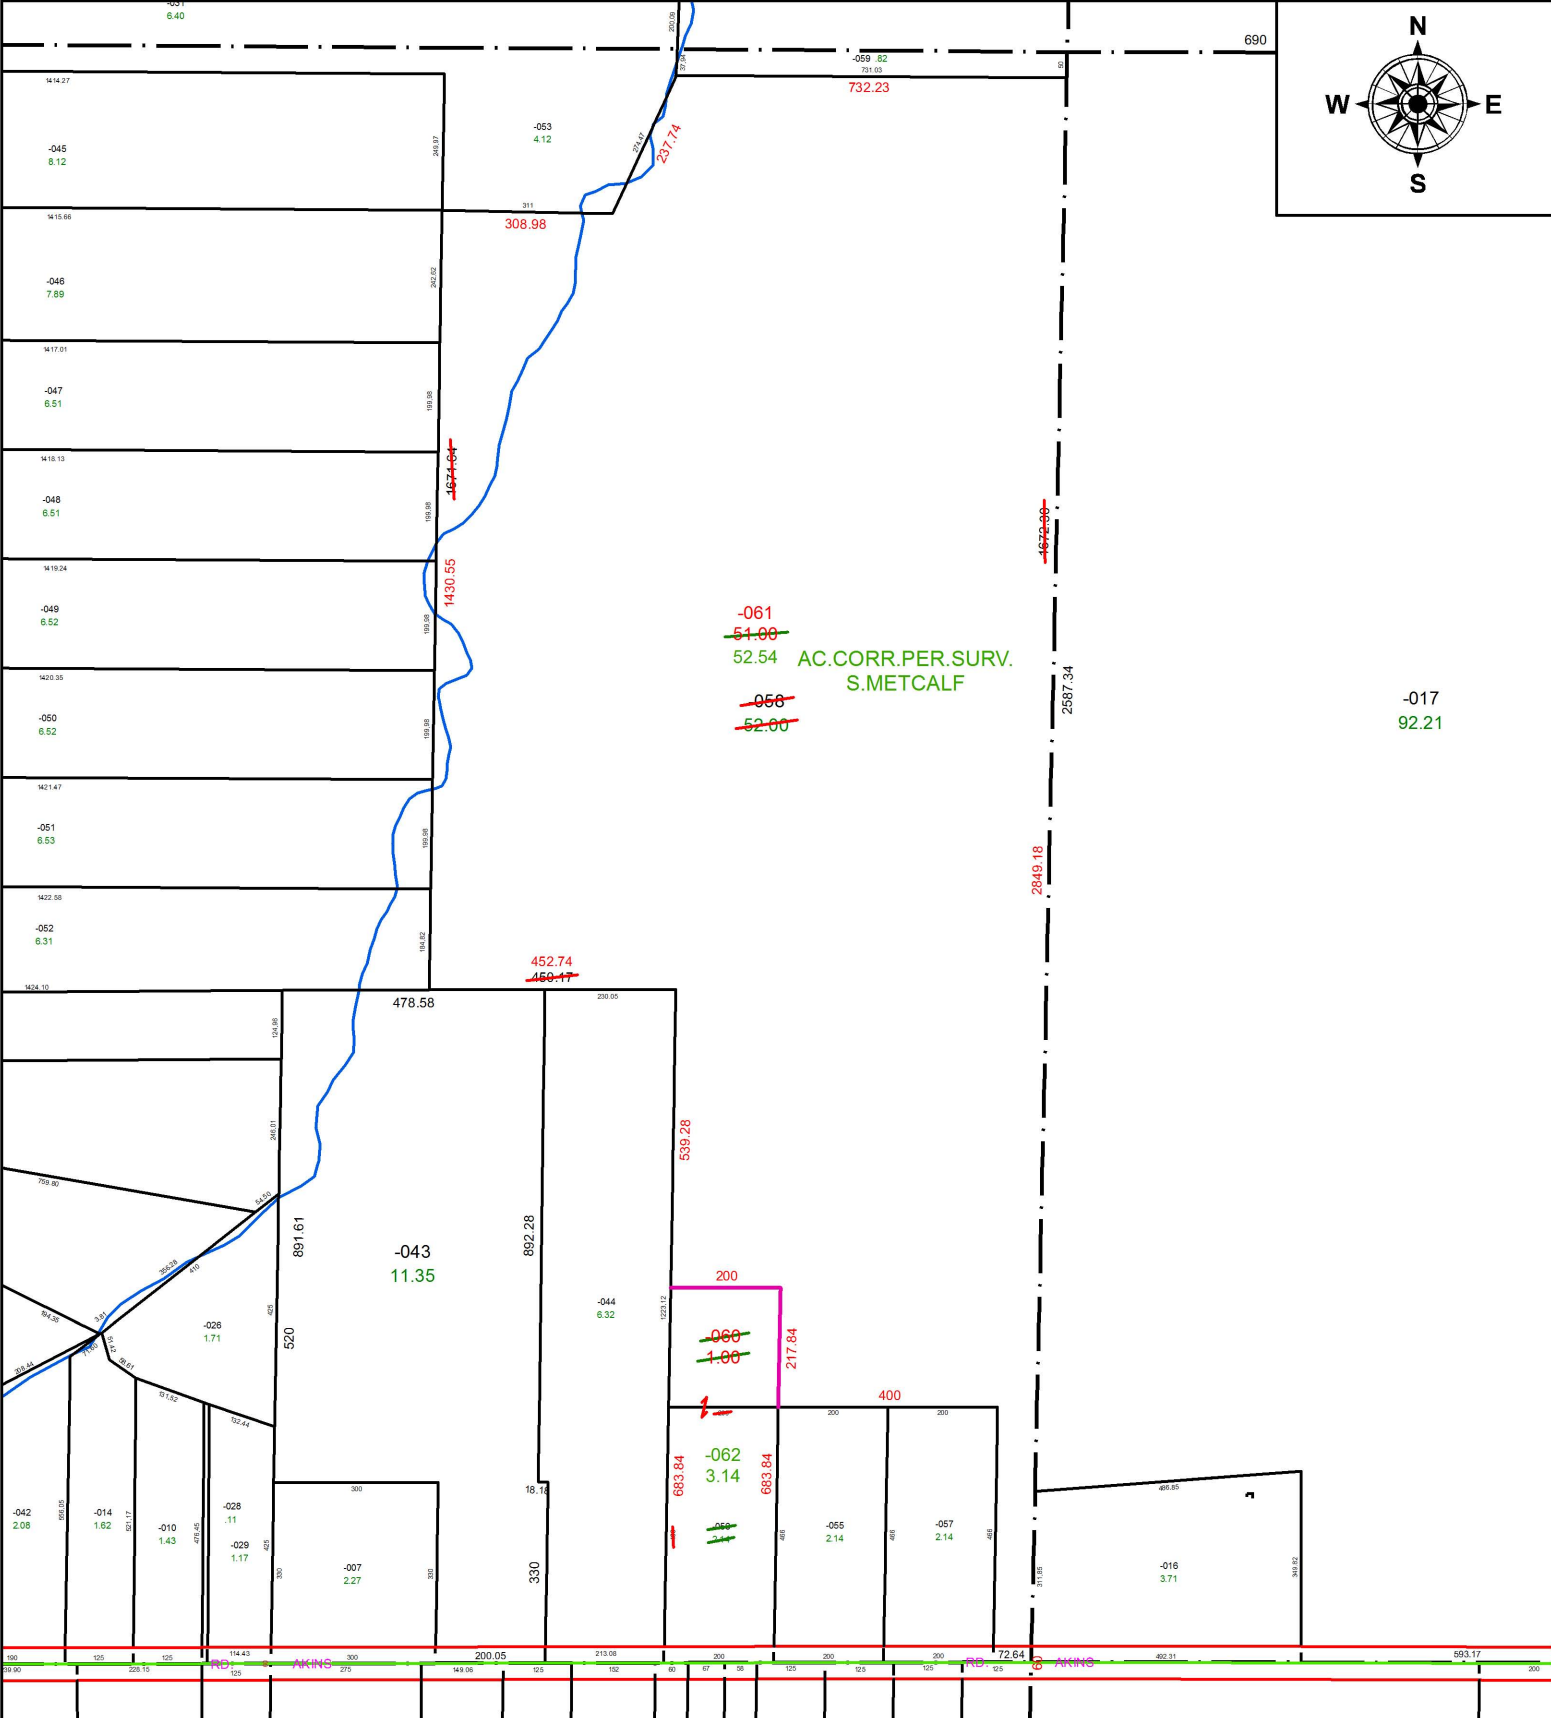


PARENT PARCEL: 12-00-073-000-056, -058
 CHILD PARCEL: 12-00-073-000-060 THRU -062
 STARTING POINT: SOUTHEAST CORNER OF O.L.73

19-03970

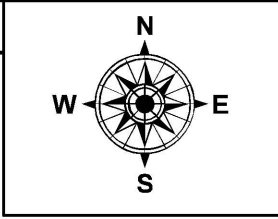

SPLITS/DEEDS PROCESSED
 LORAIN COUNTY TAX MAP DEPARTMENT
 226 MIDDLE AVE. ELYRIA, OH

SURVEYED BY: STEVEN J. METCALF
 CLOSURE: 1:2,302,222
 MAP PAGE(S): 12-00-073
 APPROVED BY: RRM DATE: 5-13-19
 SCALE: 1" = 350 PRIOR INSTRUMENT: 20160573889